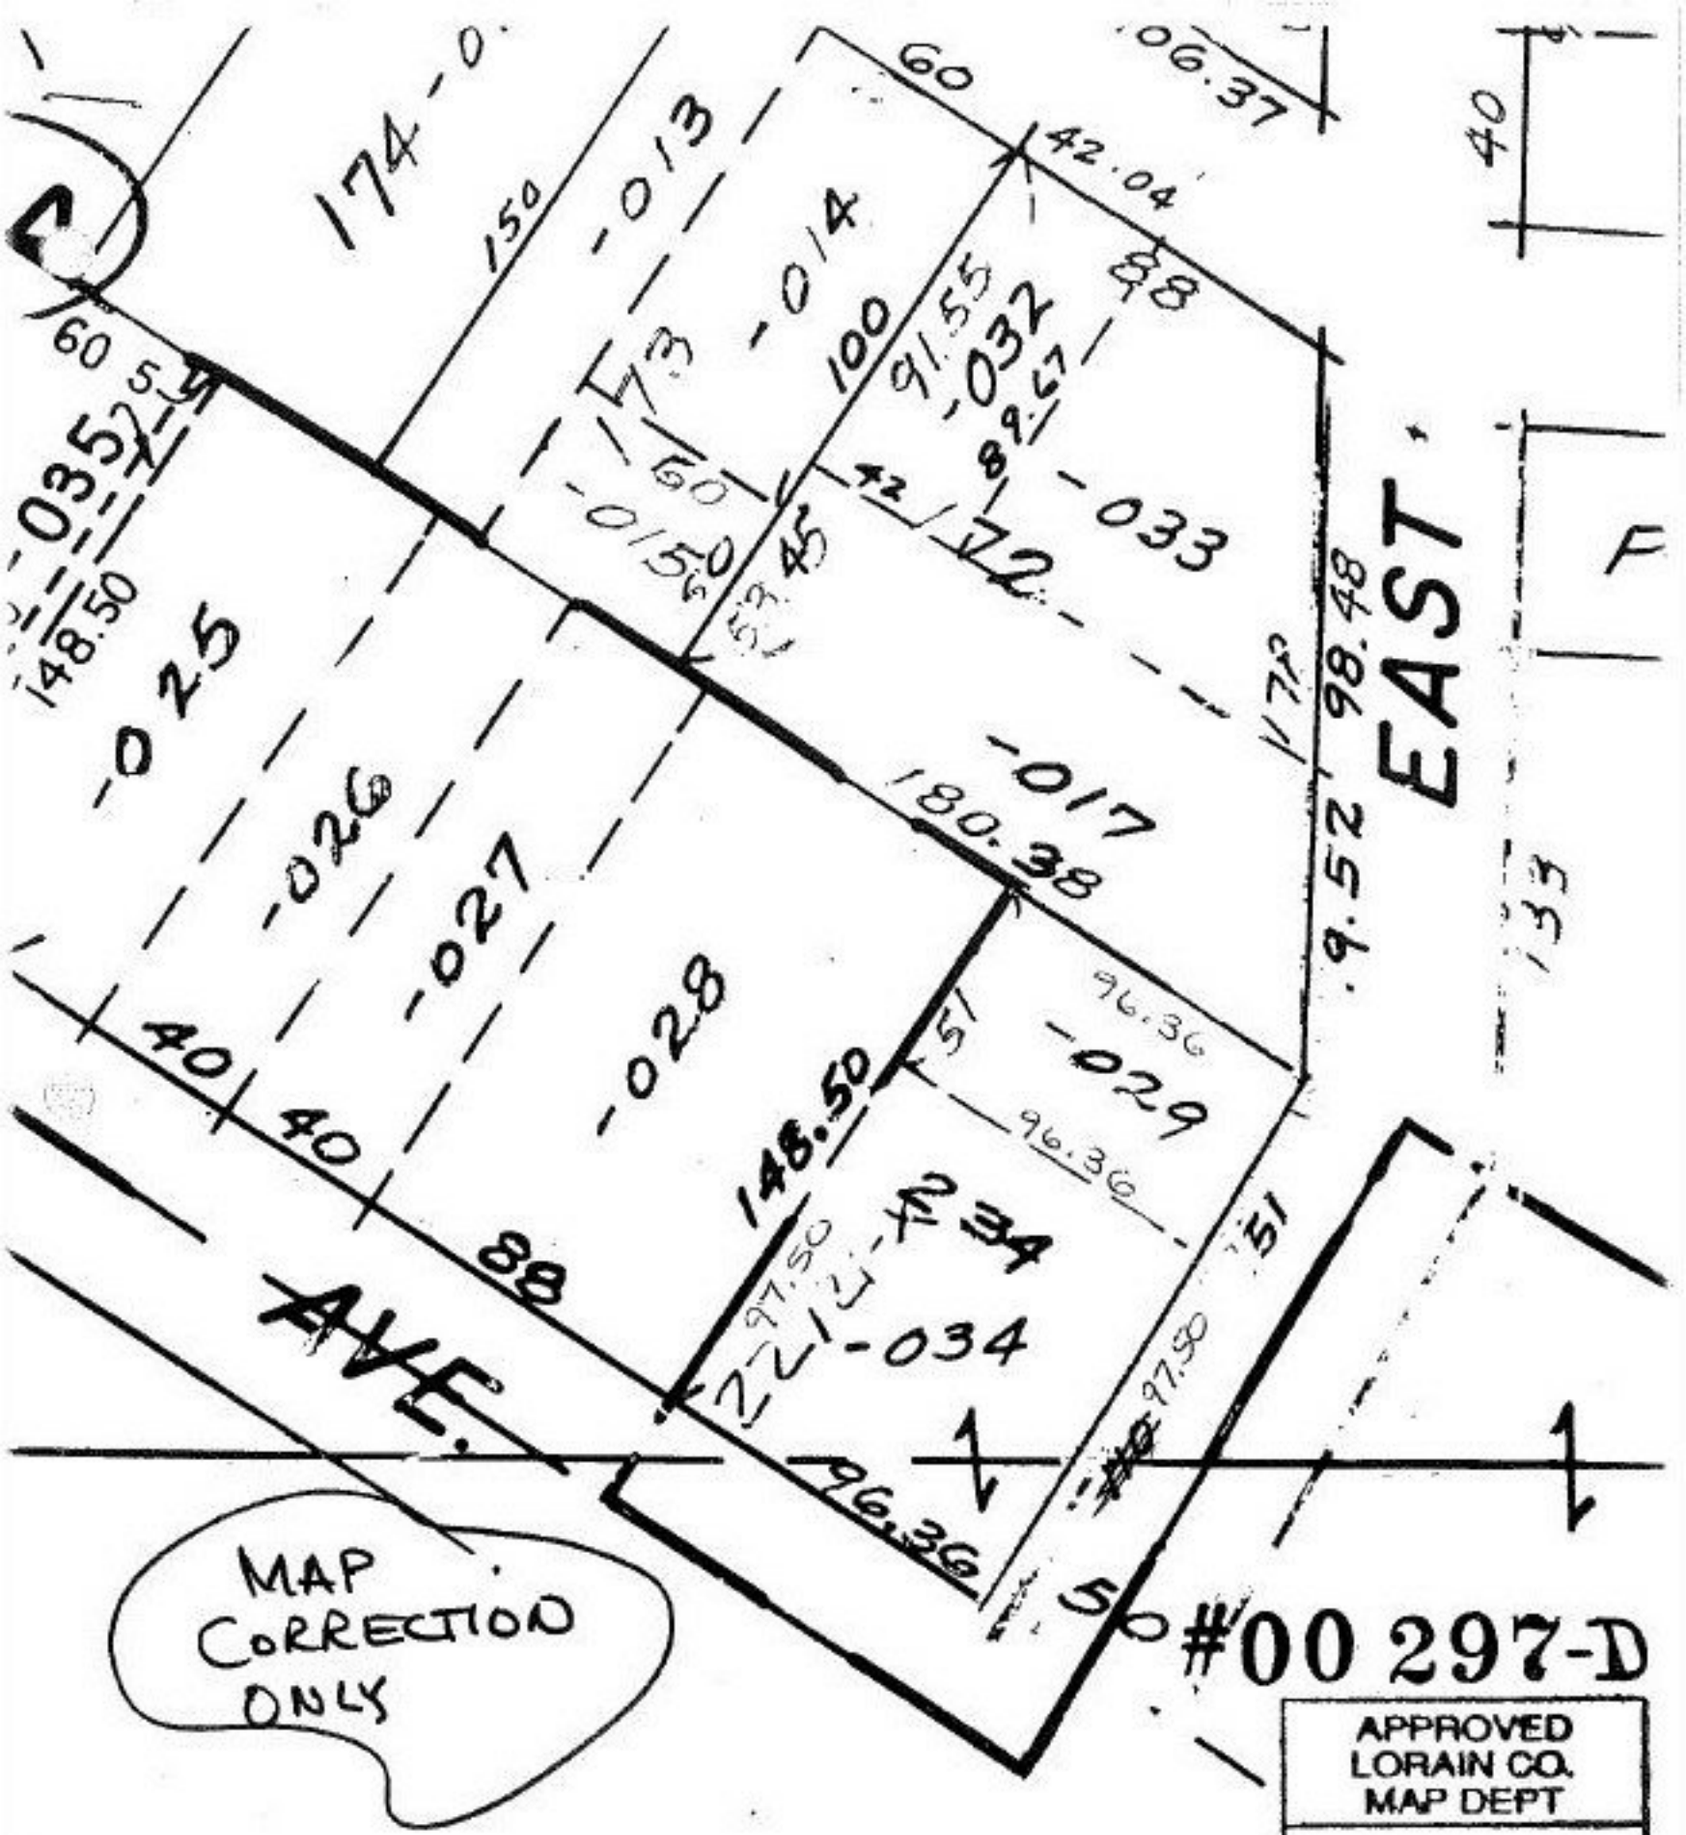

#00 297-D

APPROVED LORAIN CO. MAP DEPT
DATE 2-28-2000
PAGE 5-00-024 B
BY [signature]
297-D