PARENT PARCEL: 13-11-017-000-009

CHILD PARCEL: 13-11-017-000-024, 025

STARTING POINT: C/L BAIRD ROAD AT THE SW CORNER O.L. 17

NO. 00301

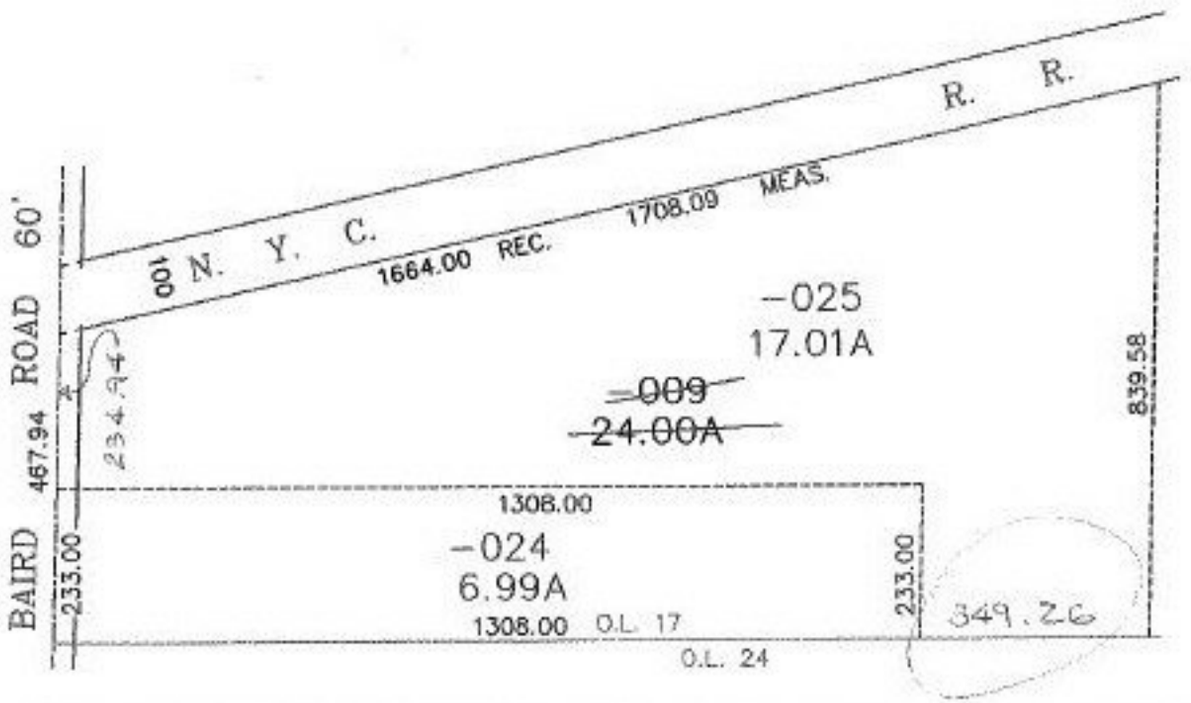

FB
2-21-00

SPLITS/DEEDS PROCESSED

LORAIN COUNTY TAX MAP DEPARTMENT
226 MIDDLE AVE. ELYRIA, OHIO

SURVEYED BY: EARL H HUNTER

CLOSURE: 0.00 / 10,000

MAP PAGE(S): 13-11-017

APPROVED BY: F. COLBERT DATE: 12/20/99

SCALE: 1"= 300 PRIOR INSTRUMENT: 956/210