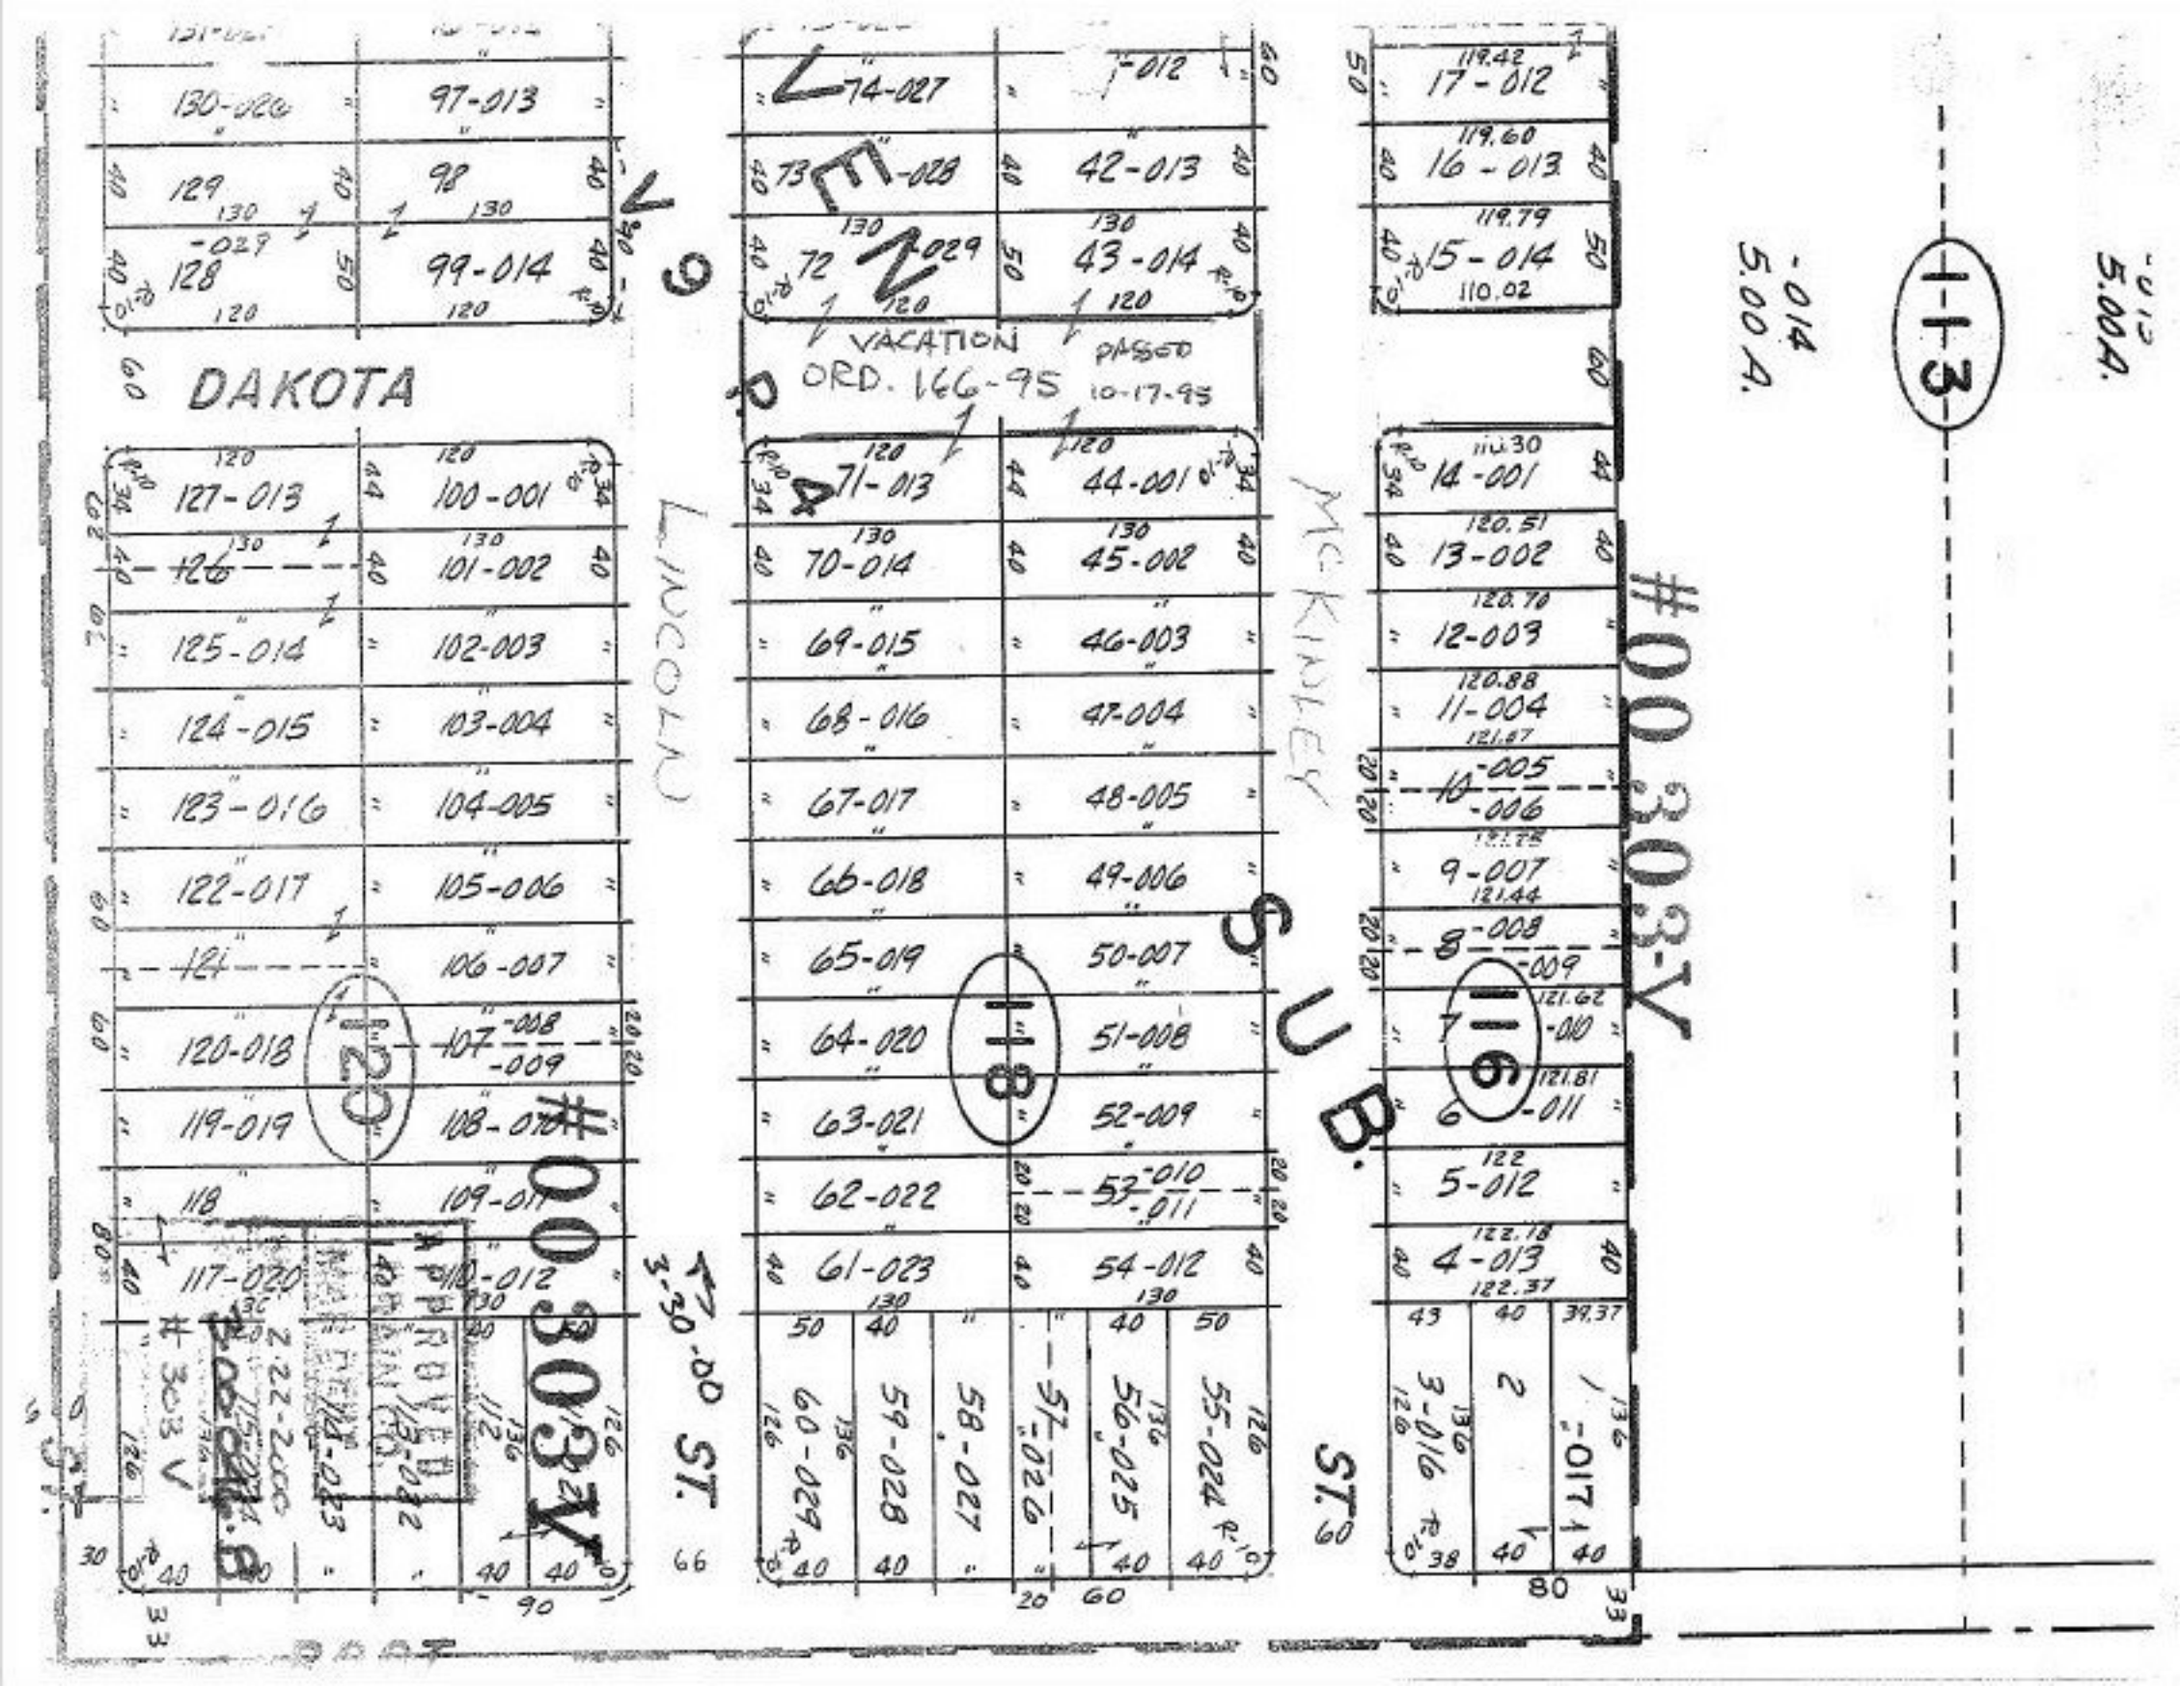
DAKOTA
LINCOLN
McKINLEY
SUB.
ST.
#00303-Y
#00303-V
VACATION ORD. 166-95 PASSED 10-17-95
-013
-014
5.00 A.
-015
5.00A.
-016
-017
