PARENT PARCEL: 01-00-074-000-022, 025

CHILD PARCEL: 01-00-074-000-026, 027, 028, 029, 030

STARTING POINT: P.I. OF TANGENTS TO THE C/L CURVE OF STICK ROAD
BEING ON THE EAST LINE OF O.L. 74

NO. 00303

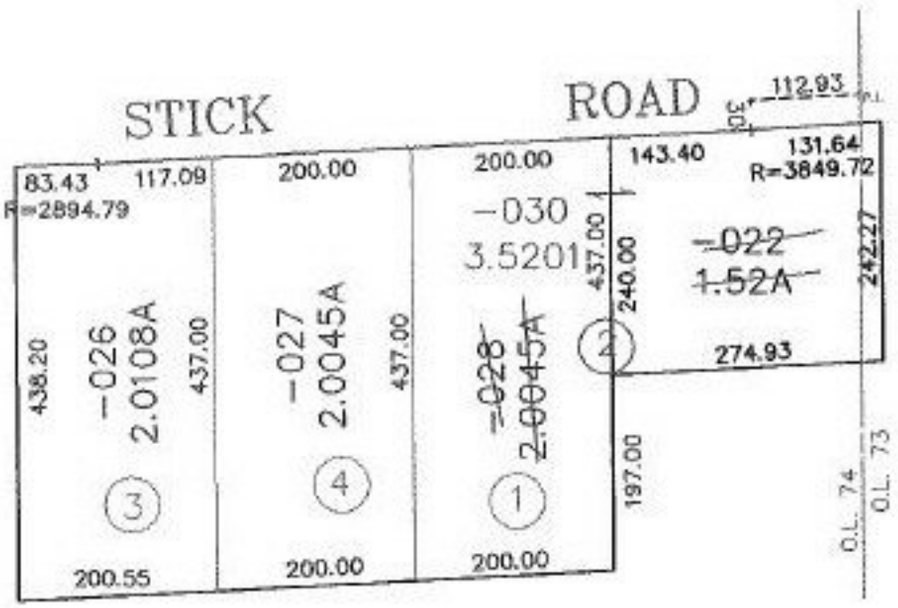

~~-025~~
~~79.76A~~

TS
3-29-00

-029
73.7402A

SPLITS/DEEDS PROCESSED
LORAIN COUNTY TAX MAP DEPARTMENT
226 MIDDLE AVE. ELYRIA, OHIO

SURVEYED BY: CHARLES P WARYU
CLOSURE: 0.11 / 10,000
MAP PAGE(S): 1-00-074-B
APPROVED BY: F. COLBERT DATE: 12/20/99
SCALE: 1"= 200 PRIOR INSTRUMENT: OR 394/334