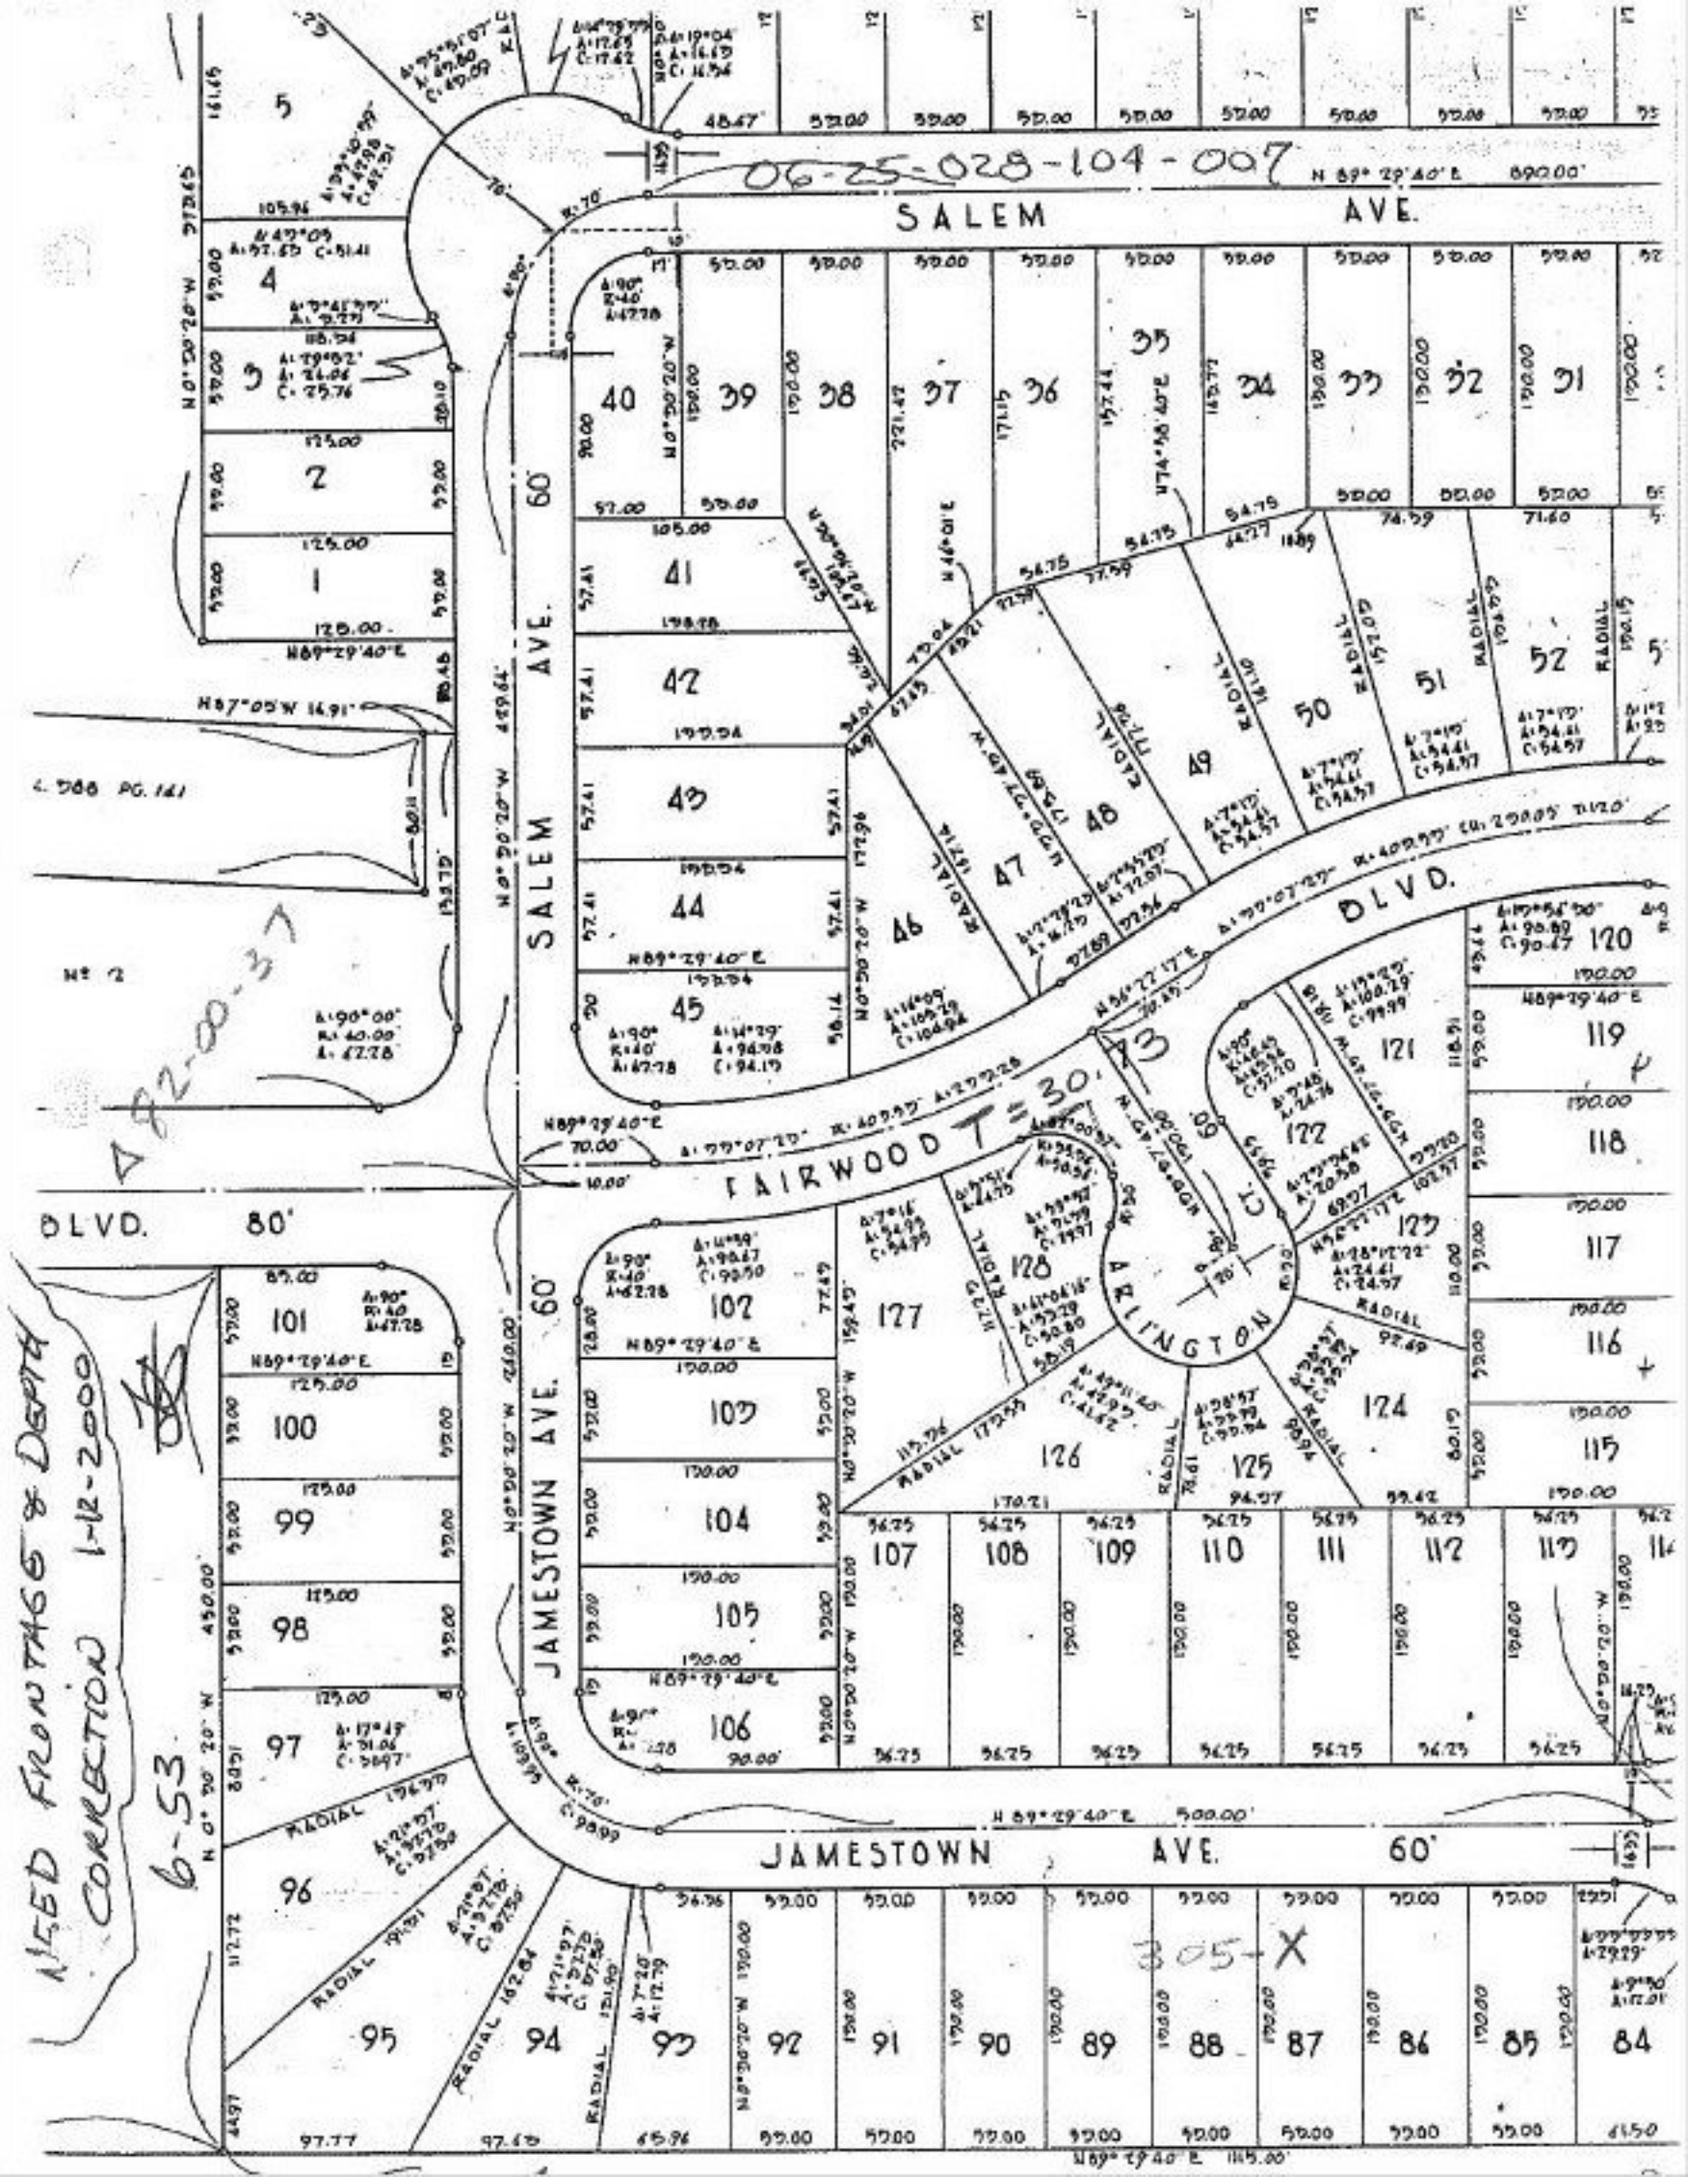
06-25-028-104-007
SALEM AVE.
N 89° 29' 40" E 890.00'
SALEM AVE. 60'
JAMESTOWN AVE. 60'
FAIRWOOD BLVD.
ARLINGTON CT.
JAMESTOWN AVE. 60'
N 89° 29' 40" E 1145.00'
N 89° 29' 40" E 500.00'
N 89° 29' 40" E 70.00'
N 89° 29' 40" E 190.00'
N 89° 29' 40" E 125.00'
