PARENT PARCEL: 02-01-003-116-003

CHILD PARCEL: 02-01-003-116-008, 009, 010

STARTING POINT: MON. BOX IN C/L COLORADO AVENUE N 52-30-49 E A DISTANCE OF 276.51 FEET FROM THE C/L OF E STREET

NO. 00305

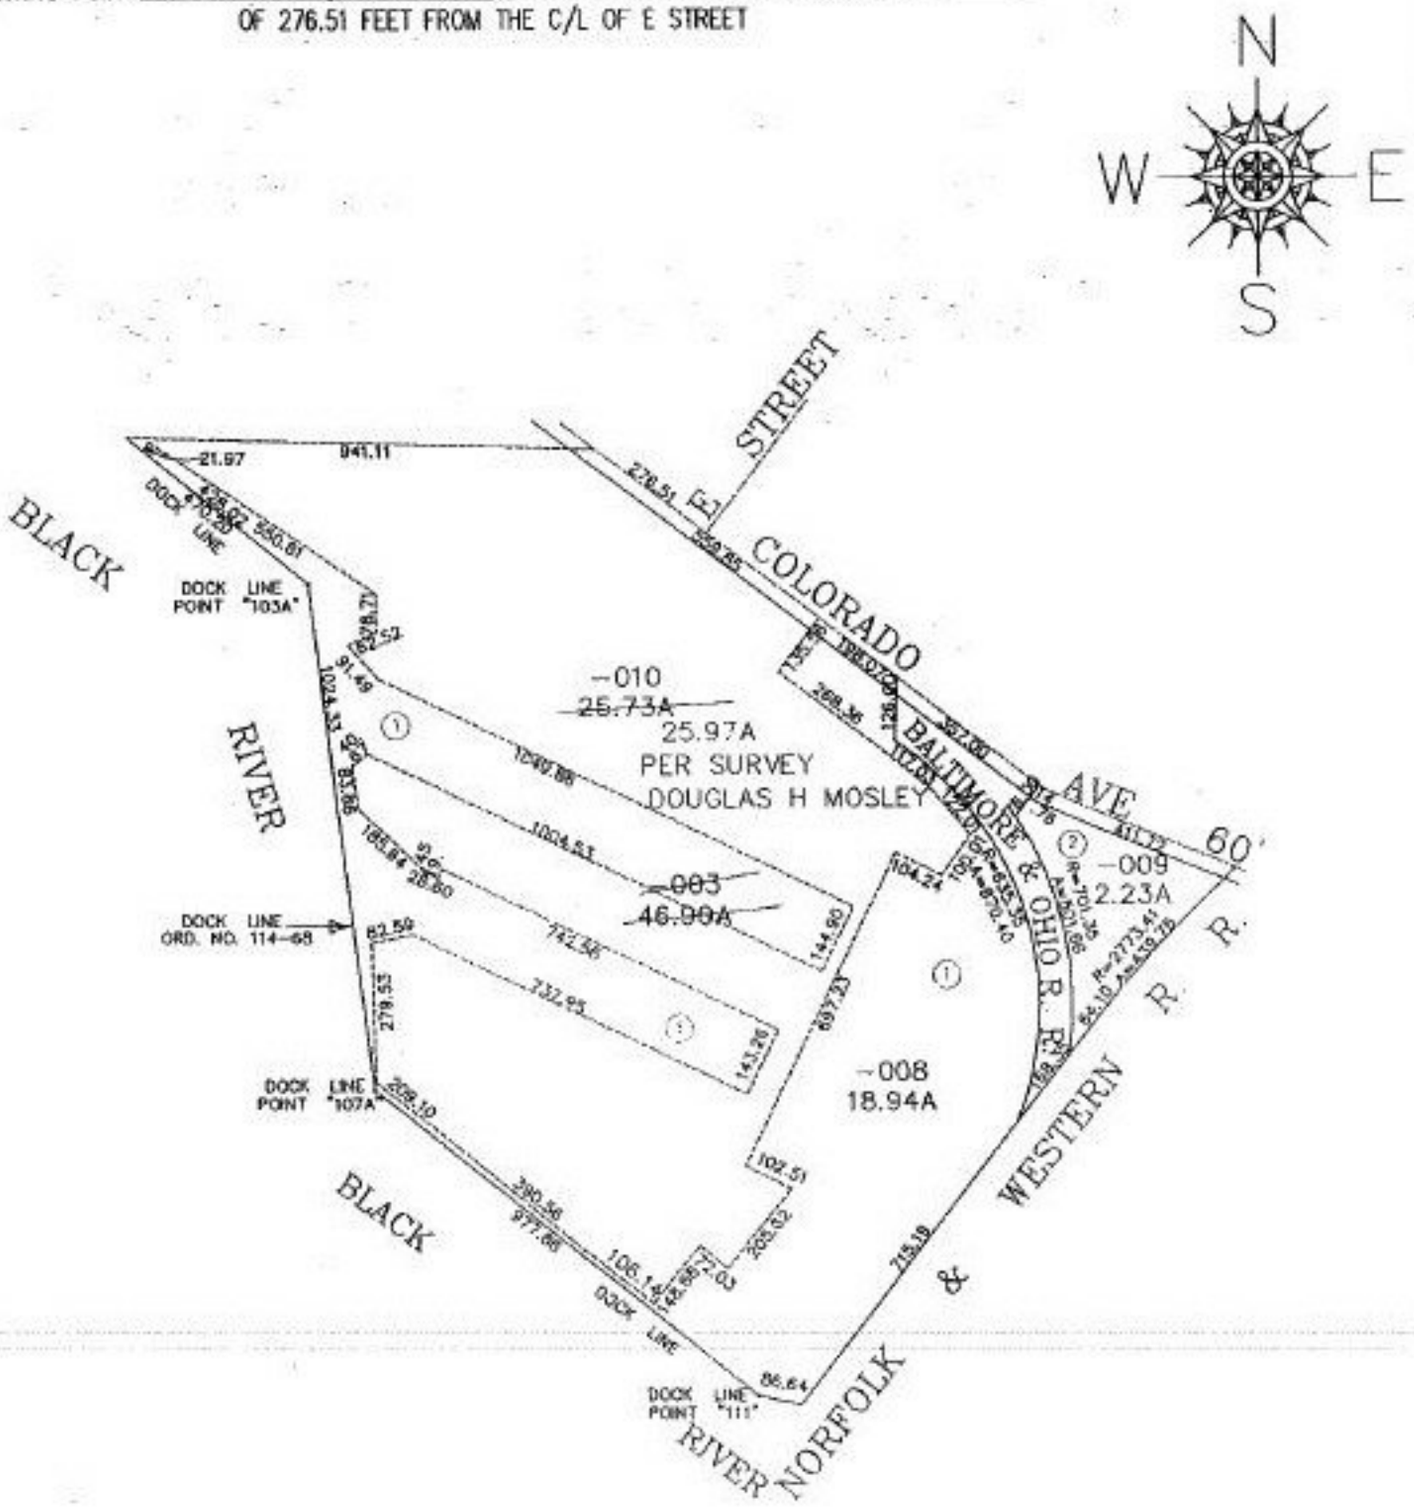

SPLITS/DEEDS PROCESSED

LORAIN COUNTY TAX MAP DEPARTMENT

226 MIDDLE AVE. ELYRIA, OHIO

SURVEYED BY: DOUGLAS H MOSLEY

CLOSURE: 0.04 / 10,000

MAP PAGE(S): 2-01-003-A,B,C,D

APPROVED BY: F. COLBERT DATE: 12/20/99

SCALE: 1"= 400 PRIOR INSTRUMENT: 1389/99-107