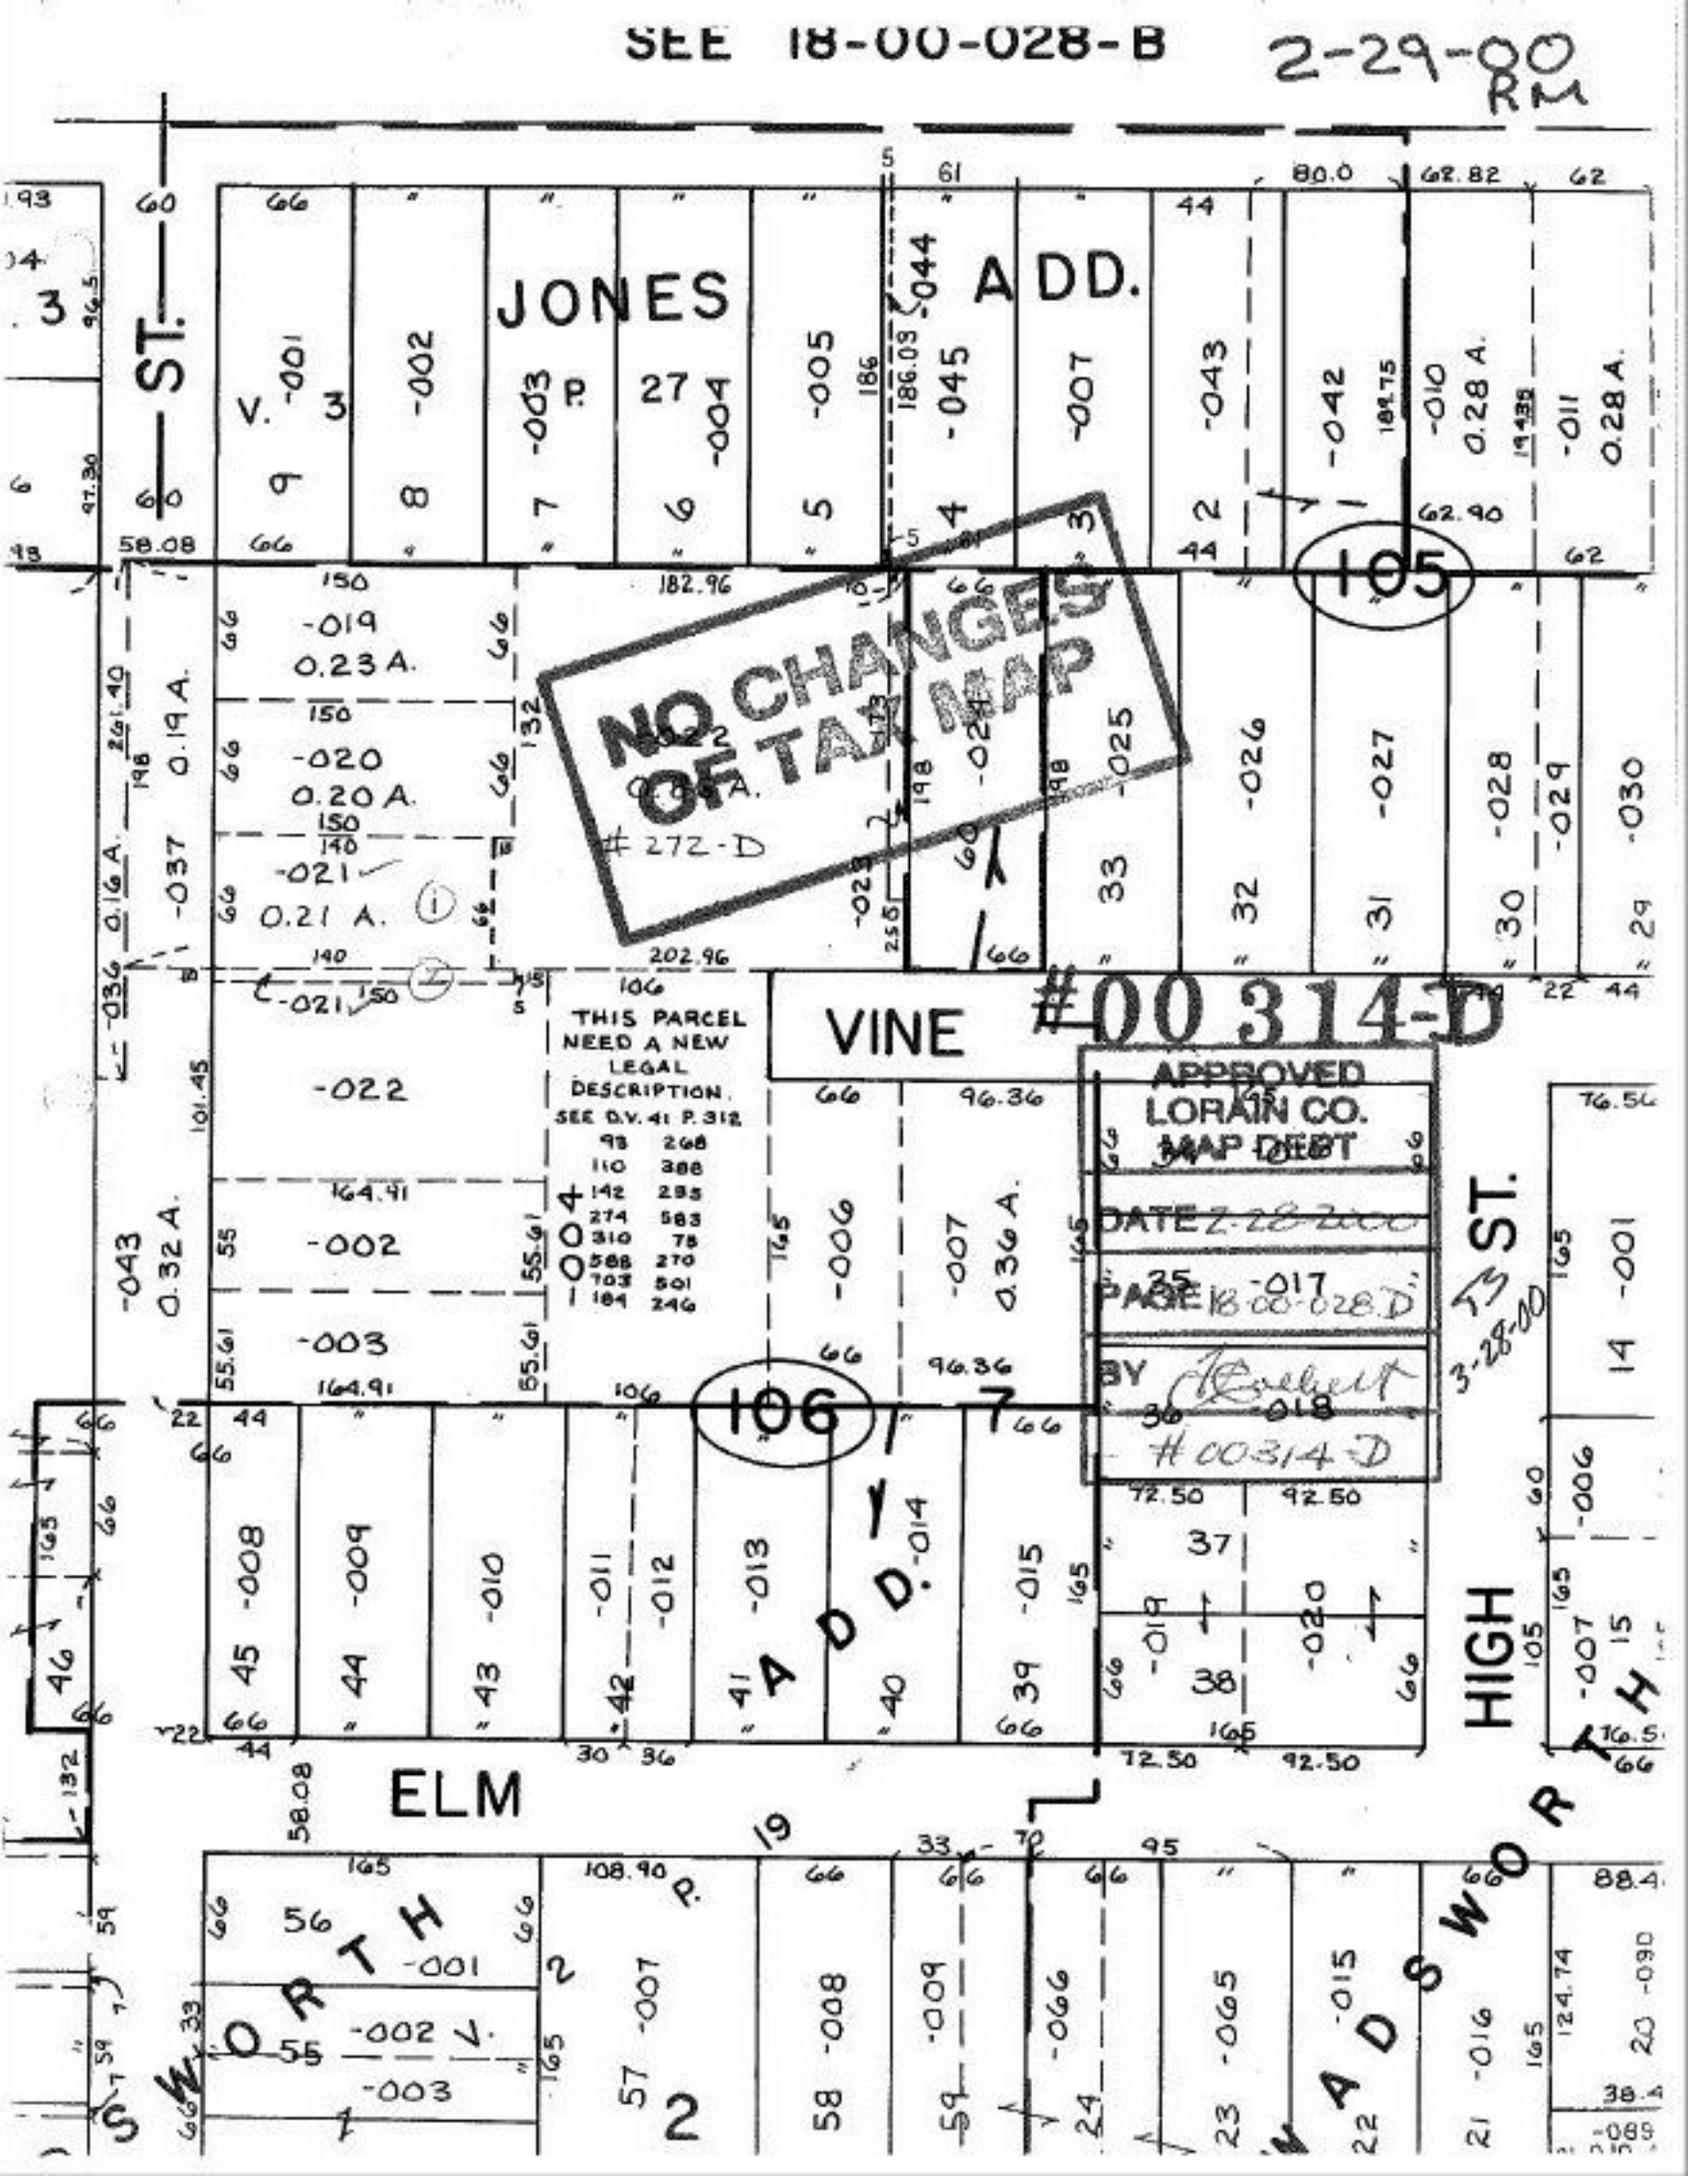
SEE 18-00-028-B
2-29-00
RM
JONES ADD.
ST.
NO CHANGES OF TAX MAP
#272-D
105
106
VINE
#00314-D
APPROVED
LORAIN CO.
MAP DEPT
DATE 2-28-2000
PAGE 18-00-028.D
BY
#00314-D
THIS PARCEL NEED A NEW LEGAL DESCRIPTION. SEE D.V. 41 P. 312
93 268
110 388
142 285
274 583
310 75
588 270
703 501
184 246
004
ELM
HIGH
ST.
3-28-00
NORTH
WADSWORTH