PARENT PARCEL: 12-00-045-000-017, 028

CHILD PARCEL: 12-00-045-000-034, 035

STARTING POINT: MON. BOX AT C/Ls COLUMBIA-WEST RIVER ROAD & ELYRIA-TWINSBURG ROAD.

NO. 00314

N

W E

S

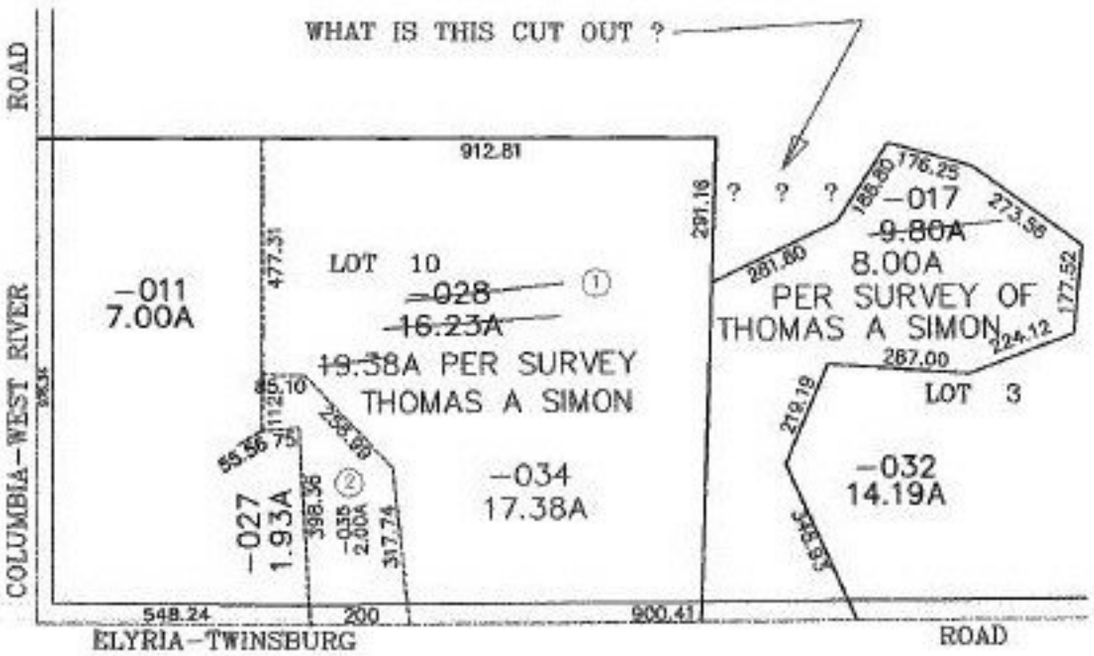

SPLITS/DEEDS PROCESSED

LORAIN COUNTY TAX MAP DEPARTMENT

226 MIDDLE AVE. ELYRIA, OHIO

SURVEYED BY: THOMAS A SIMON

CLOSURE: 0.03 / 10,000

MAP PAGE(S): 12-00-045-A & B 1/21/2000

APPROVED BY: F. COLBERT DATE: ~~12/28/99~~

SCALE: 1"= 400 PRIOR INSTRUMENT: OR 618/855