PARENT PARCEL: 14-00-022-000-004
CHILD PARCEL: 14-00-022-000-011, 012
STARTING POINT: C/Ls KIPTON-NICKLE PLATE ROAD & WEST ROAD

NO. 00316

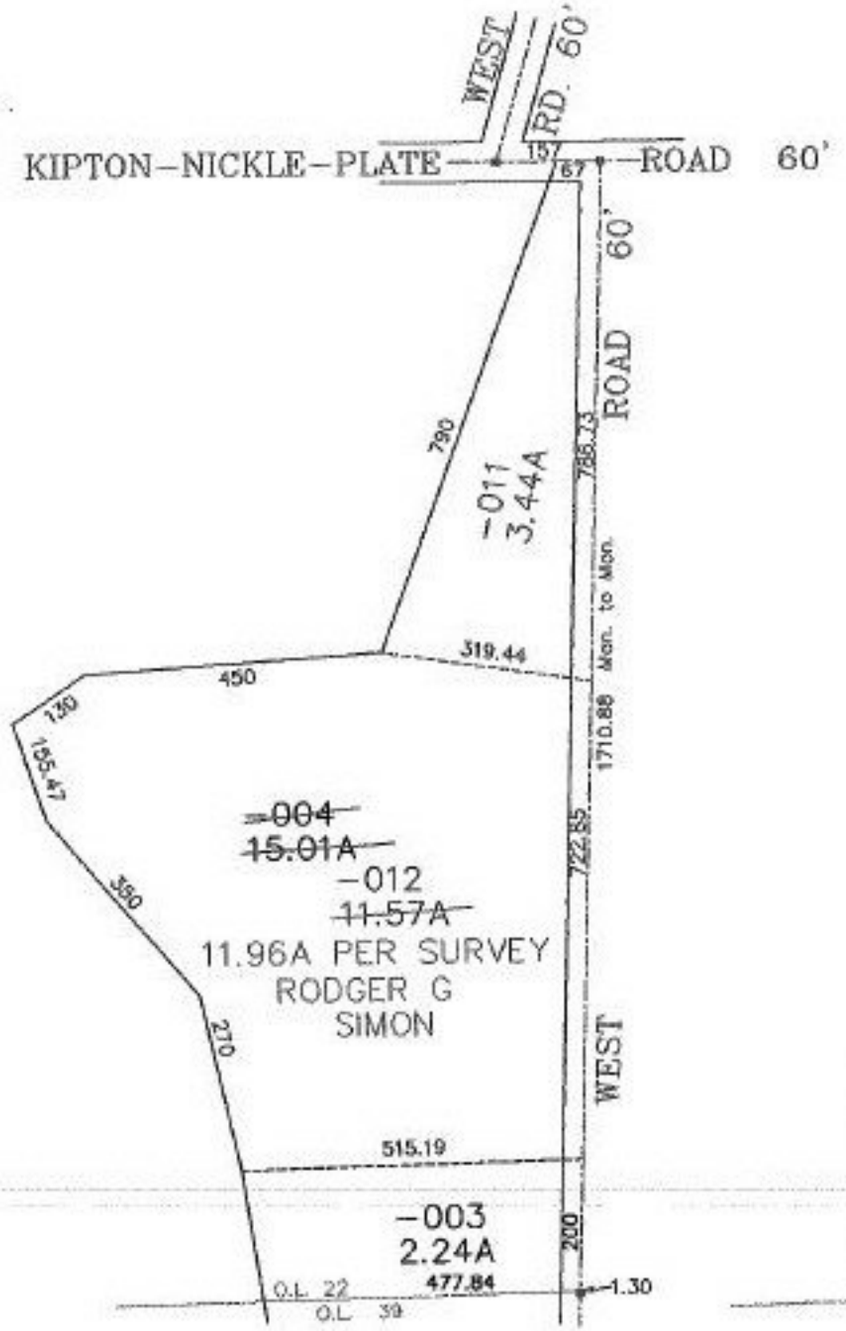

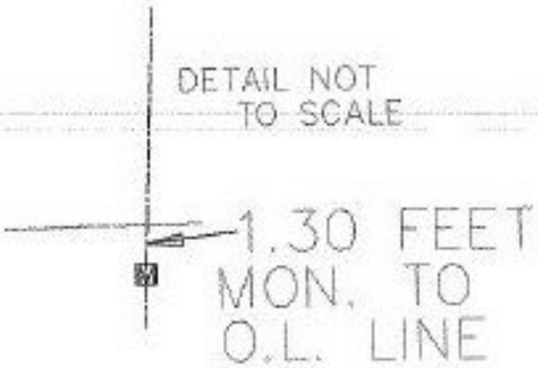

SPLITS/DEEDS PROCESSED
LORAIN COUNTY TAX MAP DEPARTMENT
226 MIDDLE AVE. ELYRIA, OHIO

SURVEYED BY: RODGER G SIMON
CLOSURE: 0.02 / 10,000
MAP PAGE(S): 14-D
APPROVED BY: E. COLBERDATE: 1/24/2000
SCALE: 1"= 300 PRIOR INSTRUMENT: DV XXXX/XXX