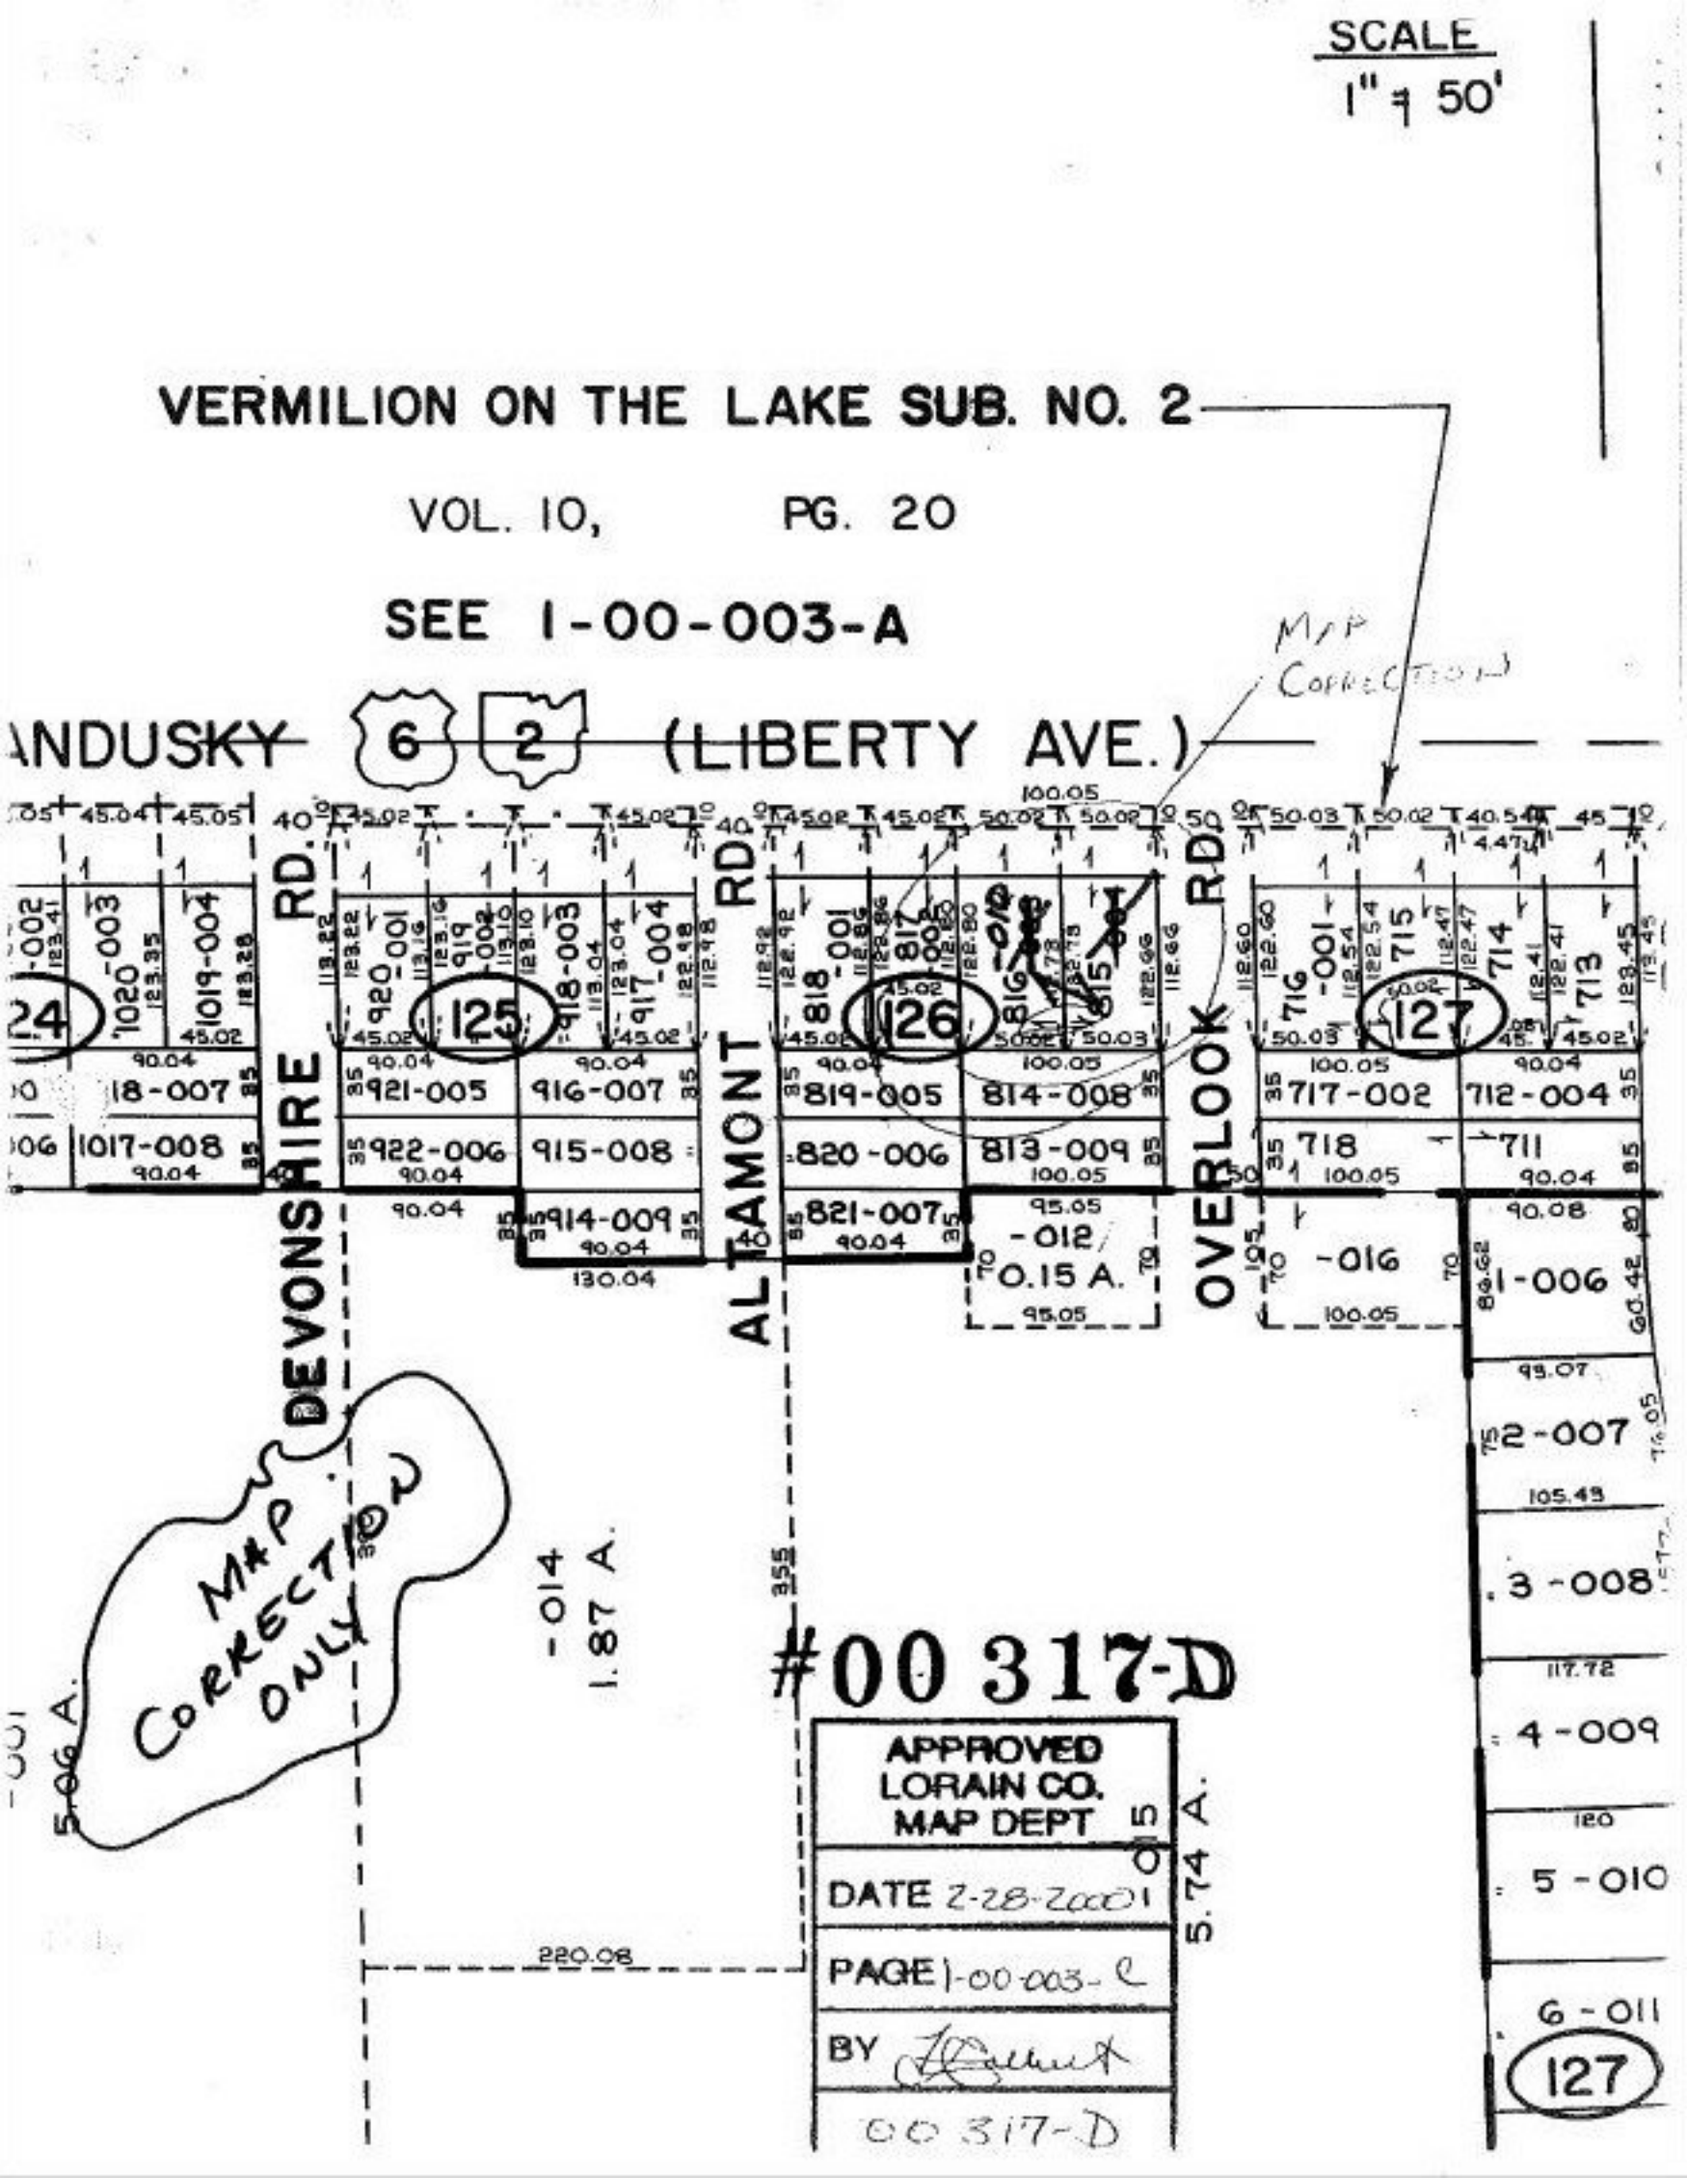
SCALE
1" = 50'
VERMILION ON THE LAKE SUB. NO. 2
VOL. 10, PG. 20
SEE 1-00-003-A
MAP CORRECTION
ANDUSKY 6 2 (LIBERTY AVE.)
DEVONSHIRE RD.
ALTAMONT RD.
OVERLOOK RD.
124
125
126
127
-012
0.15 A.
-014
1.87 A.
5.06 A.
5.74 A.
MAP CORRECTION ONLY
#00 317-D
APPROVED
LORAIN CO.
MAP DEPT
DATE 2-28-2001
PAGE 1-00-003-C
BY
00 317-D
220.08
355