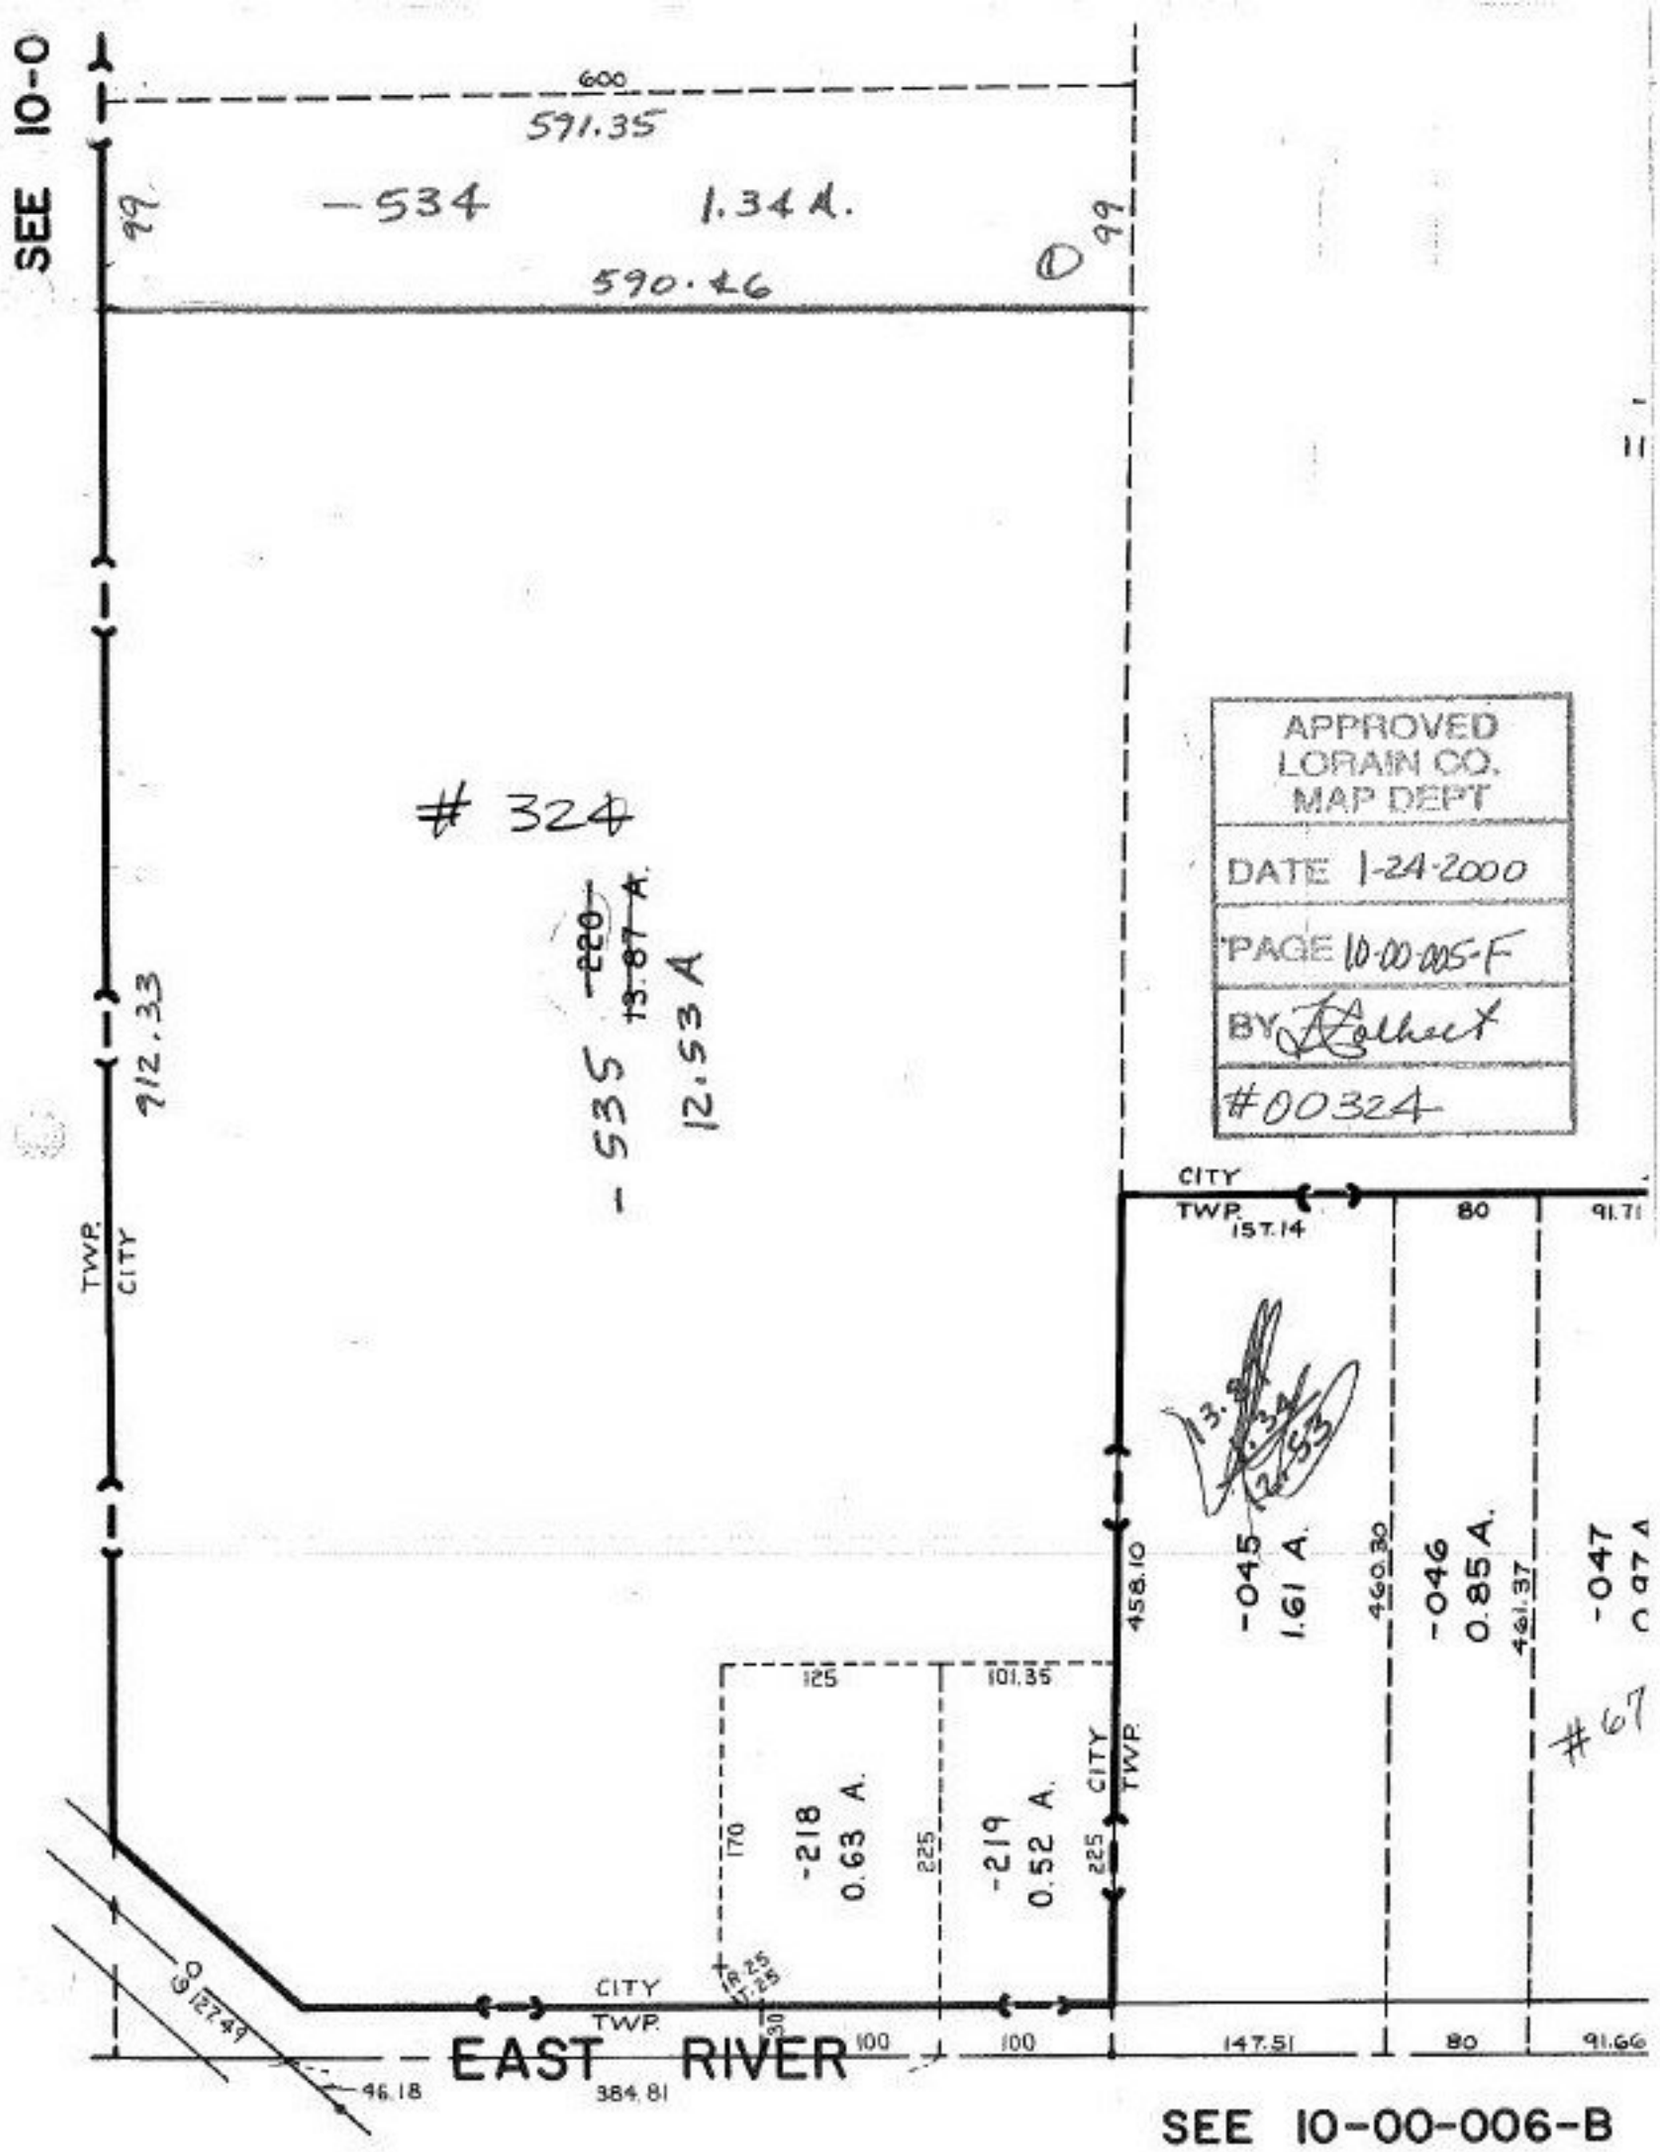
SEE 10-0
600
591.35
-534
1.34 A.
590.46
99
99
APPROVED
LORAIN CO.
MAP DEPT
DATE 1-24-2000
PAGE 10-00-005-F
BY
#00324
# 324
-535
12.53 A
912.33
TWP.
CITY
CITY
TWP.
157.14
80
91.71
-045
1.61 A.
460.30
-046
0.85 A.
461.37
-047
458.10
125
101.35
-218
0.63 A.
-219
0.52 A.
170
225
225
CITY
TWP.
#67
CITY
TWP.
EAST RIVER
100
100
147.51
80
91.66
384.81
46.18
127.49
SEE 10-00-006-B