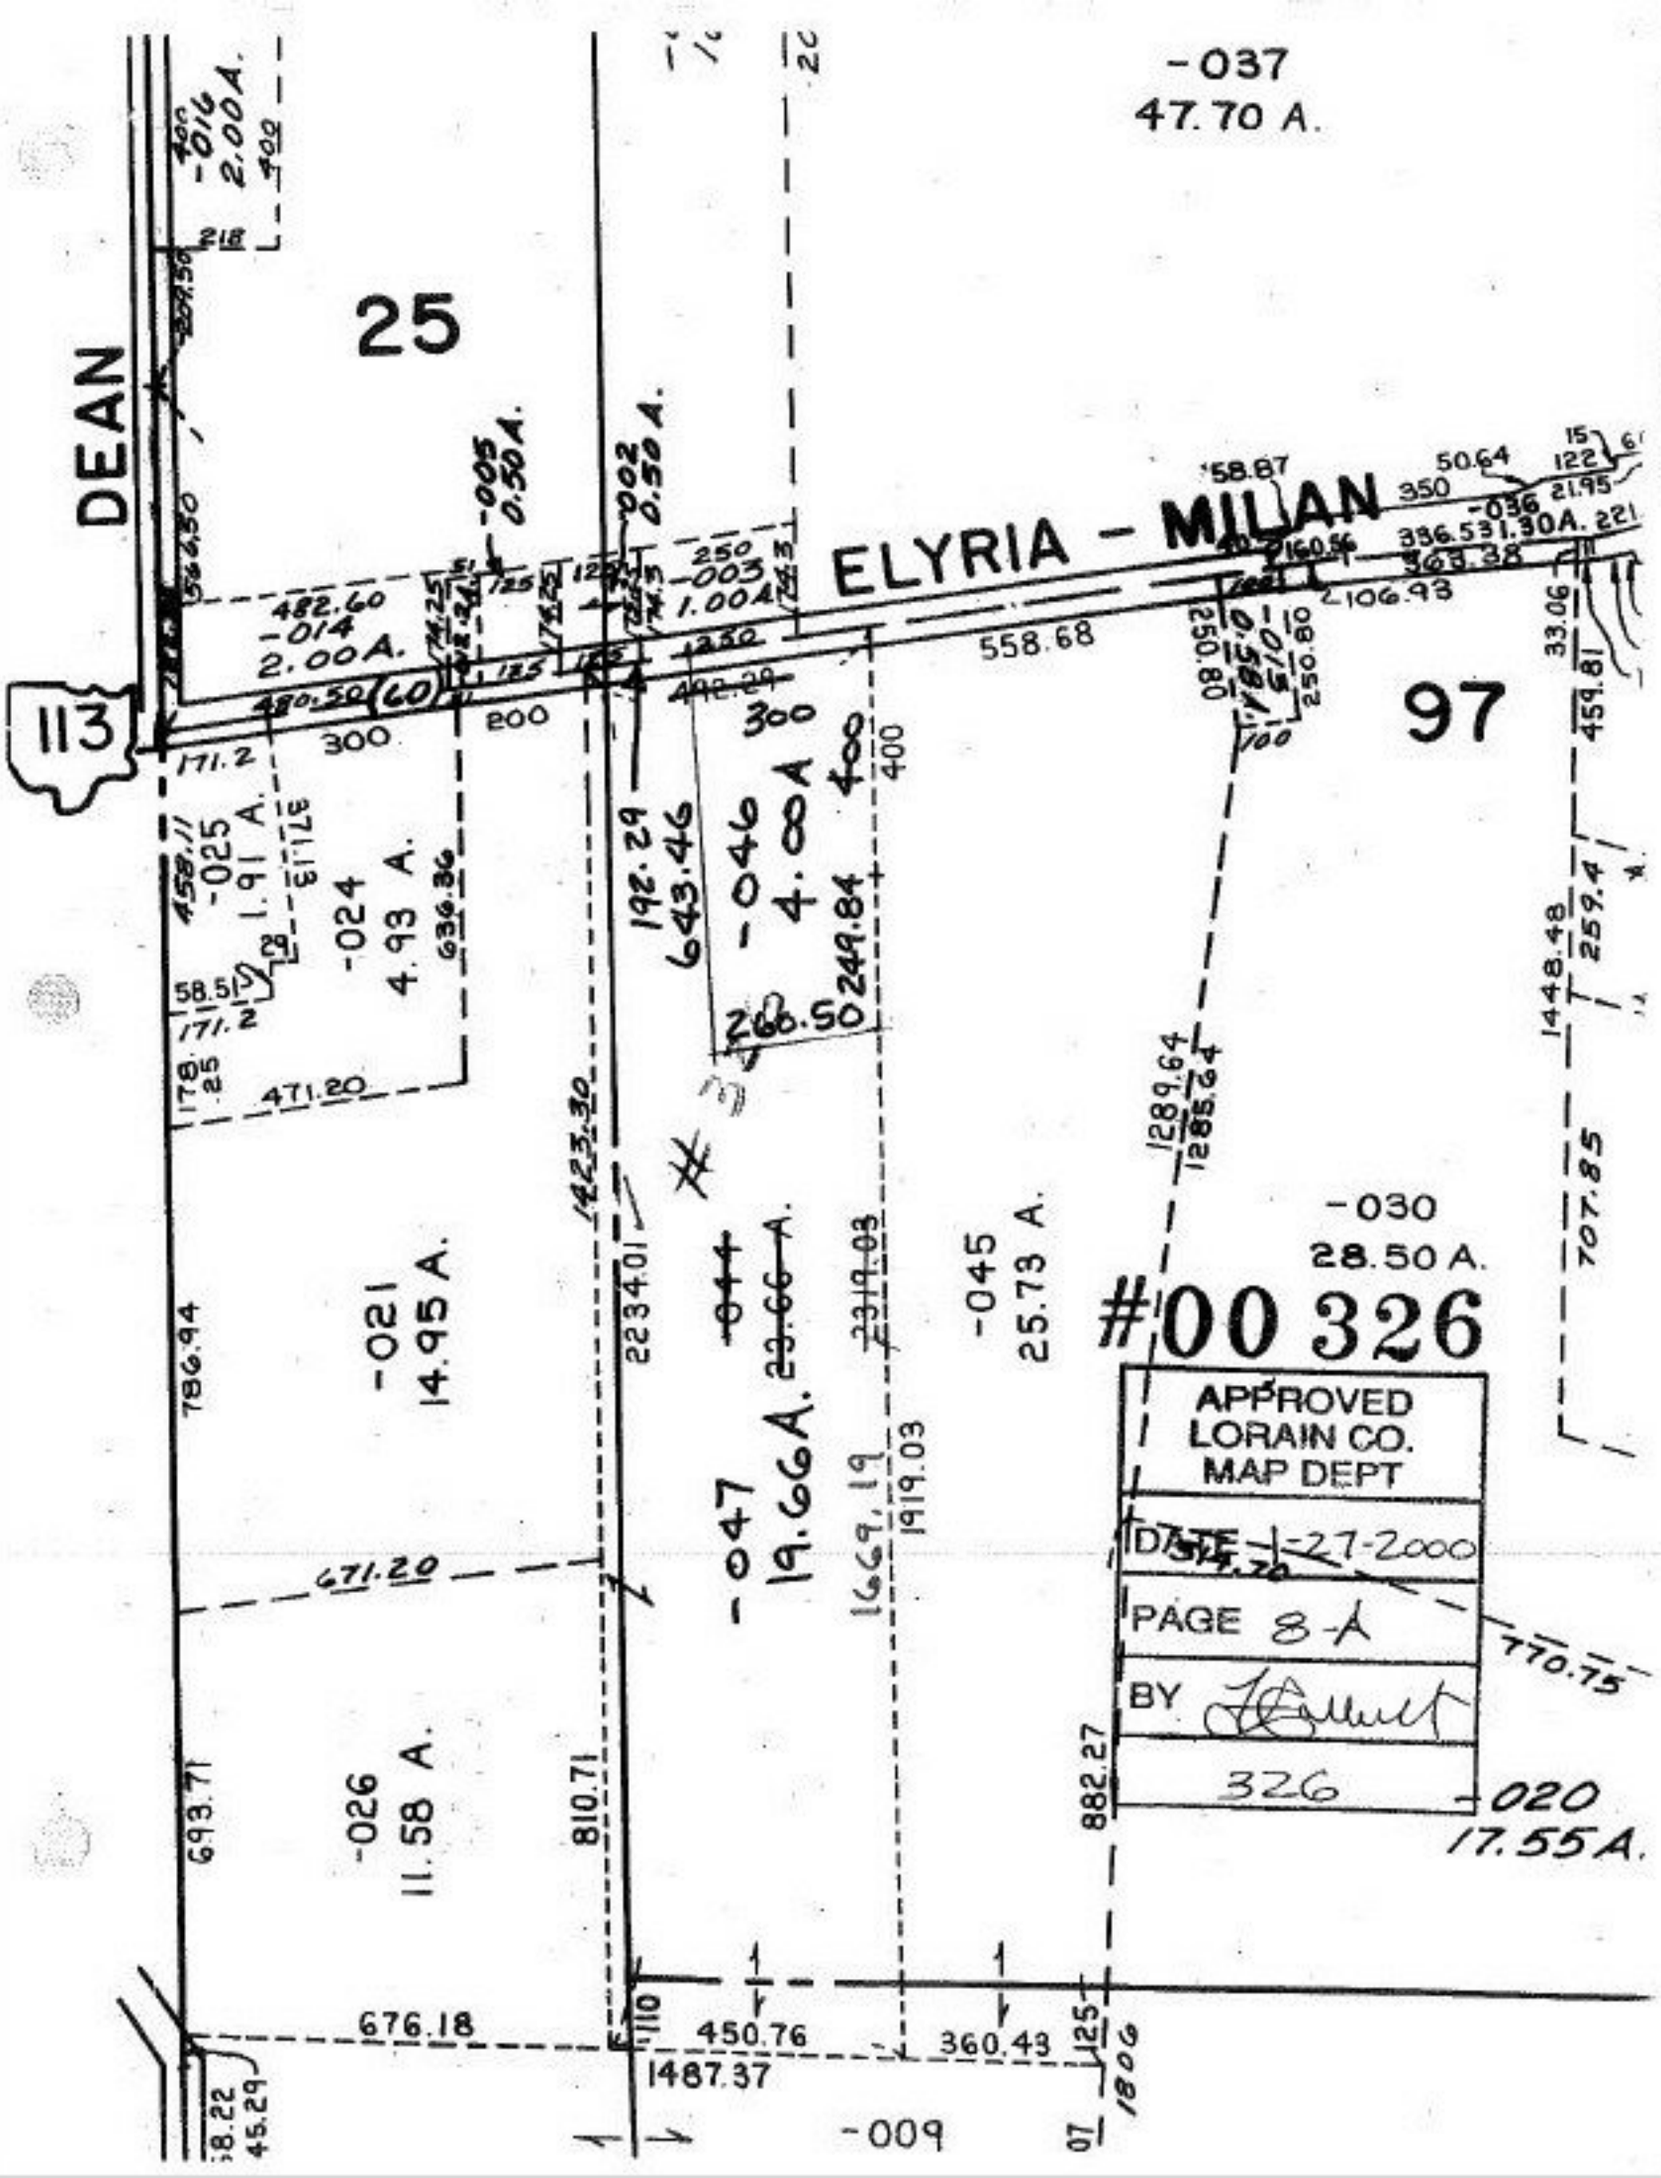
-037
47.70 A.
DEAN
25
ELYRIA - MILAN
97
-016
2.00A.
-005
0.50A.
-002
0.50 A.
-003
1.00A.
-014
2.00A.
-025
1.91 A.
-024
4.93 A.
-046
4.00A
-021
14.95 A.
-047
19.66A.
-045
25.73 A.
-030
28.50 A.
-026
11.58 A.
-020
17.55A.
-009
#00 326
APPROVED
LORAIN CO.
MAP DEPT
DATE 1-27-2000
PAGE 8-A
BY
326