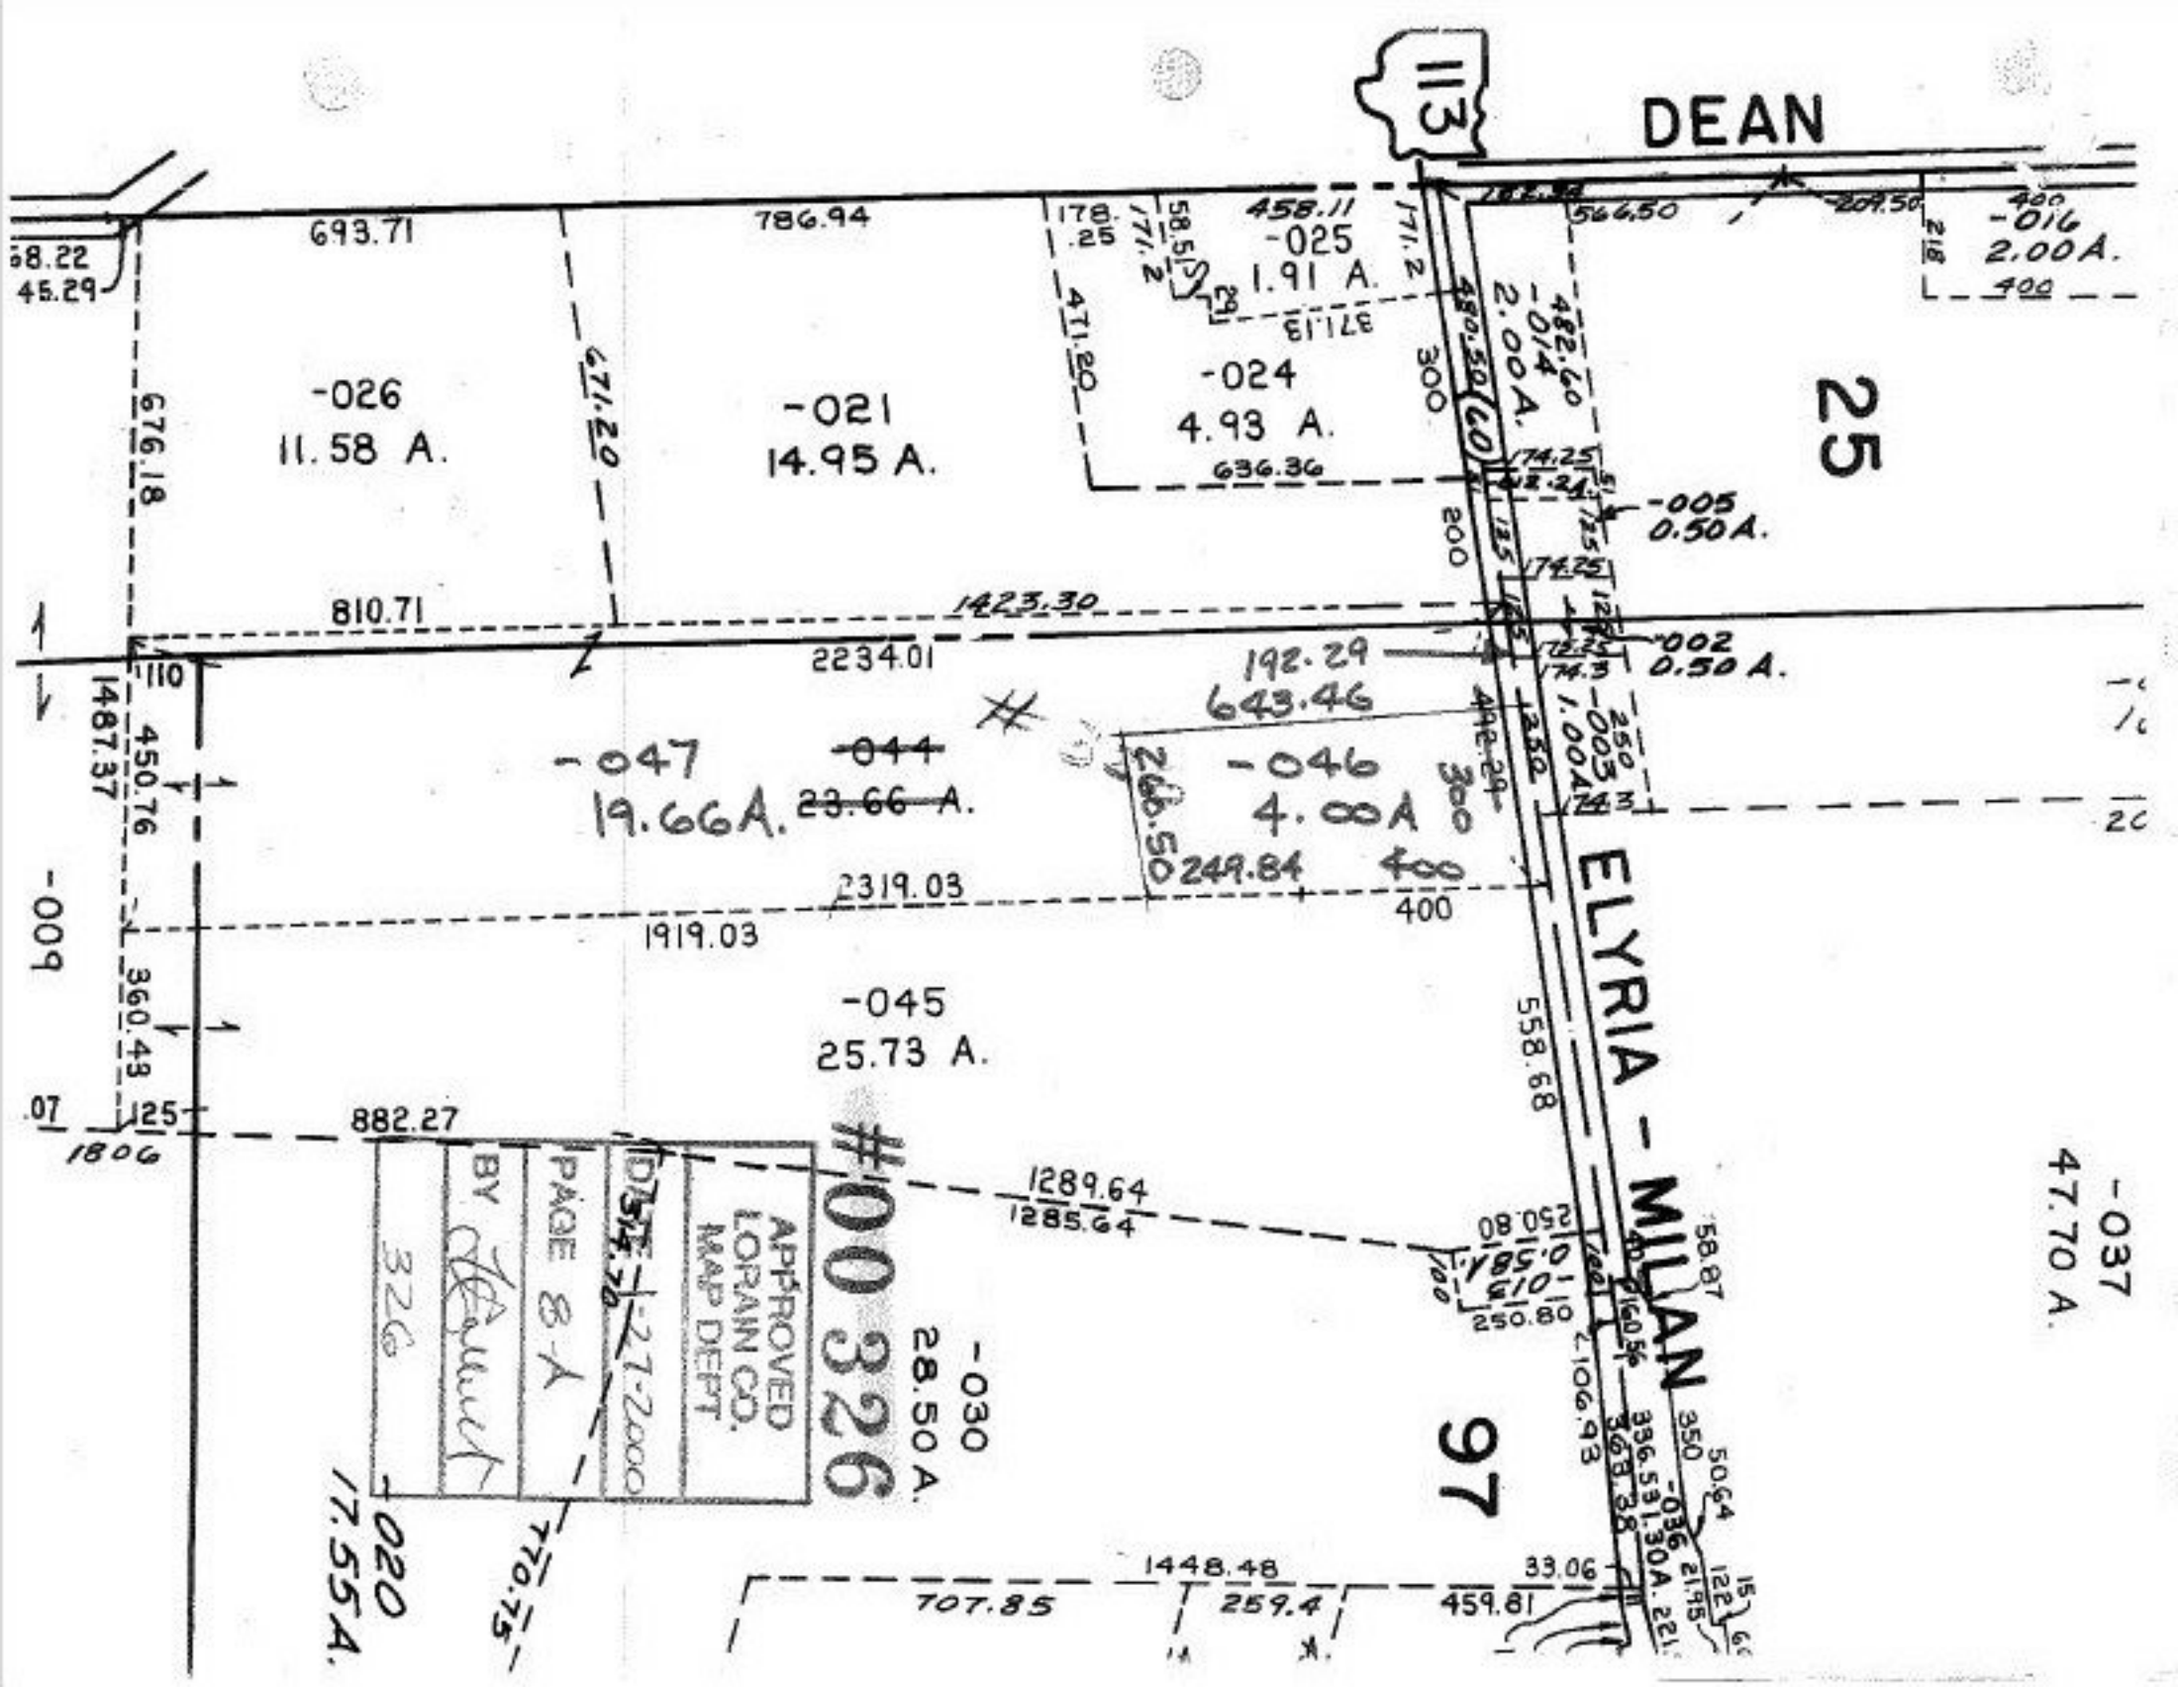
DEAN
113
693.71
786.94
458.11
-025
1.91 A.
-026
11.58 A.
-021
14.95 A.
-024
4.93 A.
25
-016
2.00A.
-014
2.00A.
-005
0.50A.
-002
0.50 A.
-003
1.00A.
810.71
1423.30
2234.01
-047
19.66A.
-044
23.66 A.
-046
4.00A
643.46
192.29
249.84
2319.03
1919.03
-045
25.73 A.
ELYRIA - MILLAN
882.27
1289.64
1285.64
#00 326
APPROVED
LORAIN CO.
MAP DEPT.
PAGE 8-A
BY
DATE 2-27-2000
326
-030
28.50 A.
-020
17.55A.
770.75
1448.48
707.85
259.4
459.81
97
-037
47.70 A.
-009
2106.93
558.68
336.53
1.30A.