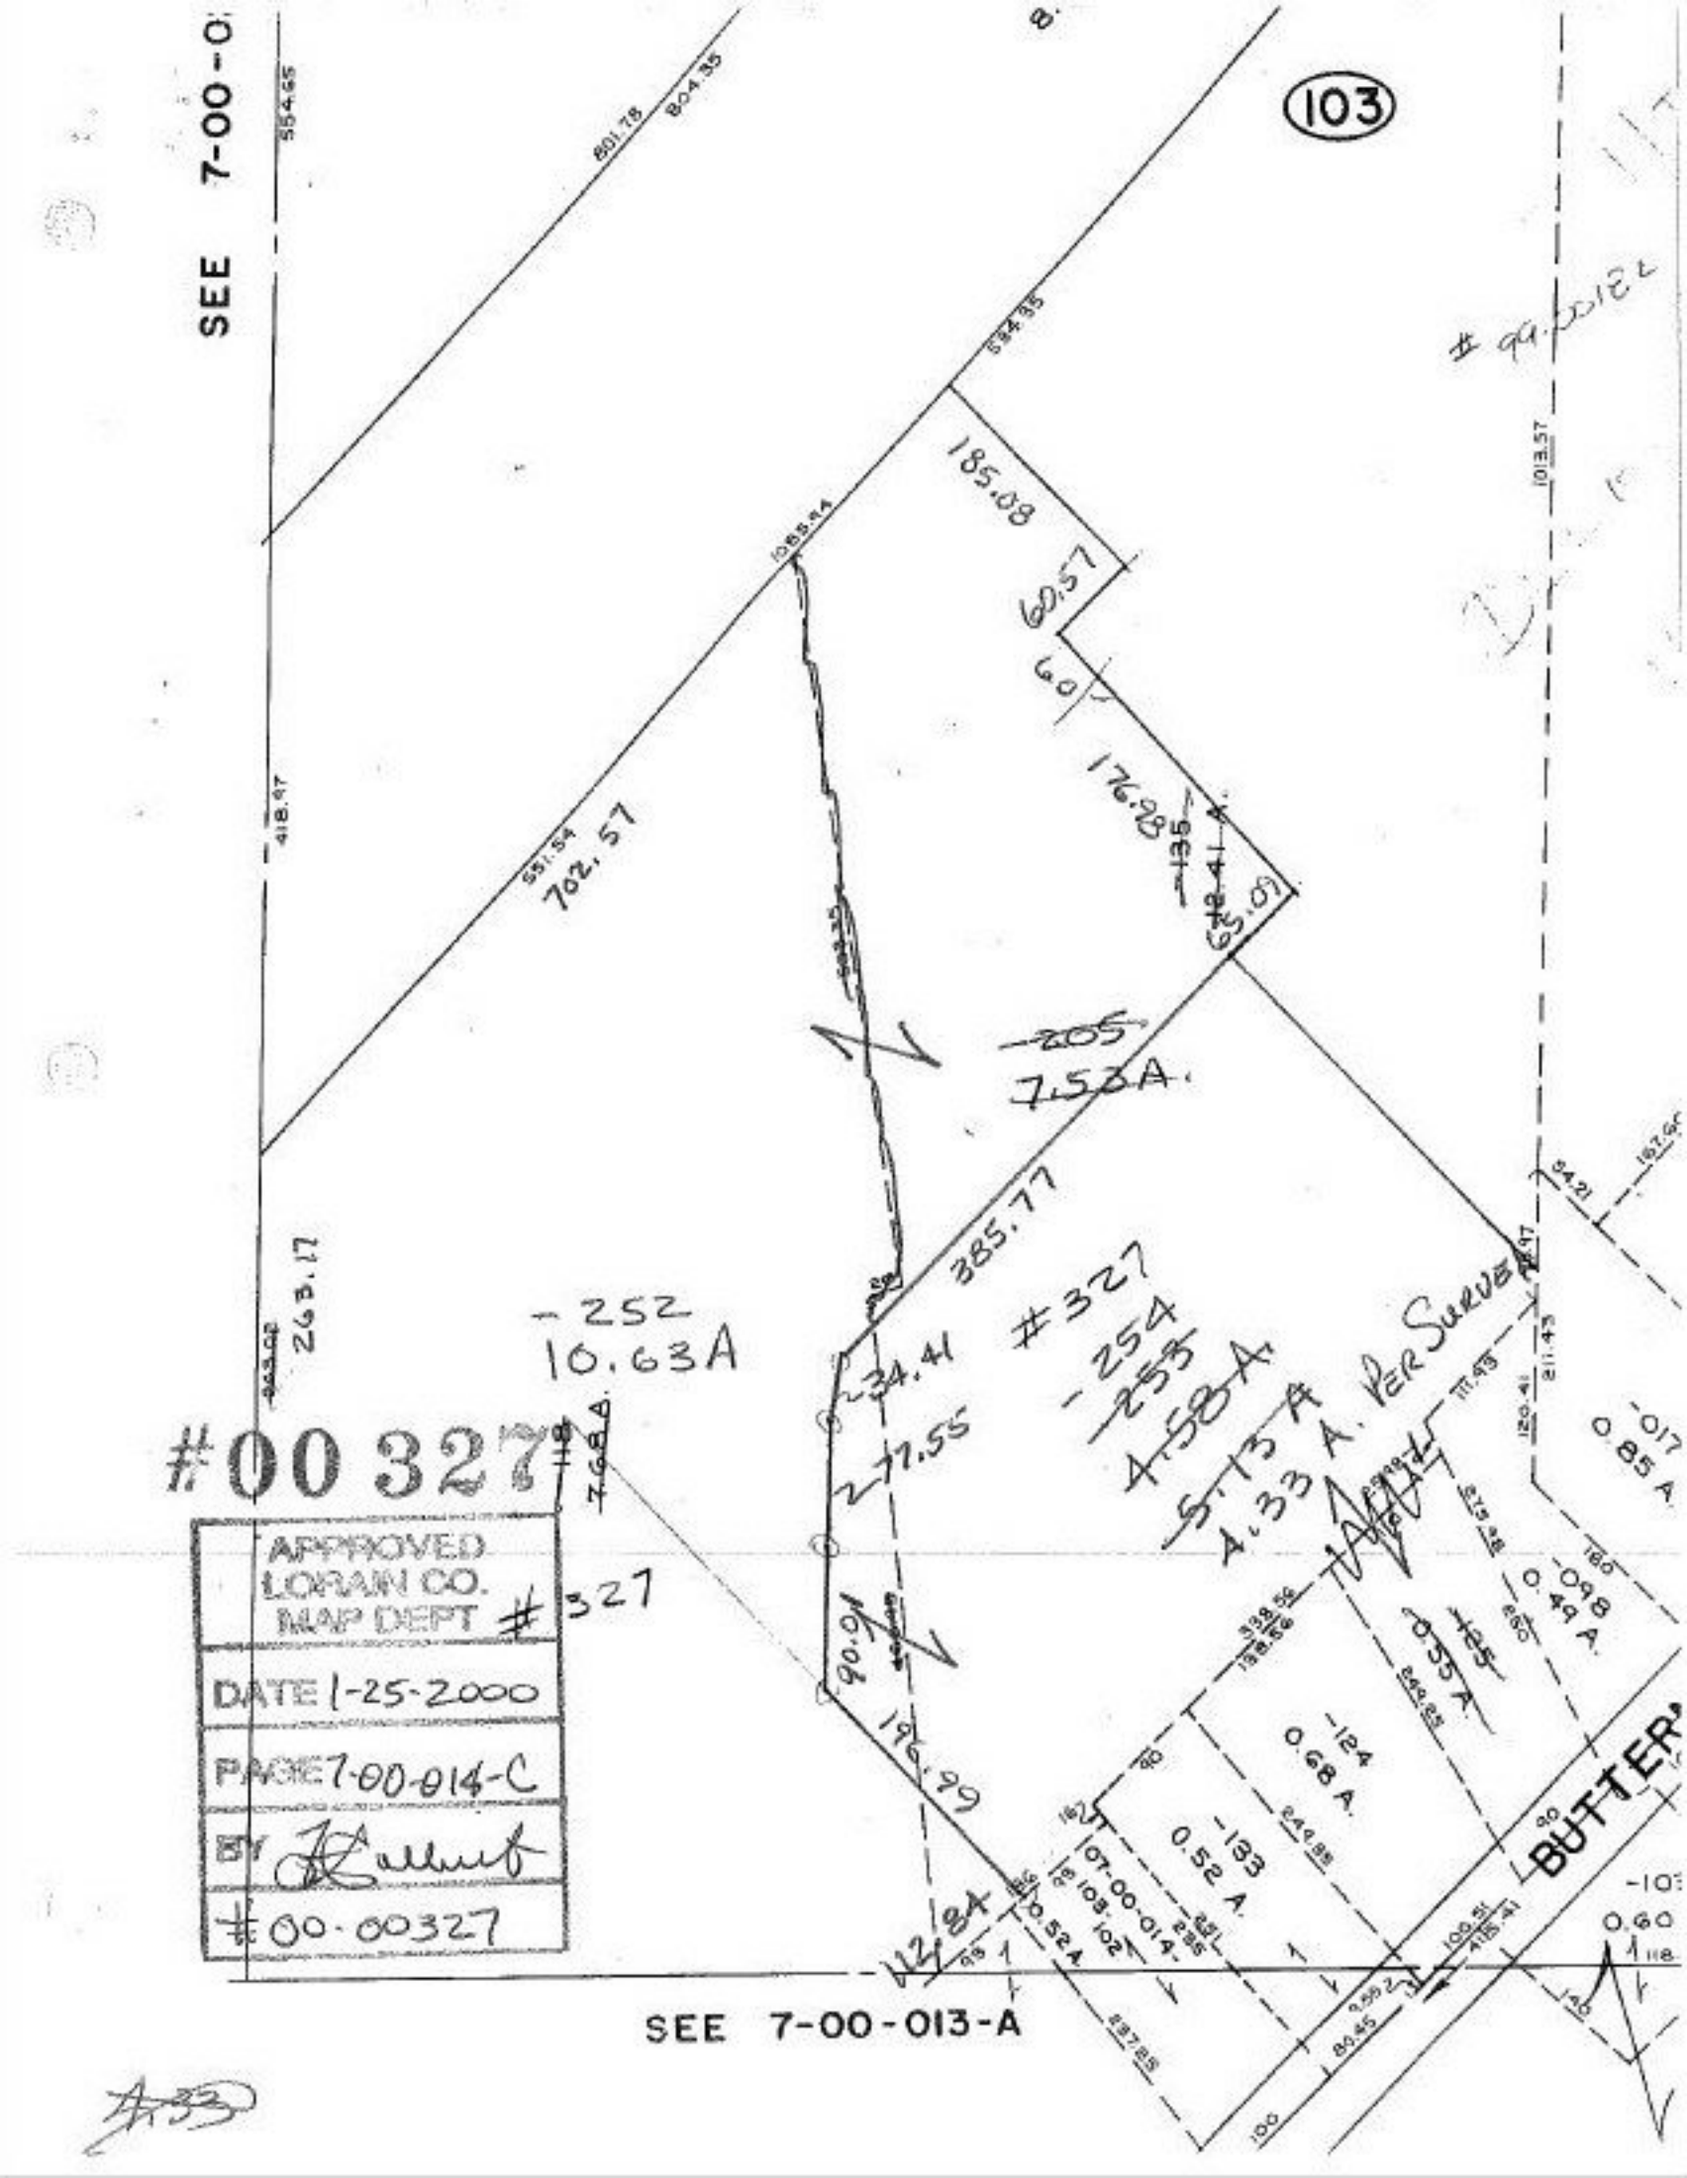
SEE 7-00-0
103
SEE 7-00-013-A
BUTTER
#00 327
APPROVED
LORAIN CO.
MAP DEPT #327
DATE 1-25-2000
PAGE 7-00-014-C
BY
#00-00327
-252
10.63A
#327
-254
-255
4.58A
5.13 A. PER SURVEY
4.33 A.
-205
7.56A.
-124
0.68 A.
-133
0.52 A.
-098
0.49 A.
-125
0.55 A.
-017
0.85 A.
0.60
185.08
60.57
176.98
63.07
702.57
551.54
418.47
263.17
385.77
277.55
134.41
90.01
196.99
554.35
804.35
801.78
554.65
1013.57
211.43
111.43
94.21
167.64
138.56
249.85
107-00-014
0.52 A.
187.85
85.45
100.51
415.41
0.50 A.