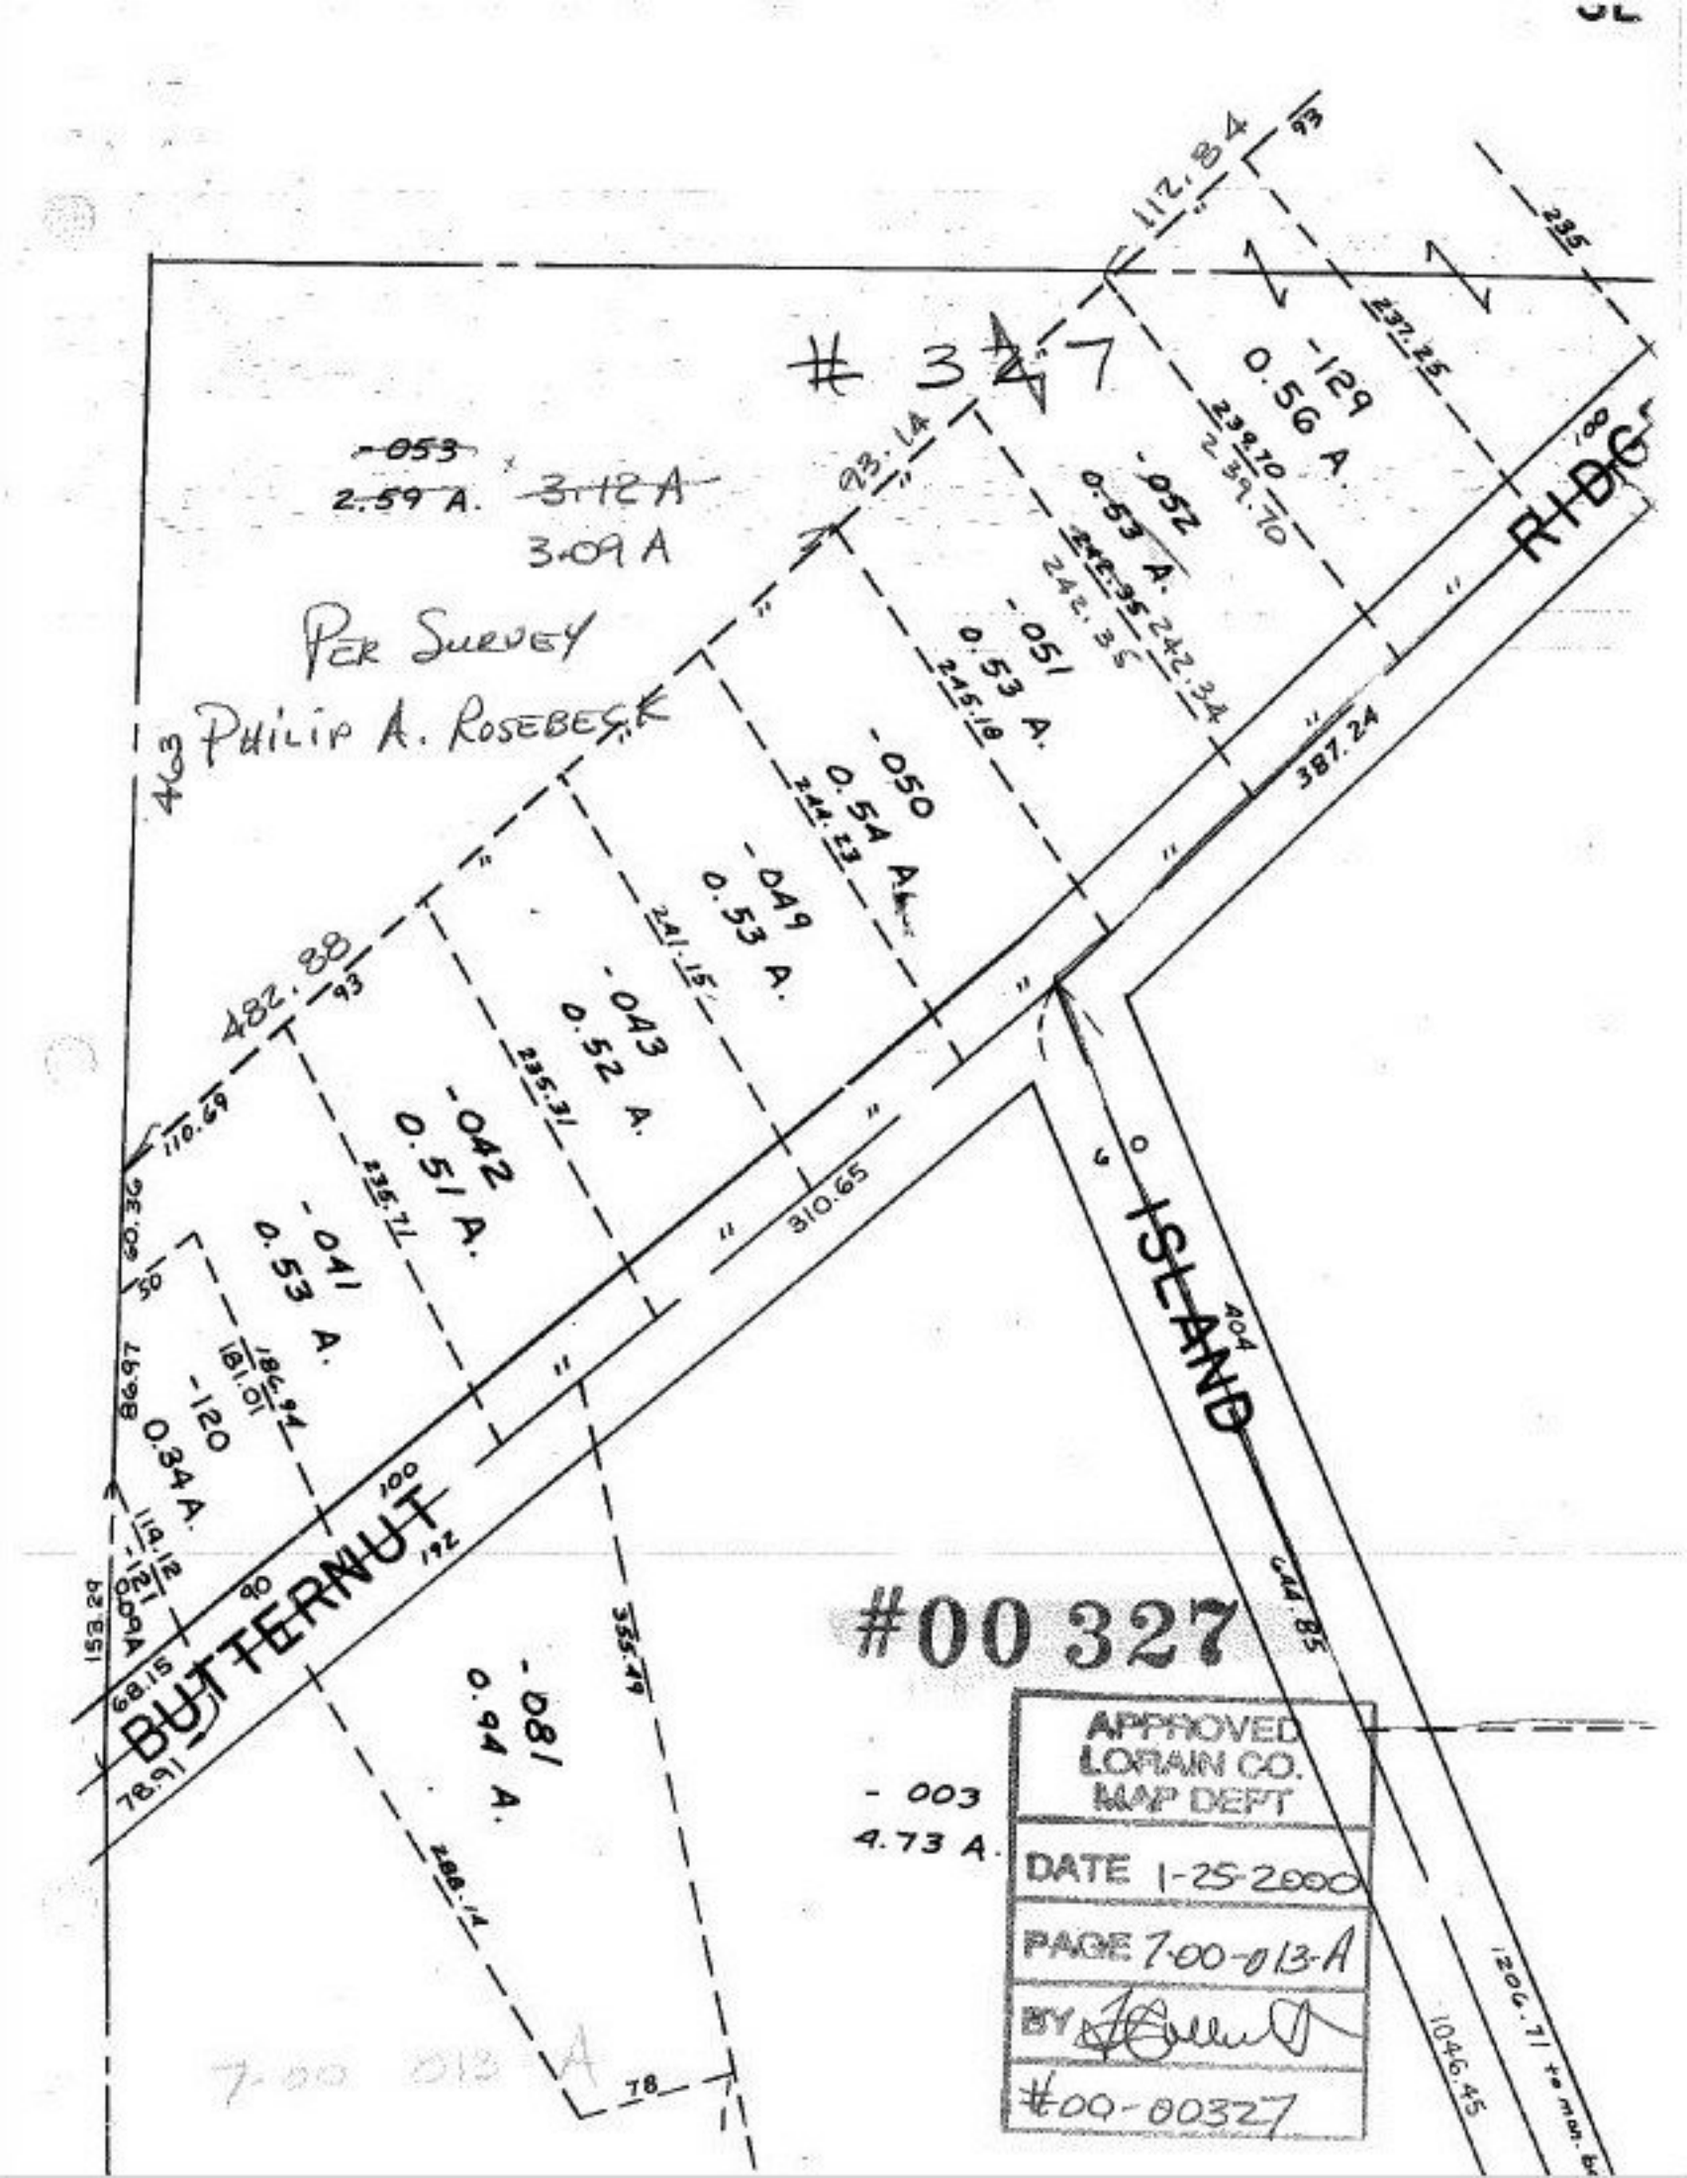
#327
-053
2.59 A.
3.12 A
3.09 A
PER SURVEY
PHILIP A. ROSEBECK
463
-052
0.53 A.
-051
0.53 A.
-050
0.54 A.
-049
0.53 A.
-043
0.52 A.
-042
0.51 A.
-041
0.53 A.
-120
0.34 A.
-081
0.94 A.
-003
4.73 A.
-129
0.56 A.
117.84
93
235
237.25
239.70
239.70
100
93.14
242.34
242.35
242.35
245.18
244.13
241.15
235.31
235.71
387.24
482.88
93
110.69
60.36
50
86.97
181.01
184.94
114.12
112.12
153.29
68.15
78.91
90
100
192
355.49
288.14
78
310.65
404
ISLAND
644.85
1046.45
BUTTERNUT
#00 327
APPROVED
LORAIN CO.
MAP DEPT
DATE 1-25-2000
PAGE 7-00-013-A
BY
#00-00327
7-00 013 A