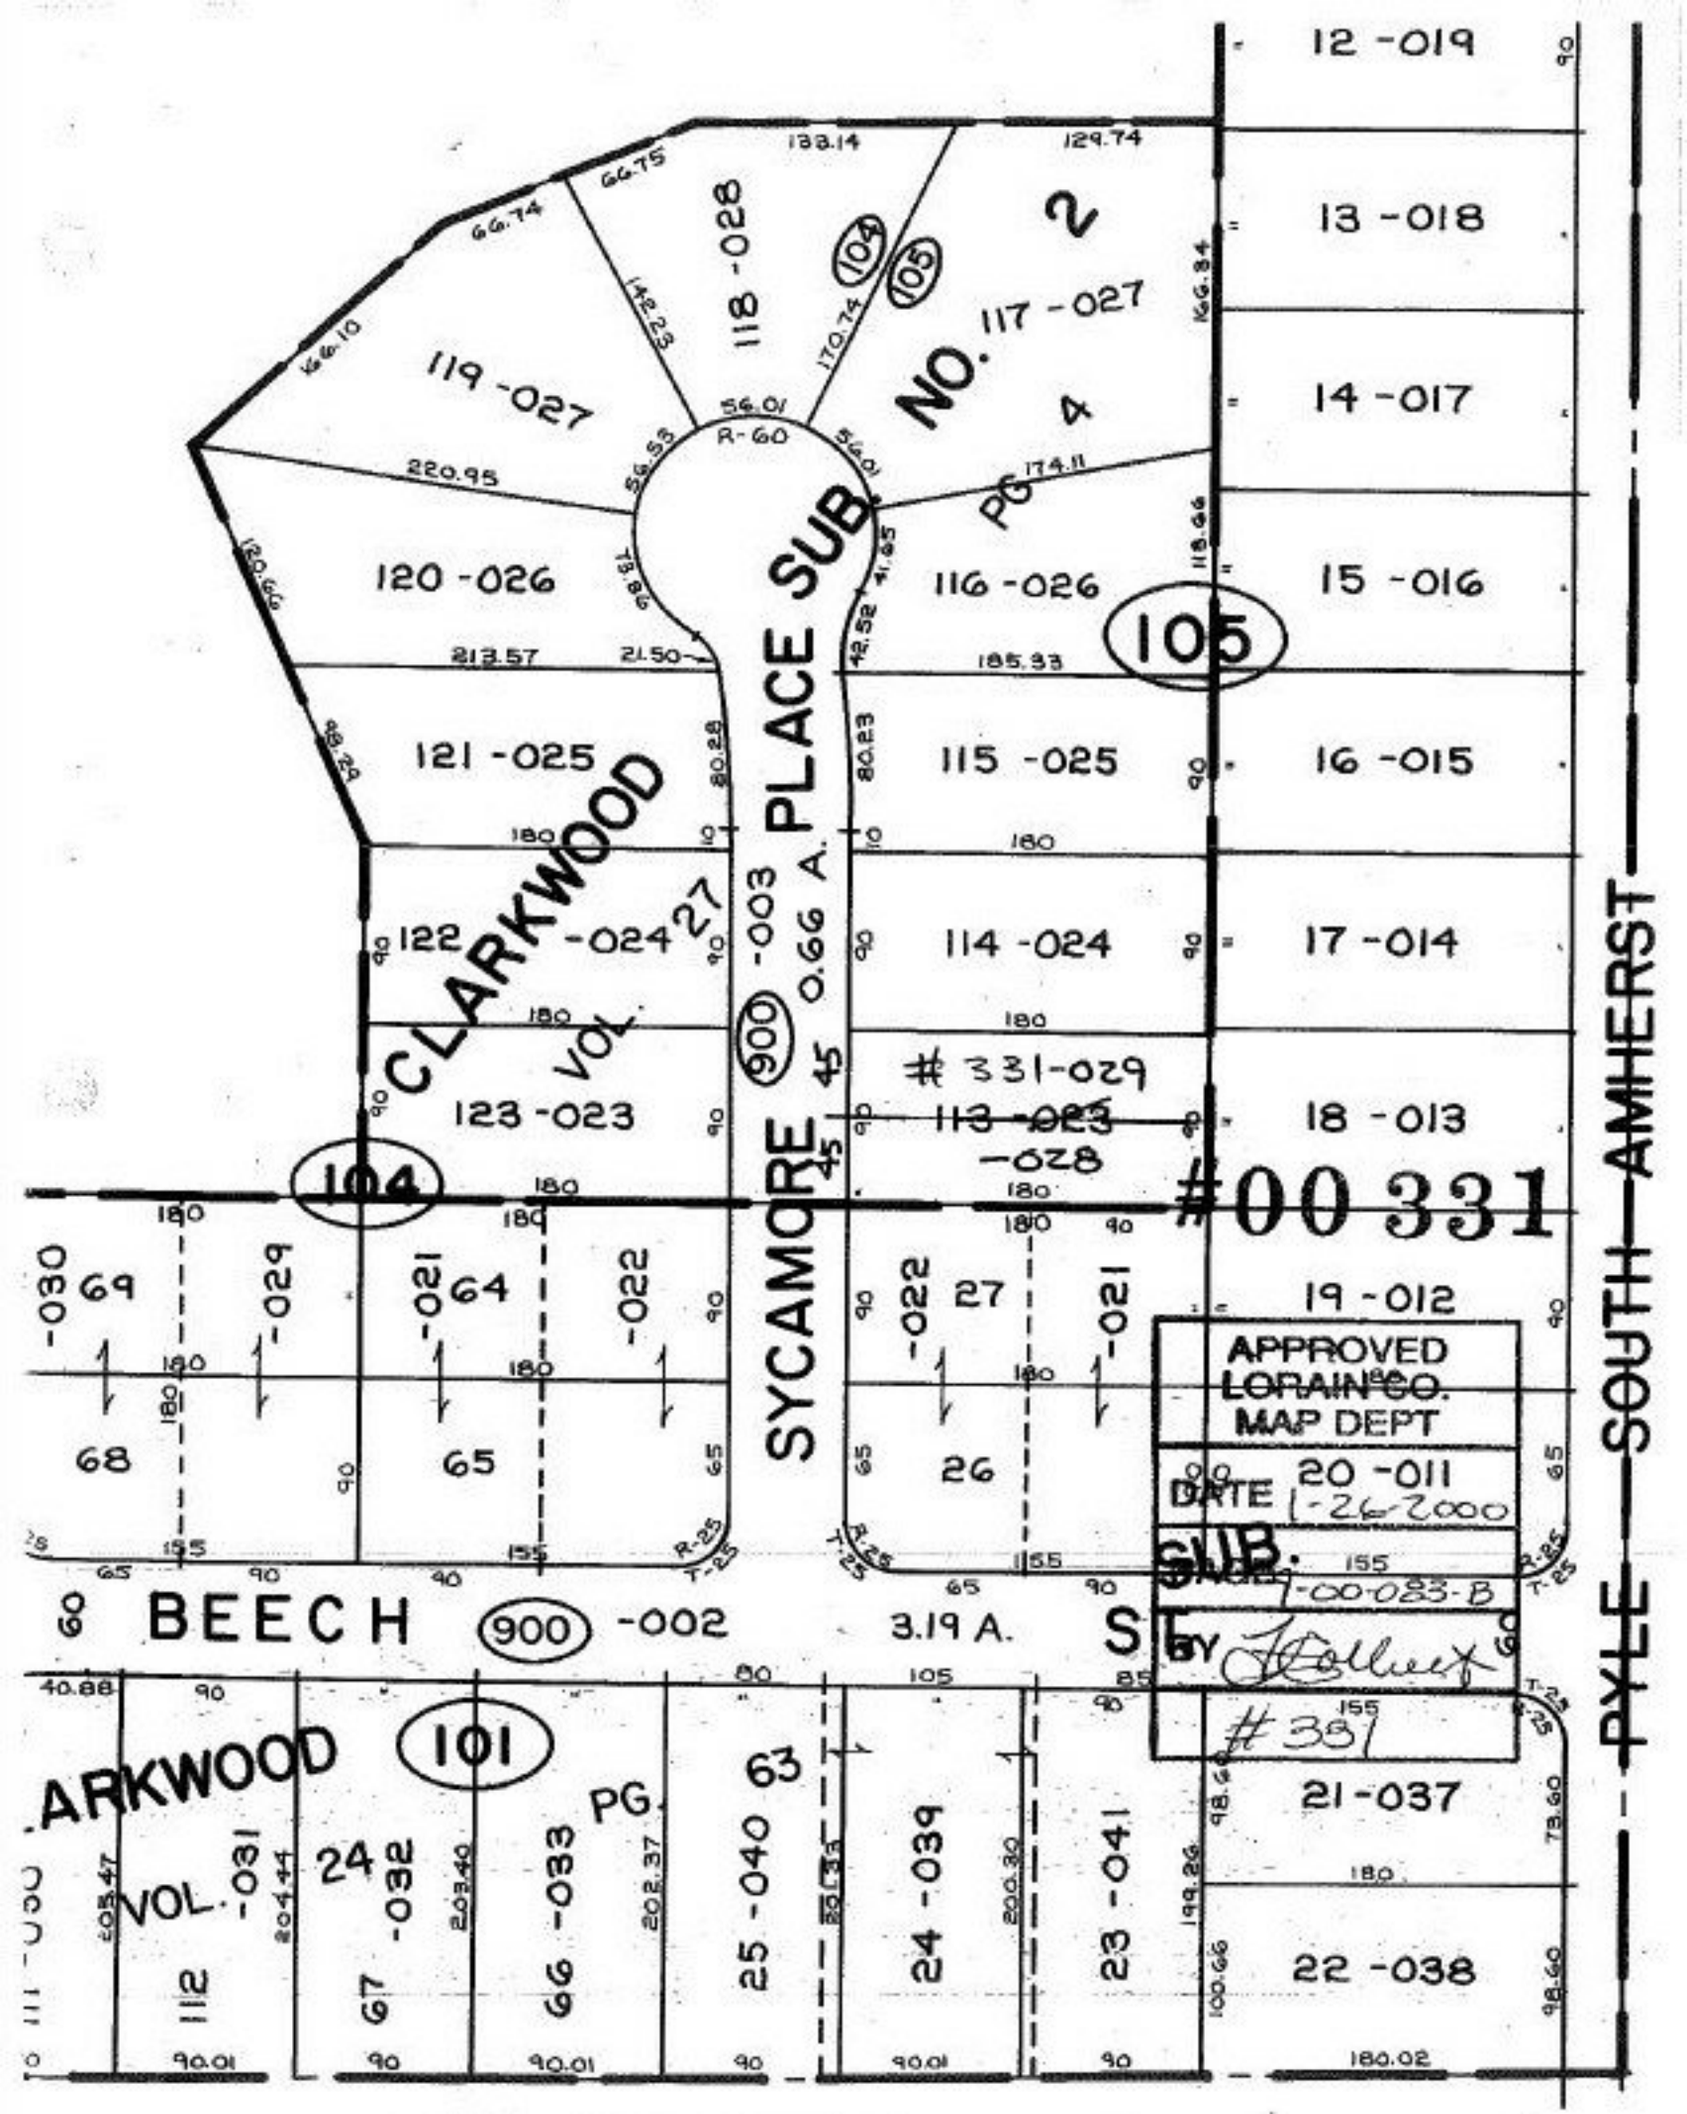
12 -019
13 -018
14 -017
15 -016
16 -015
17 -014
18 -013
19 -012
20 -011
21 -037
22 -038
23 -041
24 -039
25 -040
66 -033
67 -032
112 -031
68
69 -030
-029
65
64 -021
-022
26
27 -022
-021
119 -027
120 -026
121 -025
122 -024
123 -023
118 -028
117 -027
116 -026
115 -025
114 -024
113 -023
-028
#331-029
#00331
CLARKWOOD PLACE SUB. NO. 2
VOL. 27 PG. 63
SYCAMORE
900 -003 0.66 A.
900 -002 3.19 A.
BEECH
CLARKWOOD
VOL.
PG.
104
105
101
R-60
R-25
APPROVED
LORAIN CO.
MAP DEPT
DATE 1-26-2000
SUB.
STUDY 00-083-B
BY
#381
PYLE — SOUTH — AMHERST