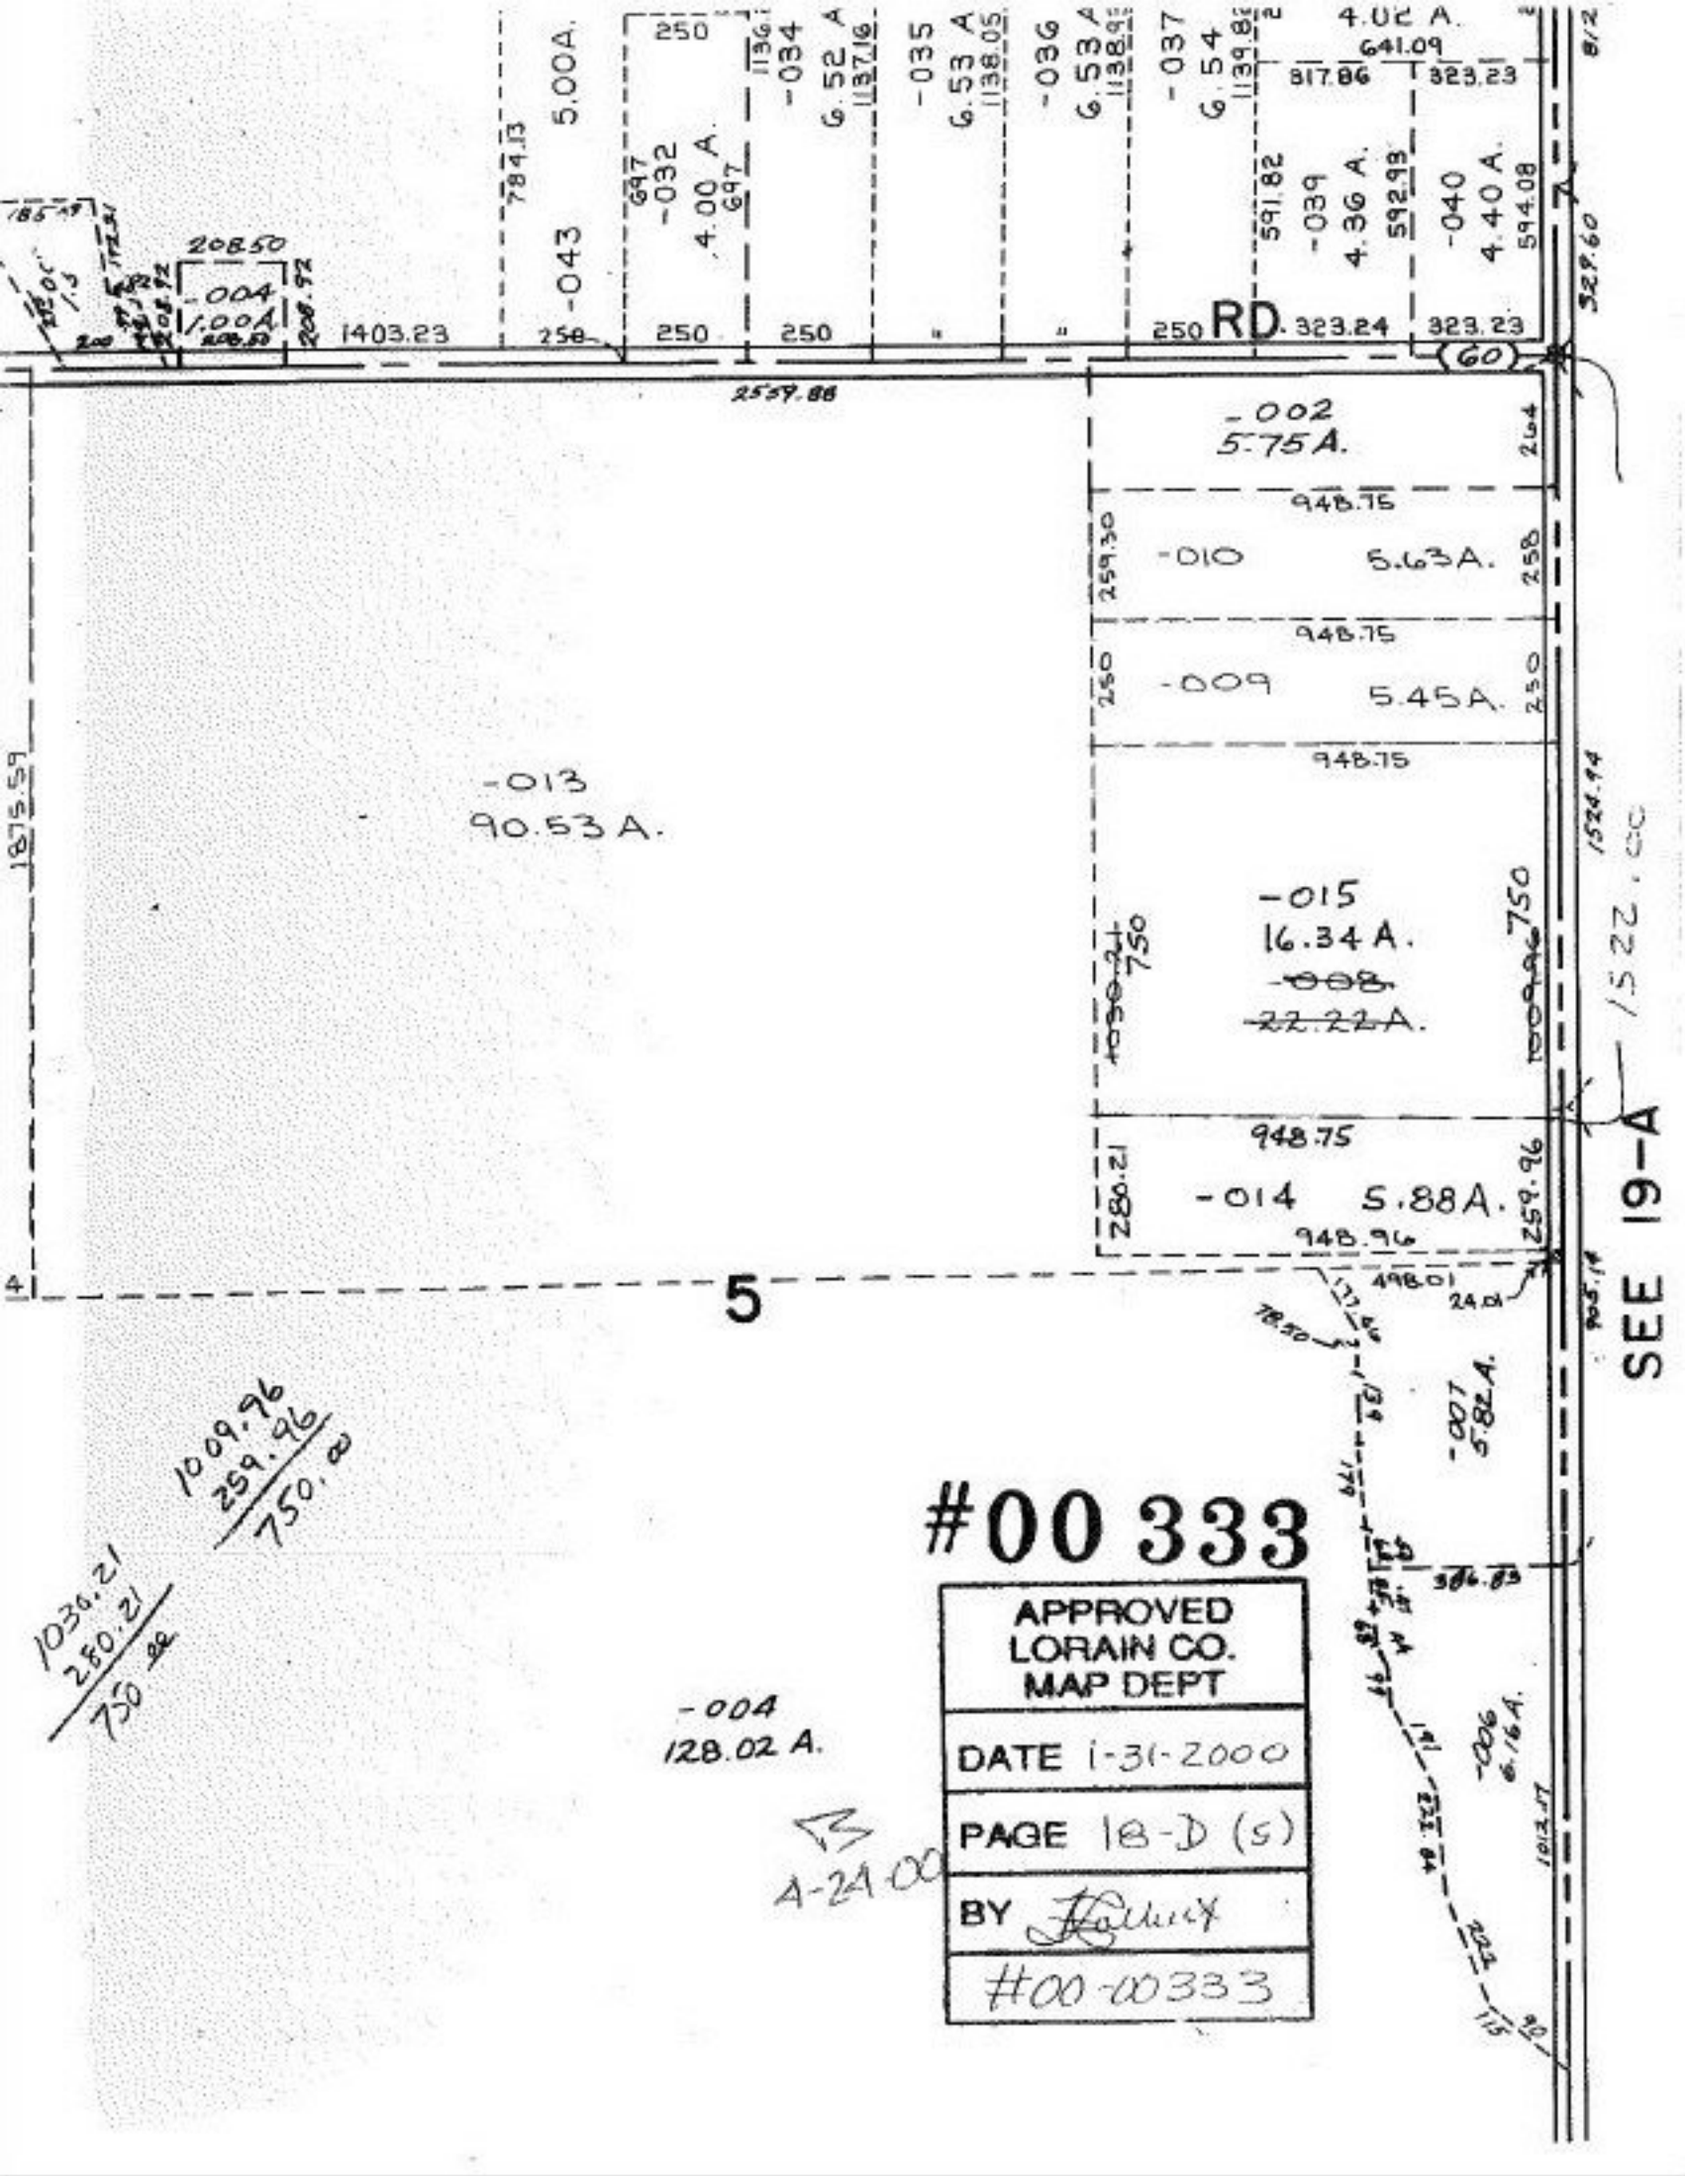
-043
5.00A.
784.13
-032
4.00 A.
697
-034
6.52 A.
1137.16
-035
6.53 A.
1138.05
-036
6.53 A.
1138.95
-037
6.54
1139.85
-039
4.36 A.
592.98
-040
4.40 A.
594.08
591.82
817.86
641.09
323.23
328.60
-004
1.00A.
208.92
208.50
1403.23
250
250
250
250
323.24
323.23
RD.
60
2539.88
-002
5.75A.
948.75
-010
5.63A.
259.30
258
-009
5.45A.
250
-013
90.53 A.
1875.59
-015
16.34 A.
-008
22.22A.
1030.21
750
1009.96
750
1524.14
15 22. 00
948.75
-014
5.88A.
280.21
259.96
948.96
5
498.01
24.01
78.50
-007
5.82A.
386.83
-006
6.16A.
1013.17
SEE 19-A
1009.96
259.96
750.00
1030.21
280.21
750.00
-004
128.02 A.
A-2400
#00 333
APPROVED
LORAIN CO.
MAP DEPT
DATE 1-31-2000
PAGE 18-D (5)
BY
#00-00333