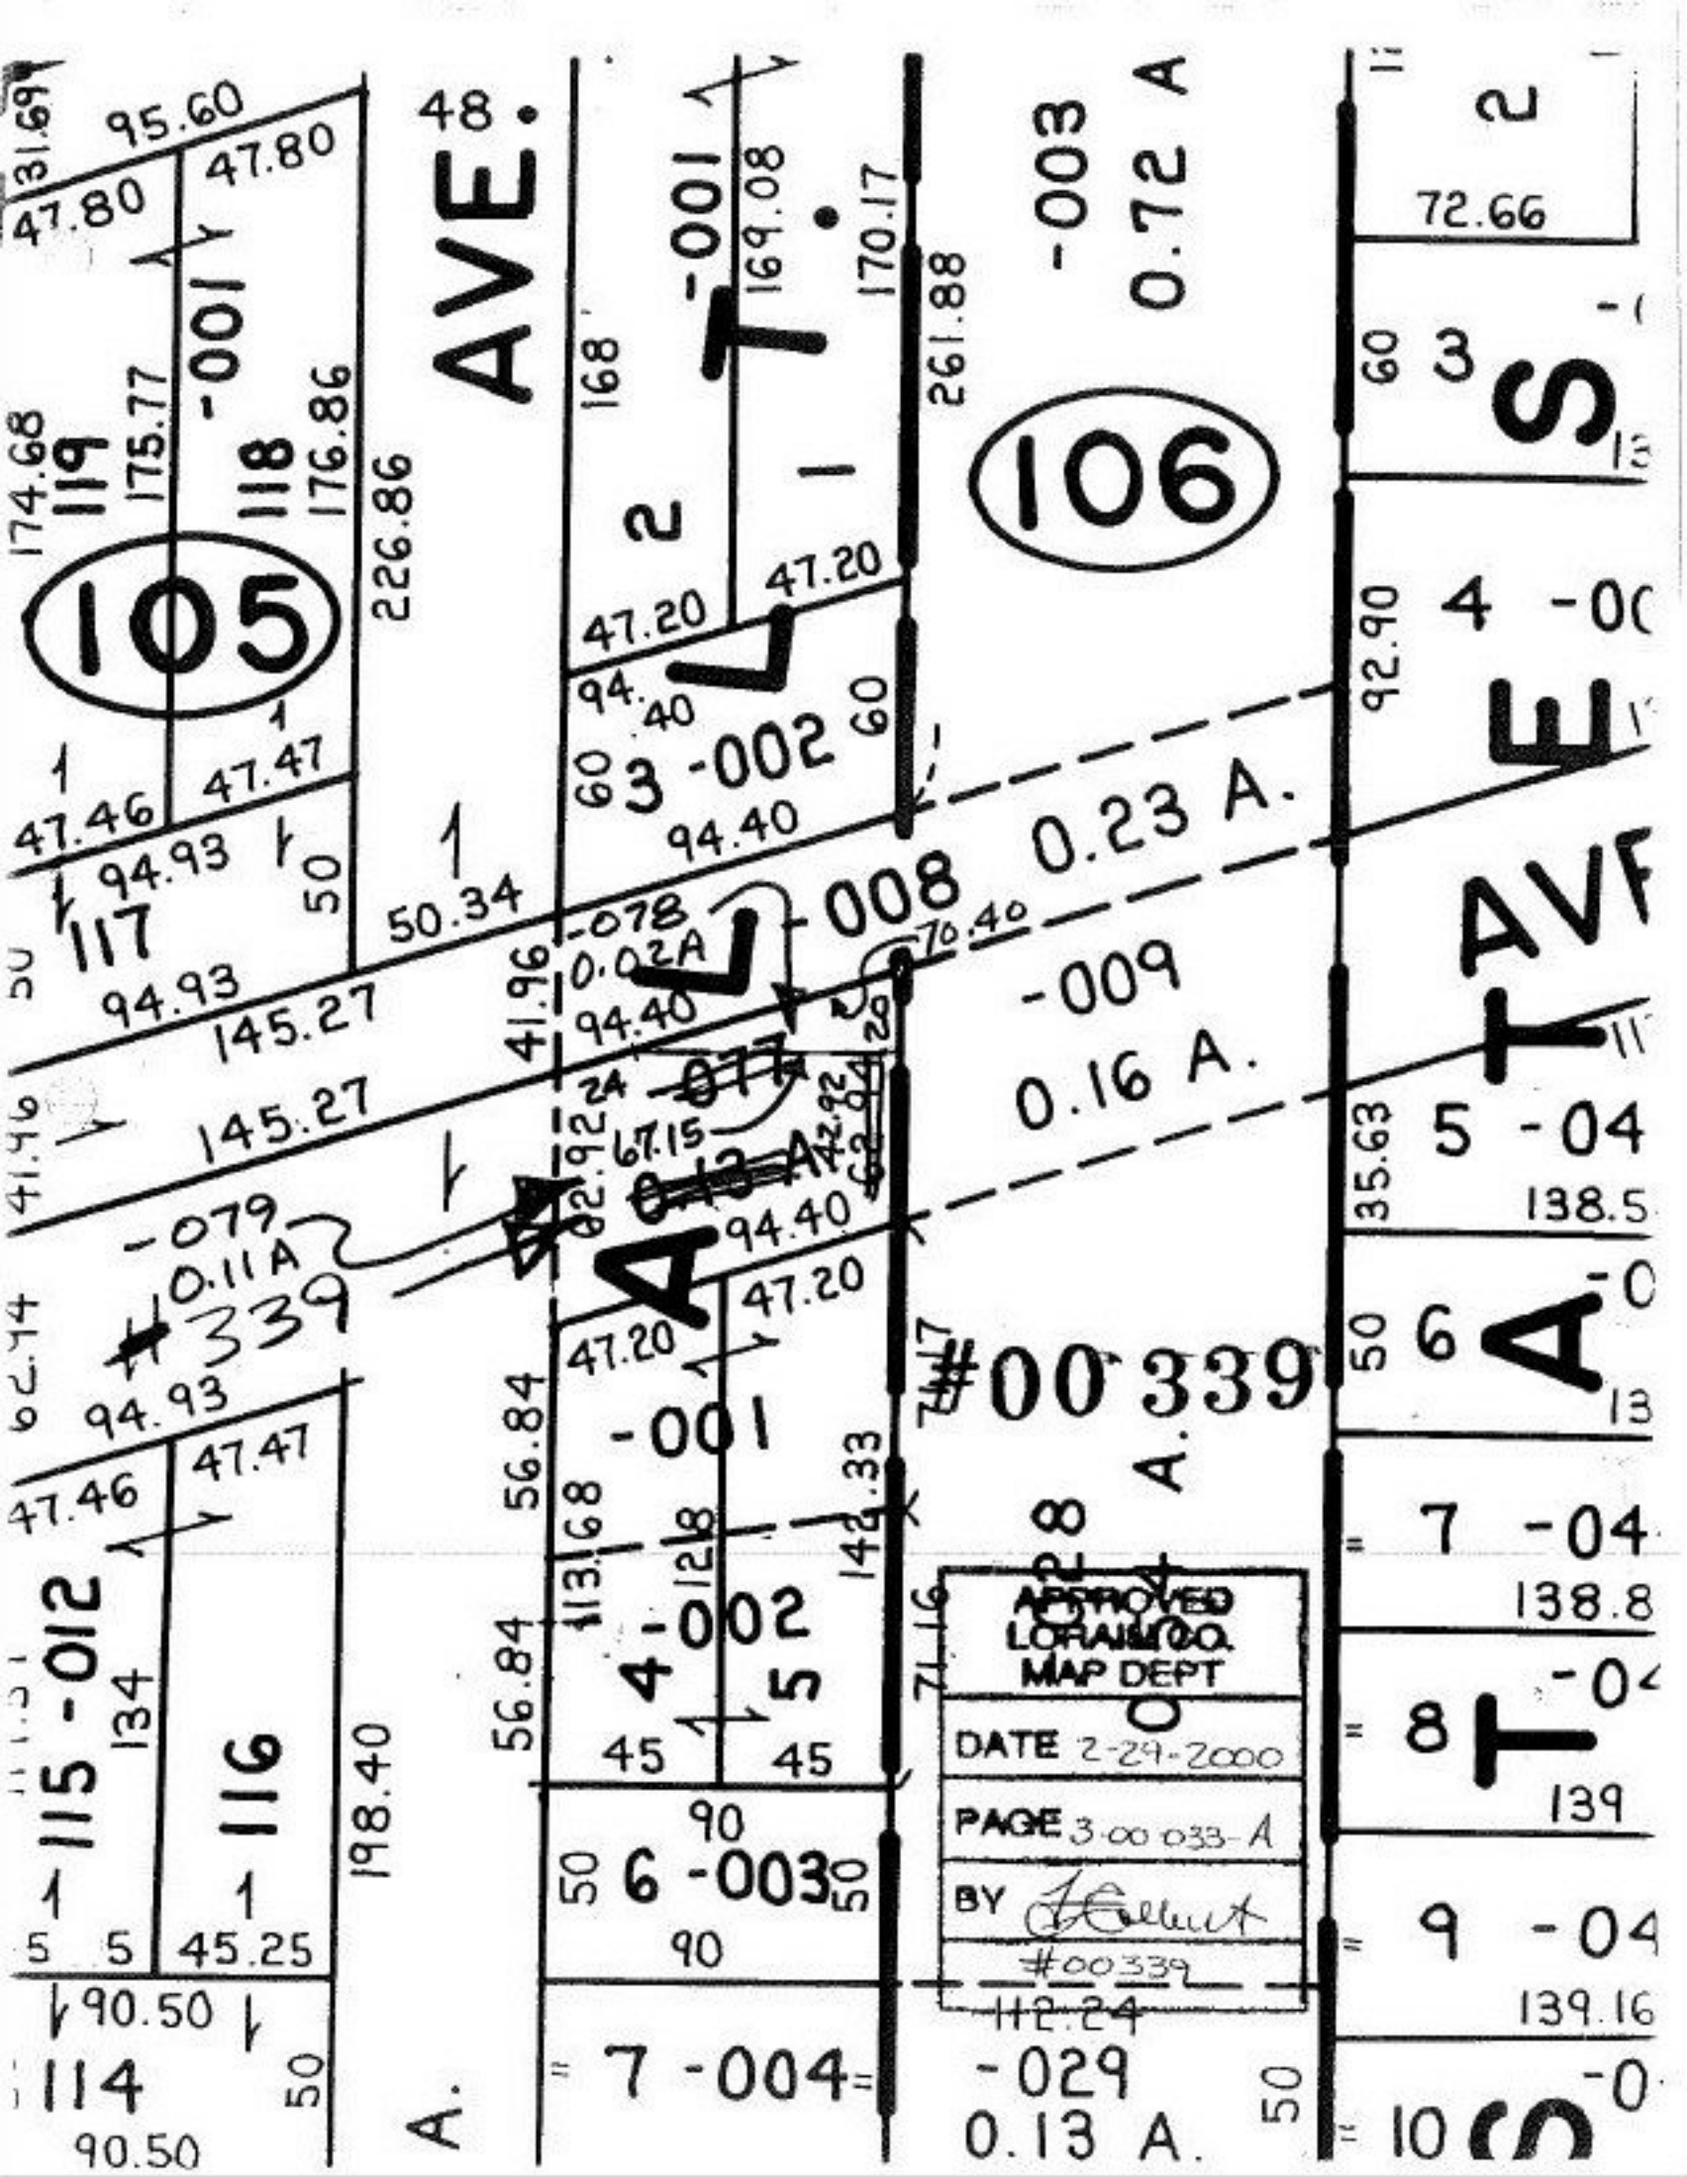

105
106
AVE.
AVE
#00 339
#339
APPROVED
LORAIN CO.
MAP DEPT
DATE 2-29-2000
PAGE 3-00-033-A
BY
#00339