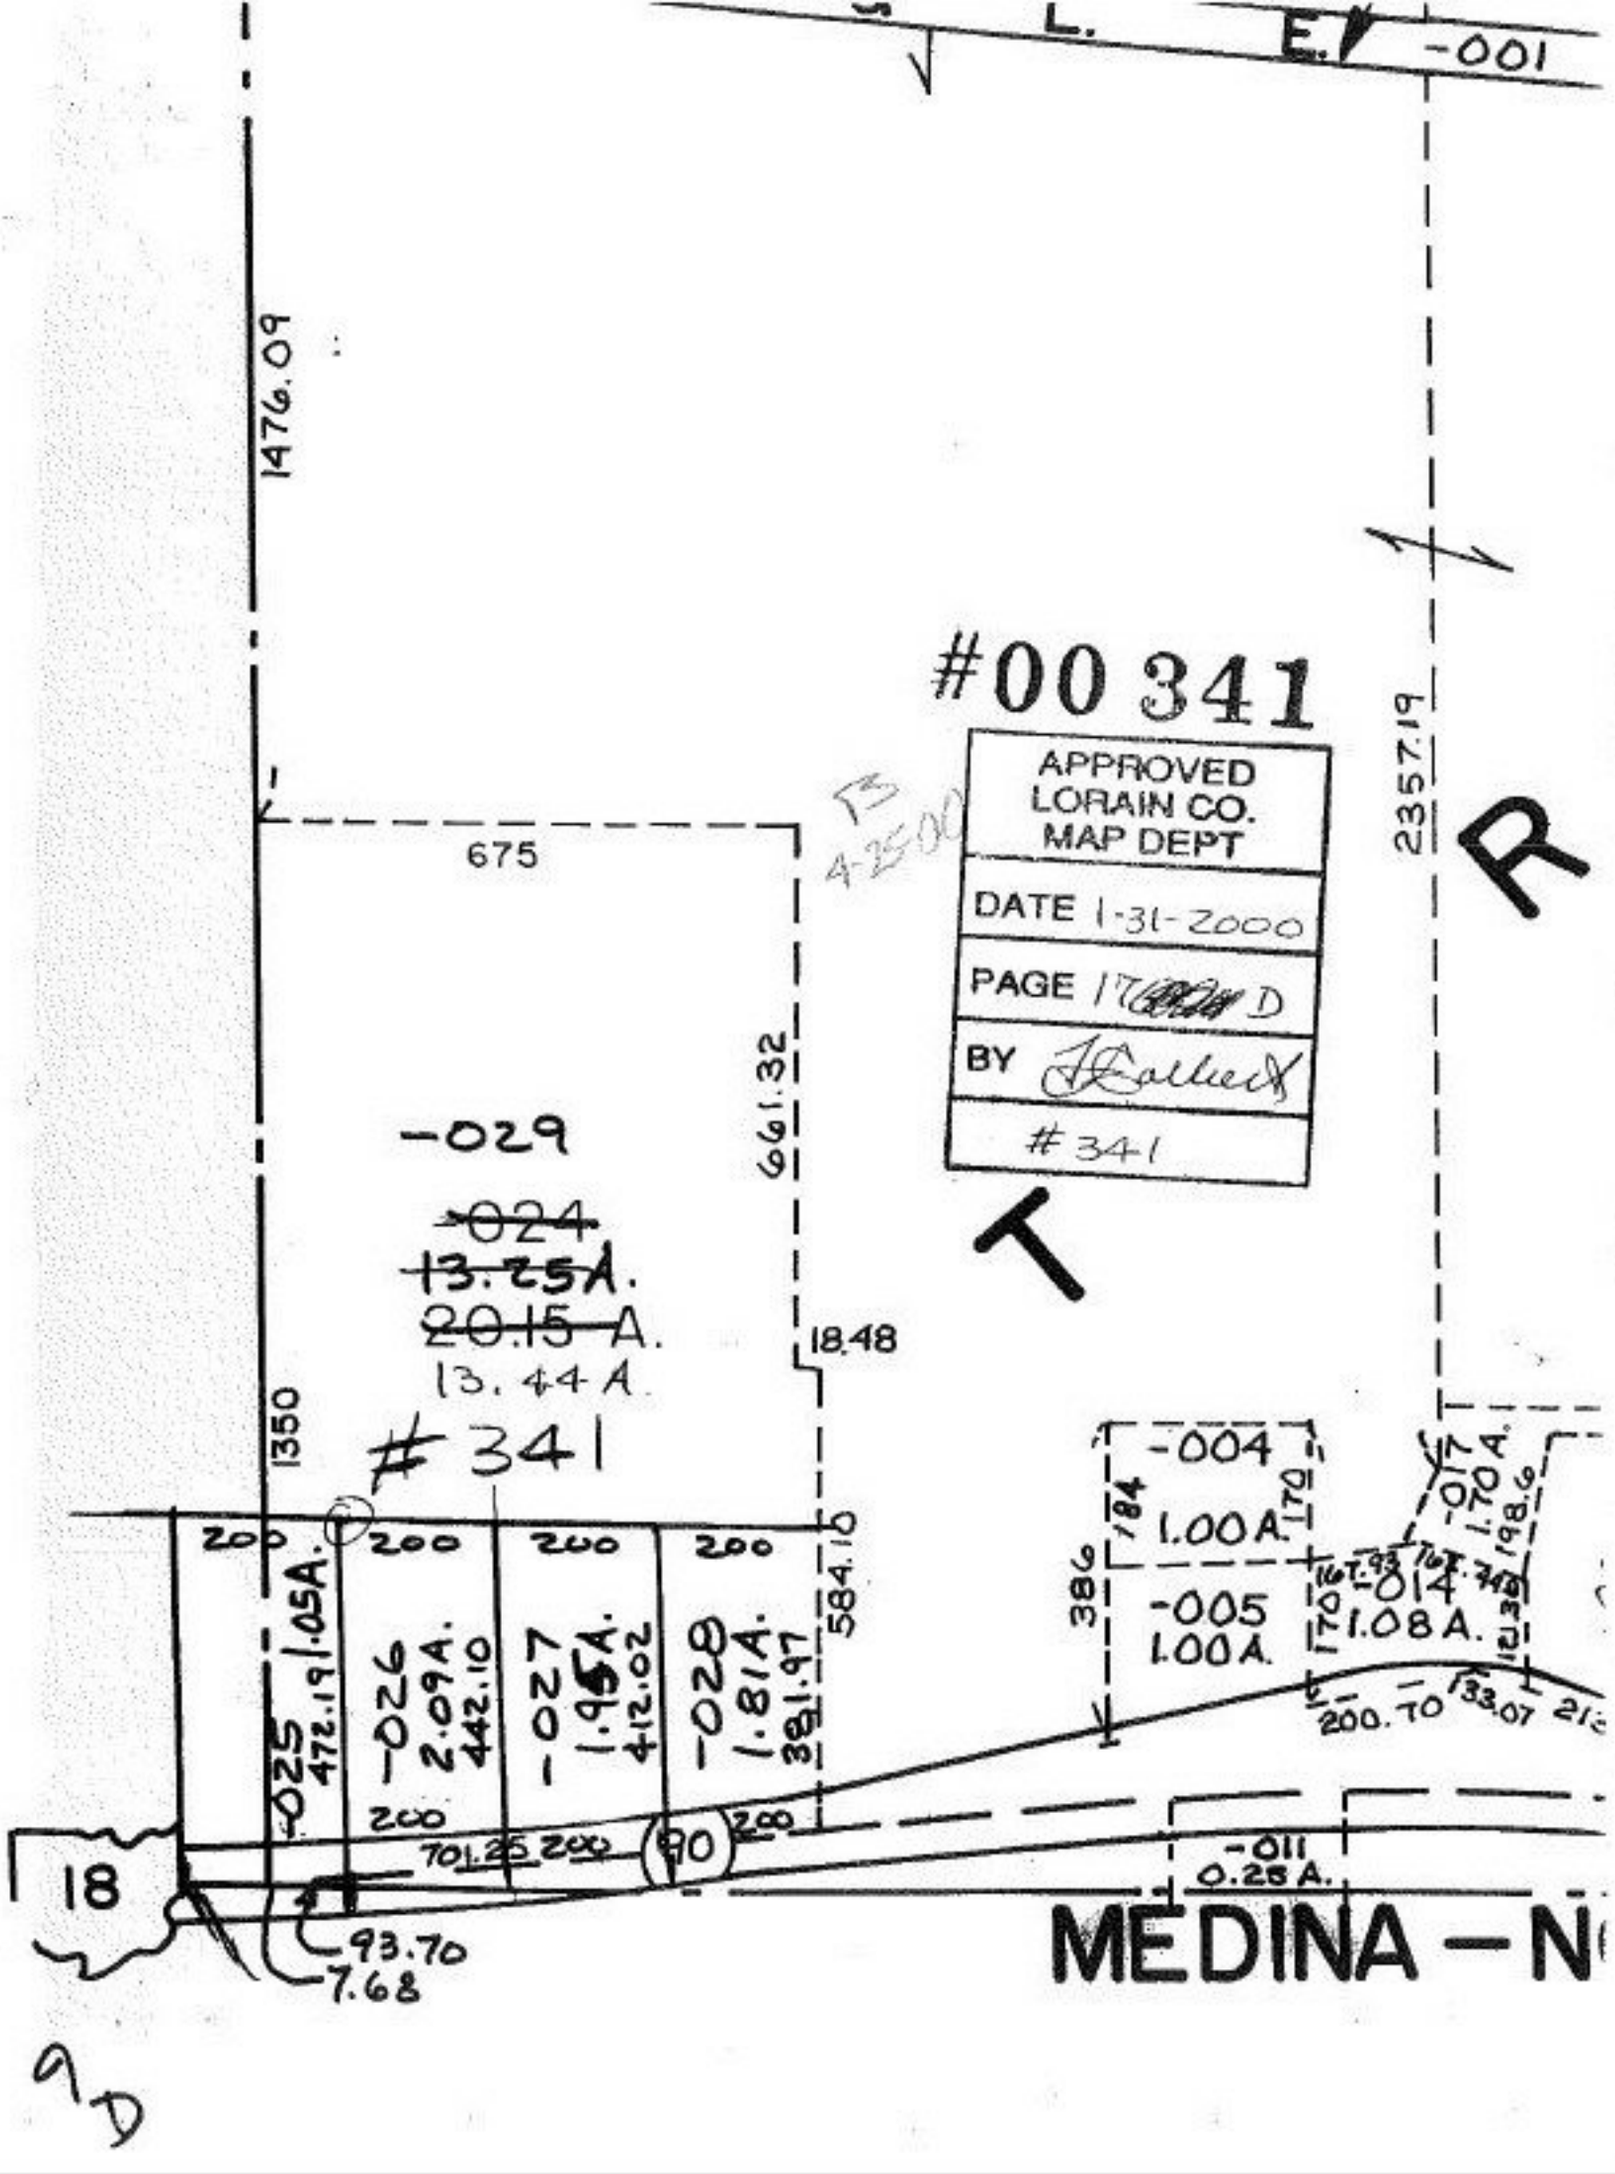
#00 341
APPROVED
LORAIN CO.
MAP DEPT
DATE 1-31-2000
PAGE 17 D
BY
#341
1476.09
675
661.32
2357.19
-029
-024
13.25A.
20.15 A.
13.44 A.
#341
1350
18.48
584.10
-025
1.05A.
472.19
-026
2.09A.
442.10
-027
1.95A.
412.02
-028
1.81A.
391.97
200
200
200
200
-004
1.00A.
-005
1.00A.
-014
1.08A.
-017
1.70A.
386
184
170
198.6
200.70
133.07
-011
0.25 A.
18
90
93.70
7.68
MEDINA – N
9D