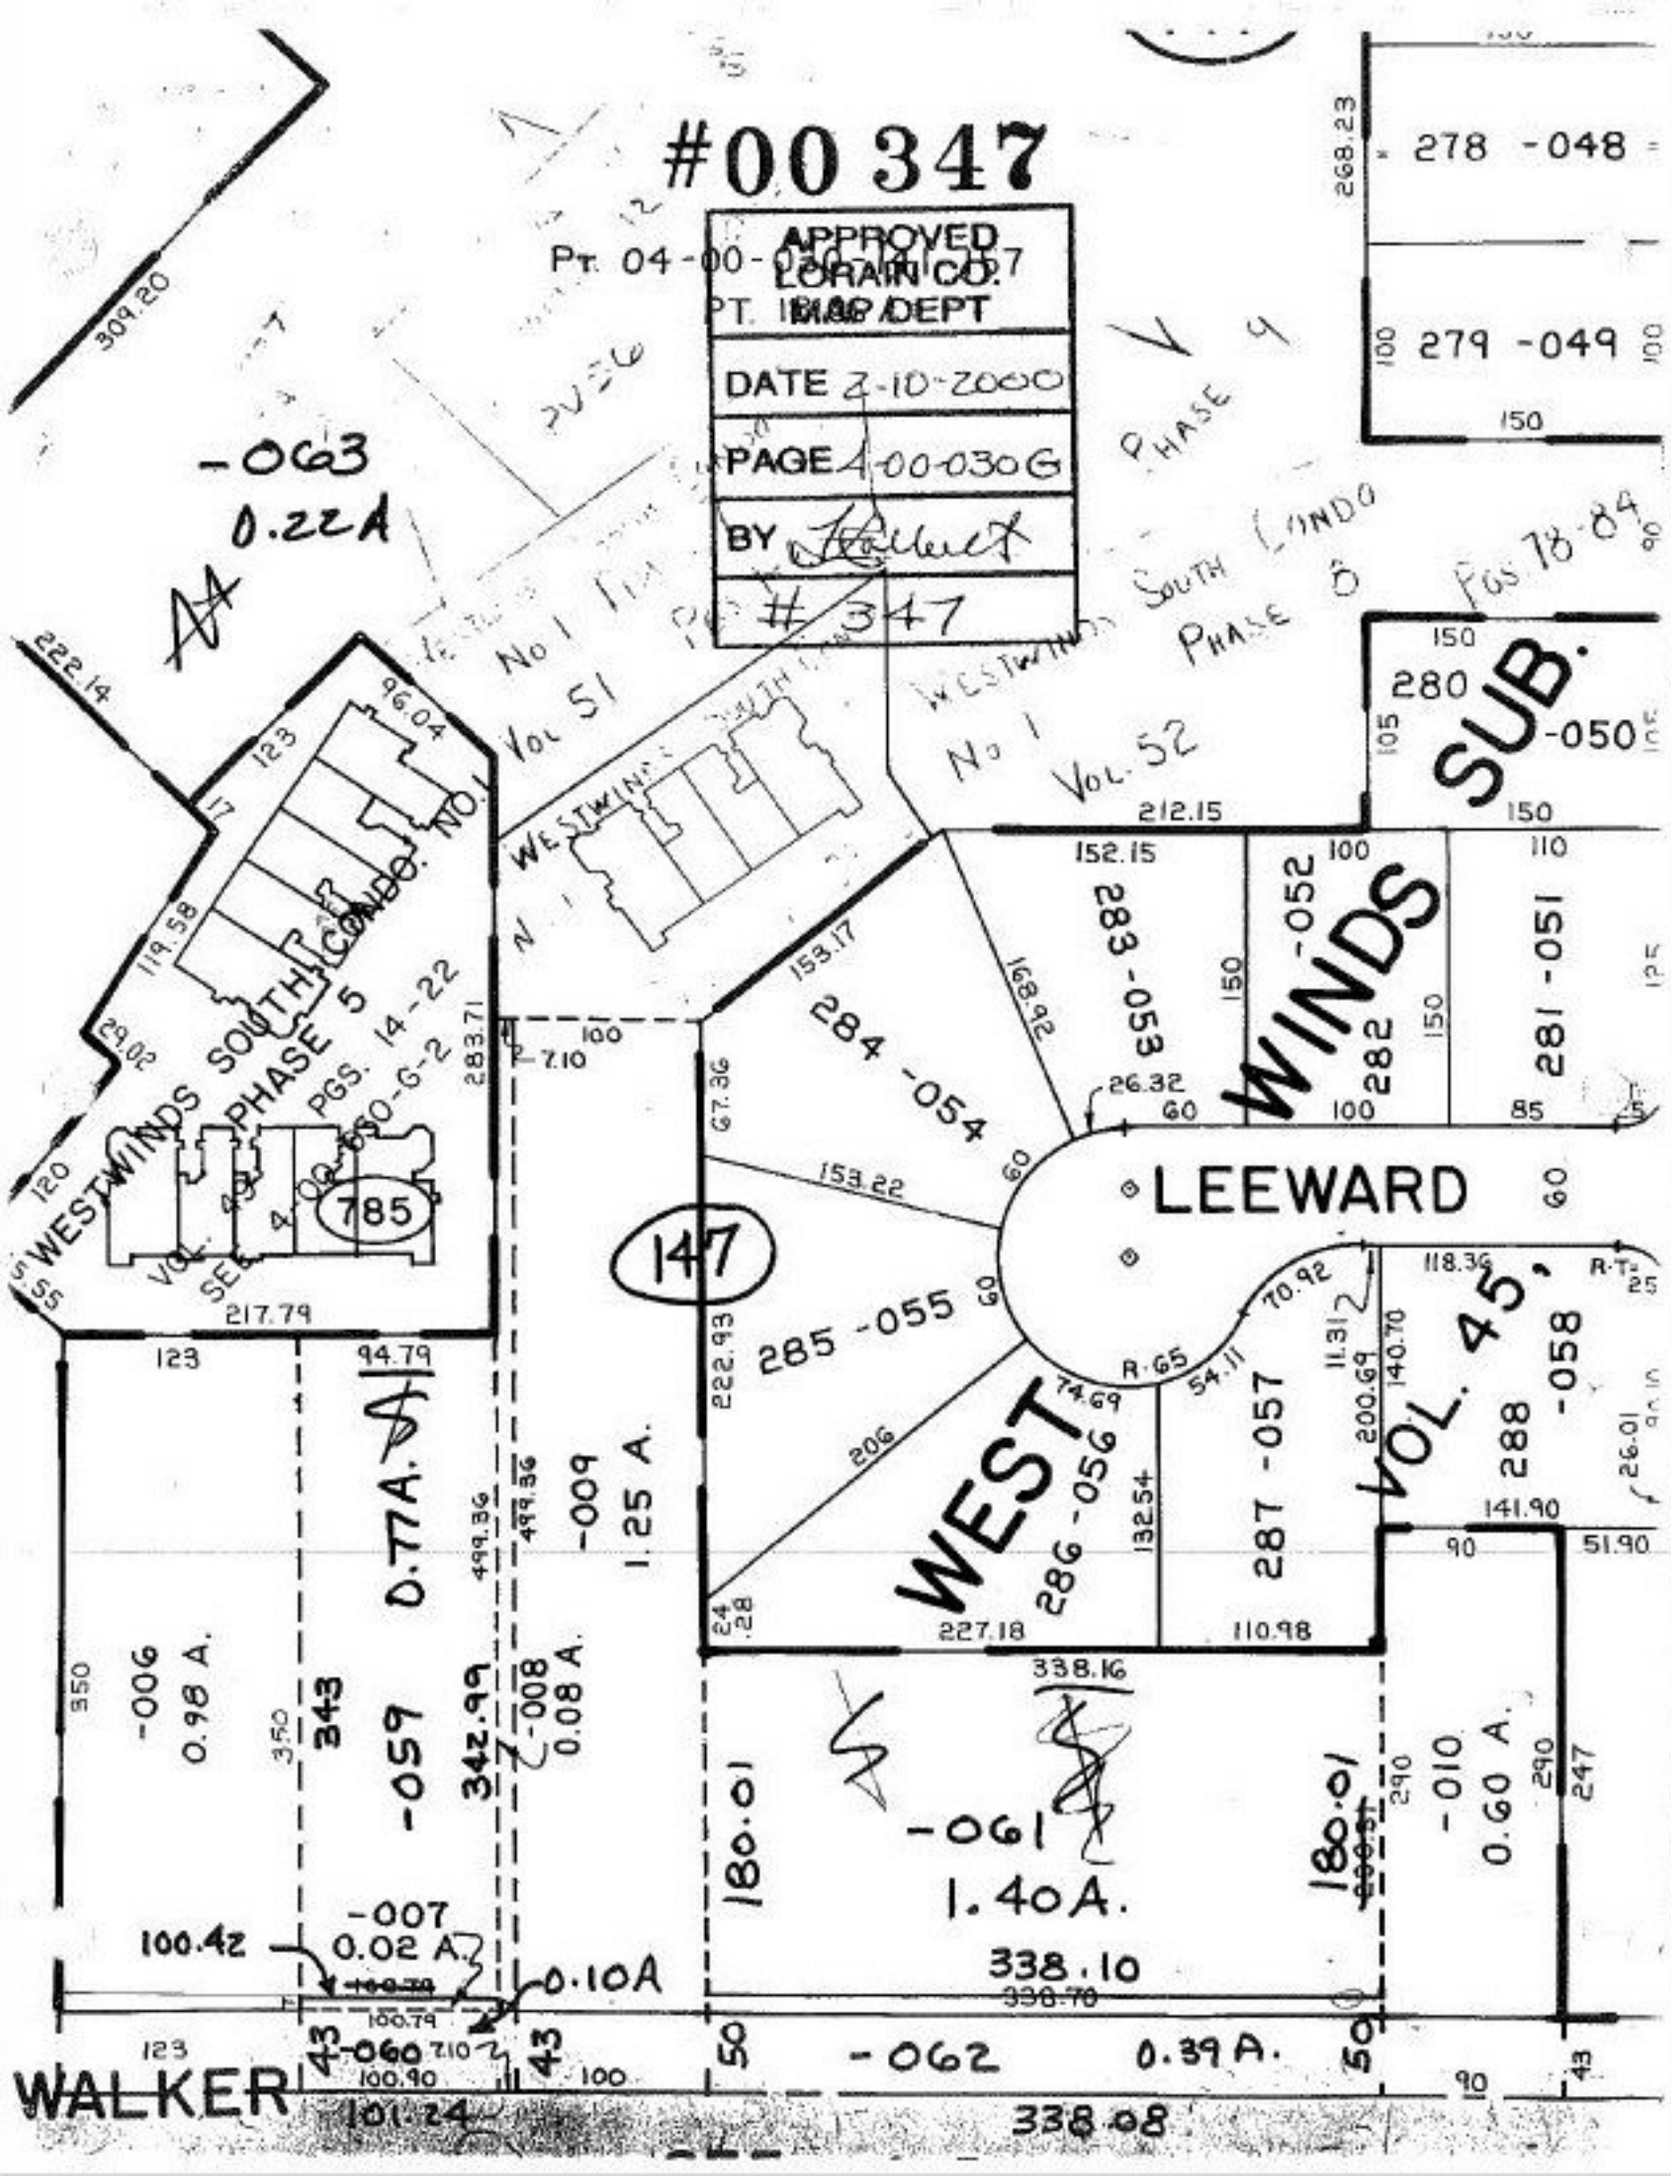
#00 347
APPROVED
LORAIN CO.
MAP DEPT
DATE 2-10-2000
PAGE 4-00-030G
BY
347
-063
0.22A
WESTWINDS SOUTH CONDO. NO. 1
PHASE 5
PGS. 14-22
785
147
LEEWARD
WEST WINDS SUB.
VOL. 45
WESTWINDS SOUTH CONDO
PHASE 8
PGS 78-84
No 1
Vol. 51
Vol. 52
278 -048
279 -049
280 -050
281 -051
282 -052
283 -053
284 -054
285 -055
286 -056
287 -057
288 -058
-009
1.25 A.
-006
0.98 A.
343
-059
0.77A.
342.99
-008
0.08 A.
-007
0.02 A.
100.42
0.10A
-060
-061
1.40A.
180.01
-010
0.60 A.
338.10
-062
0.39 A.
338.08
101.24
WALKER