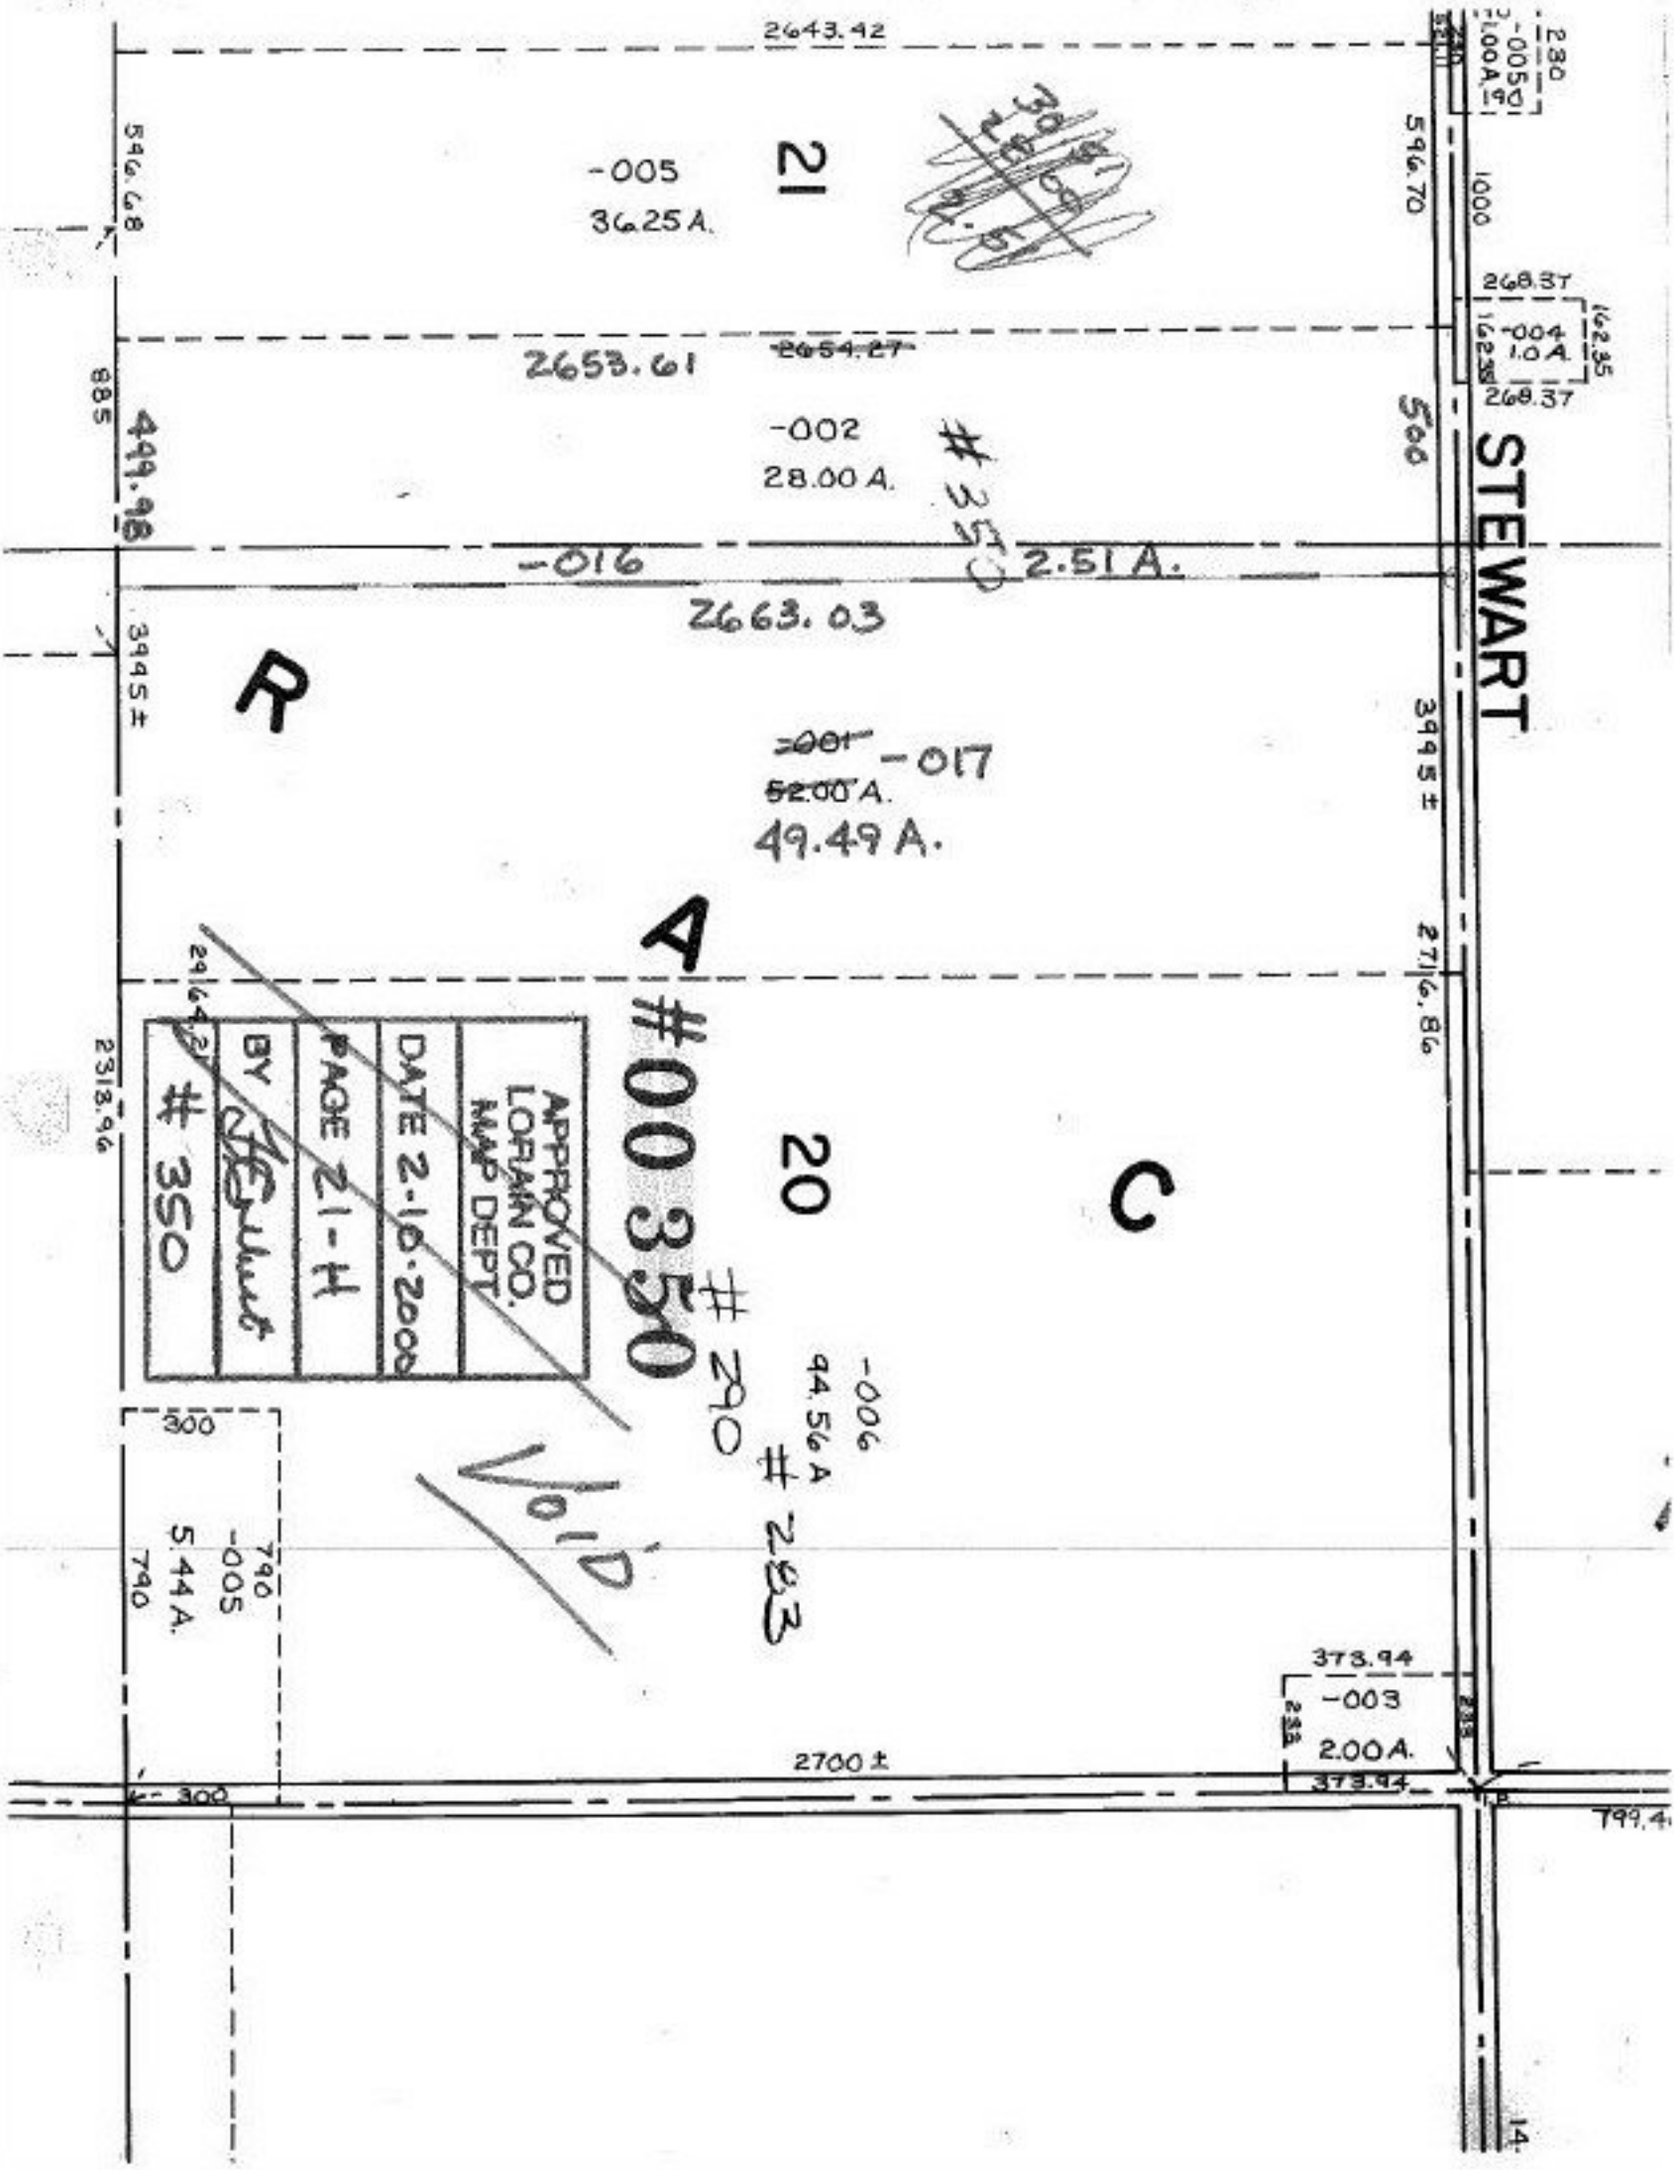

2643.42
-005
36.25 A.
21
596.68
596.70
1000
268.37
-004
1.0 A.
162.35
268.37
2653.61
~~2654.27~~
885
499.98
-002
28.00 A.
500
STEWART
-016
2.51 A.
2663.03
3995±
R
~~-001~~ -017
~~52.00~~ A.
49.49 A.
3995±
A
2716.86
2313.96
APPROVED
LORAIN CO.
MAP DEPT.
DATE 2-10-2000
PAGE 21-H
BY
350
#00350
20
C
290
-006
94.56 A
283
Void
300
790
-005
5.44 A.
790
373.94
-003
2.00 A.
373.94
2700±
300
799.4