SEE 5-00-018-

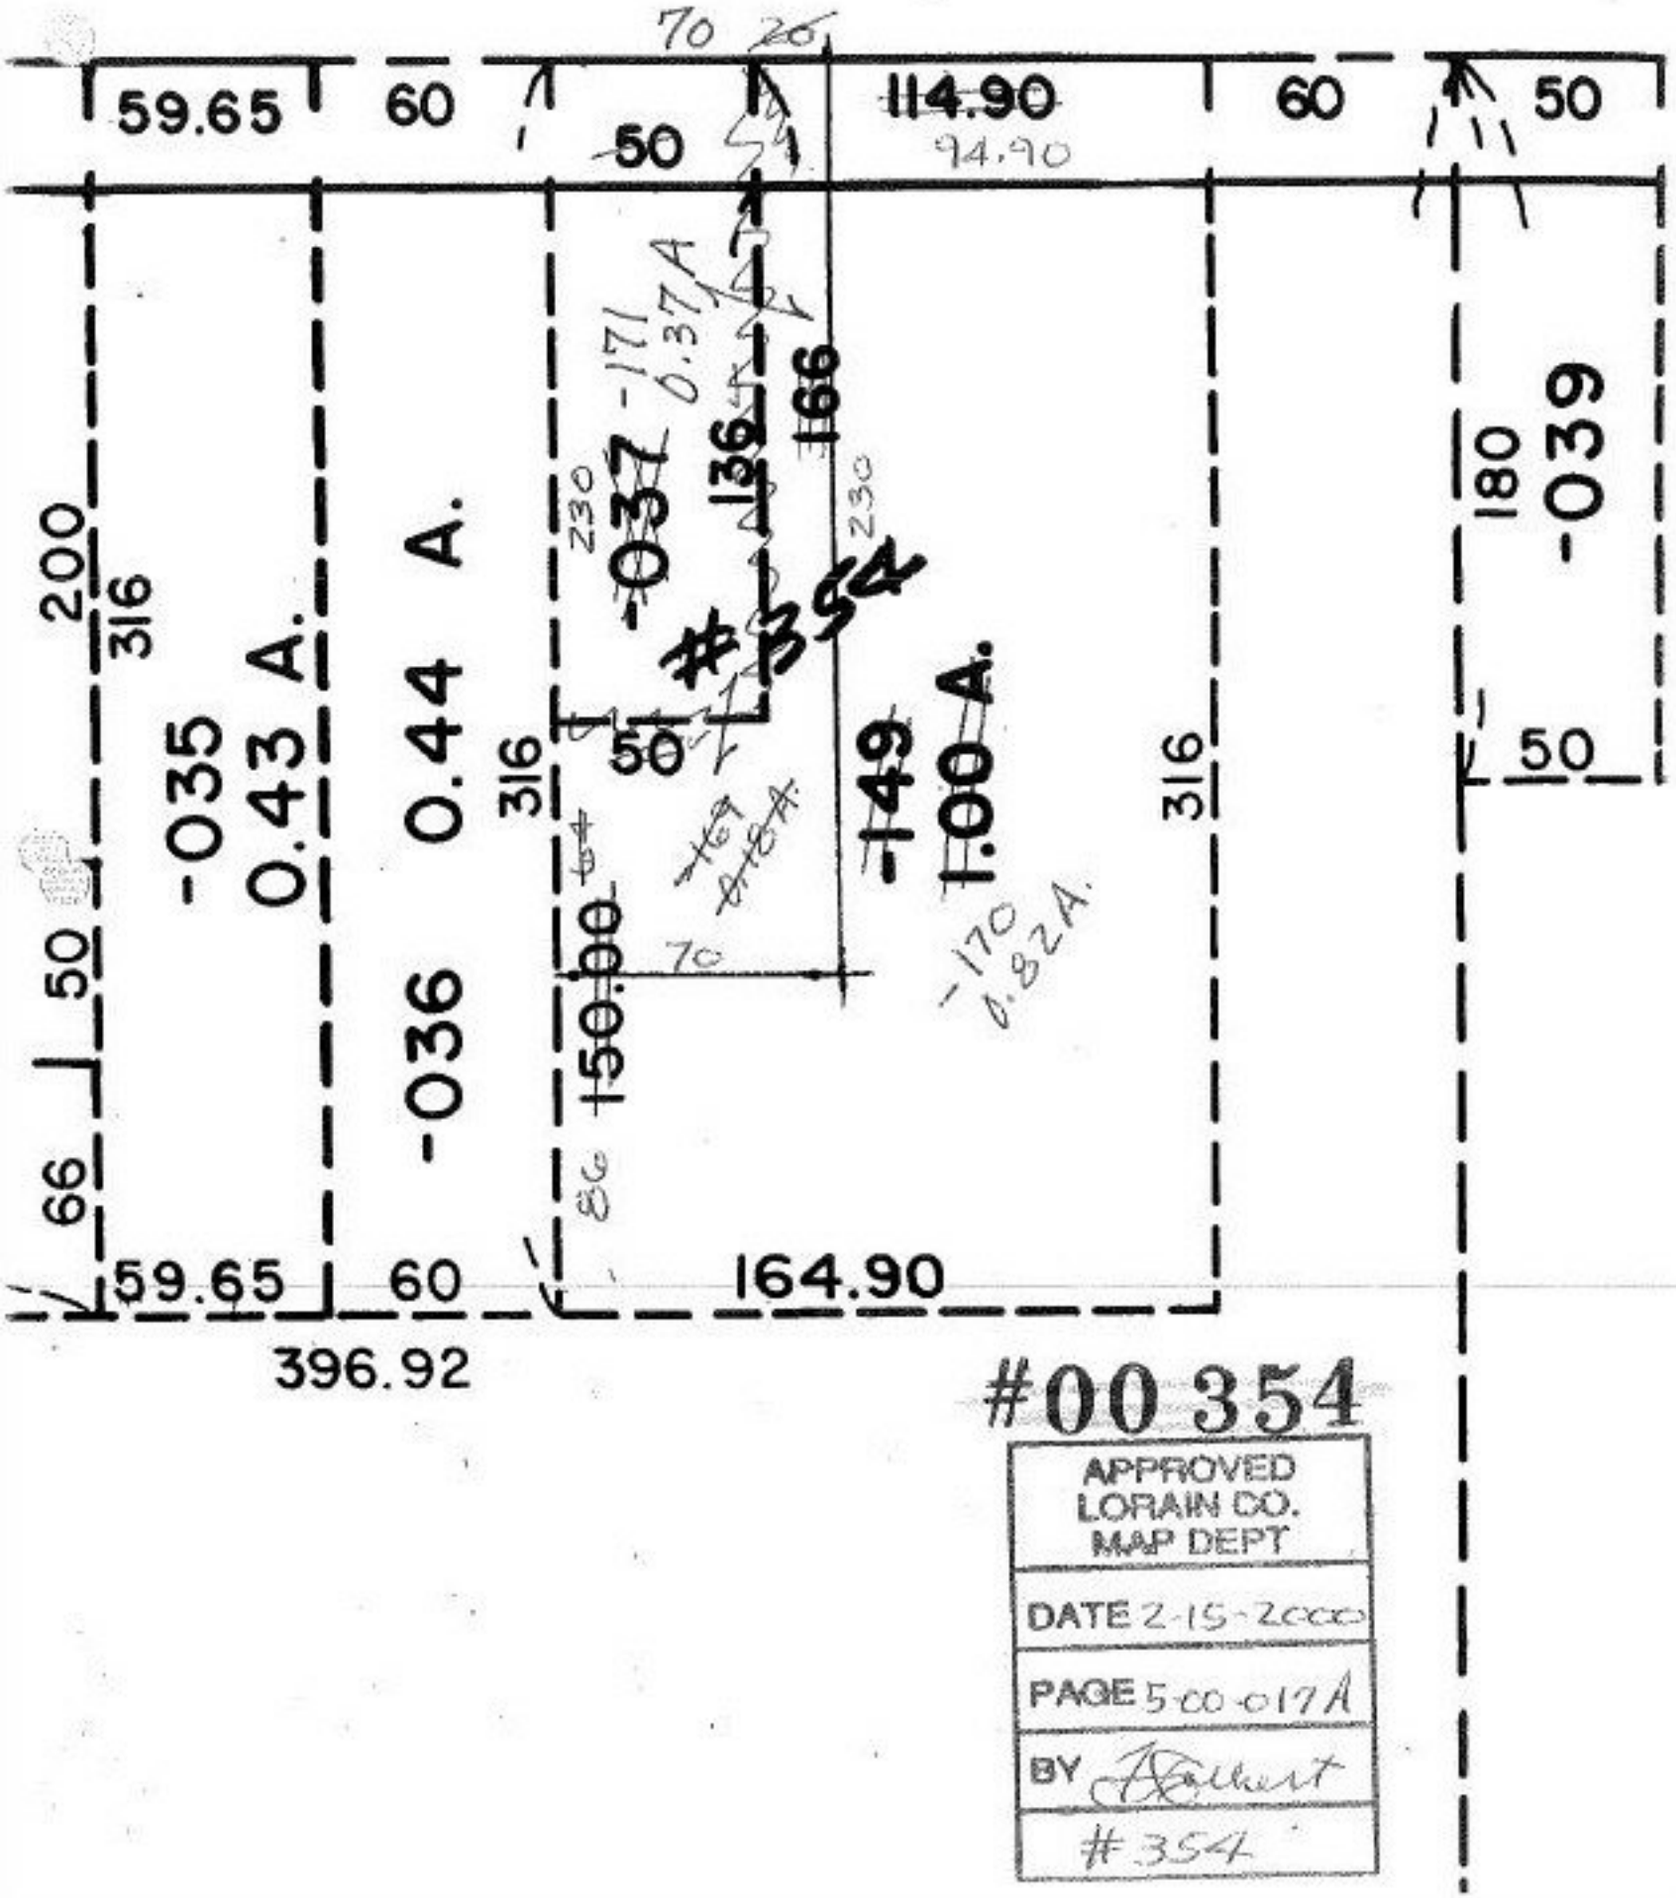

#00354

APPROVED LORAIN CO. MAP DEPT
DATE 2-15-2000
PAGE 5-00-017A
BY
#354