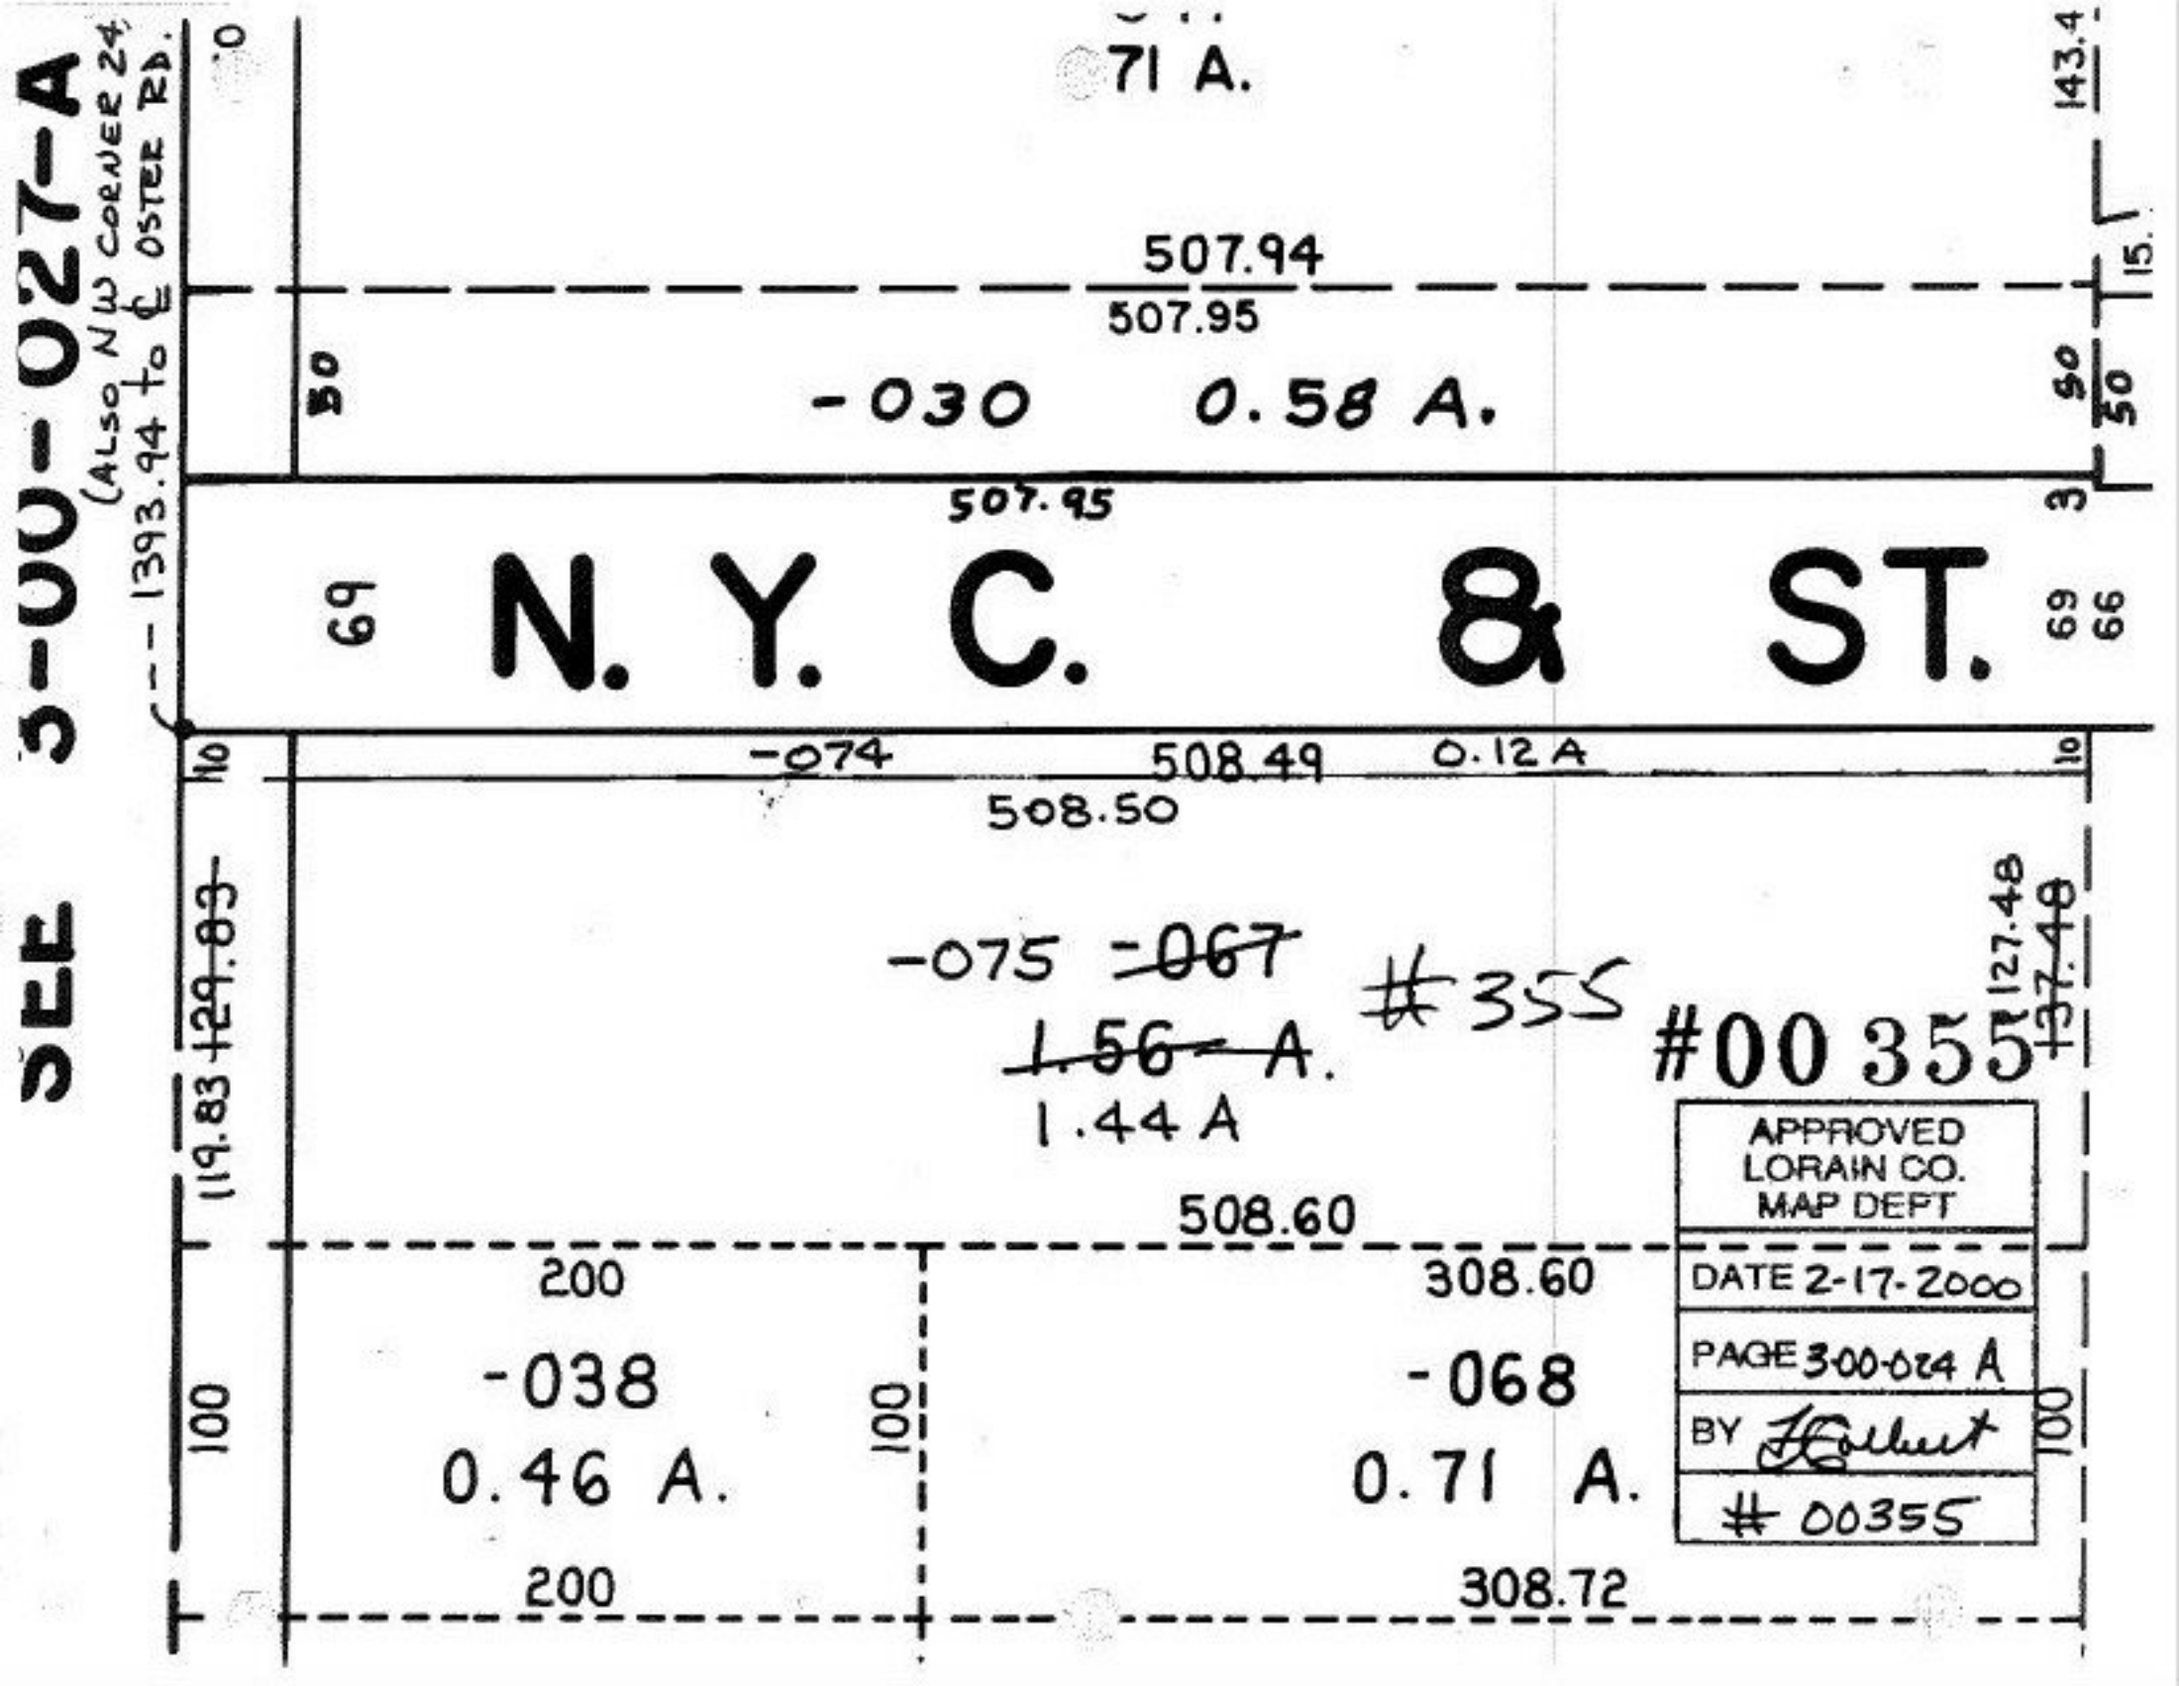
SEE 3-00-027-A
(ALSO N W CORNER 24)
1393.94 to ℄ OSTER RD.
71 A.
507.94
507.95
50
-030 0.58 A.
507.95
69
N. Y. C. & ST.
-074 508.49 0.12 A
508.50
-075 -067
1.56 A.
1.44 A
#355
#00355
119.83 129.83
127.48 137.48
508.60
200
-038
0.46 A.
100
308.60
-068
0.71 A.
100
200
308.72
APPROVED
LORAIN CO.
MAP DEPT
DATE 2-17-2000
PAGE 3-00-024 A
BY
00355