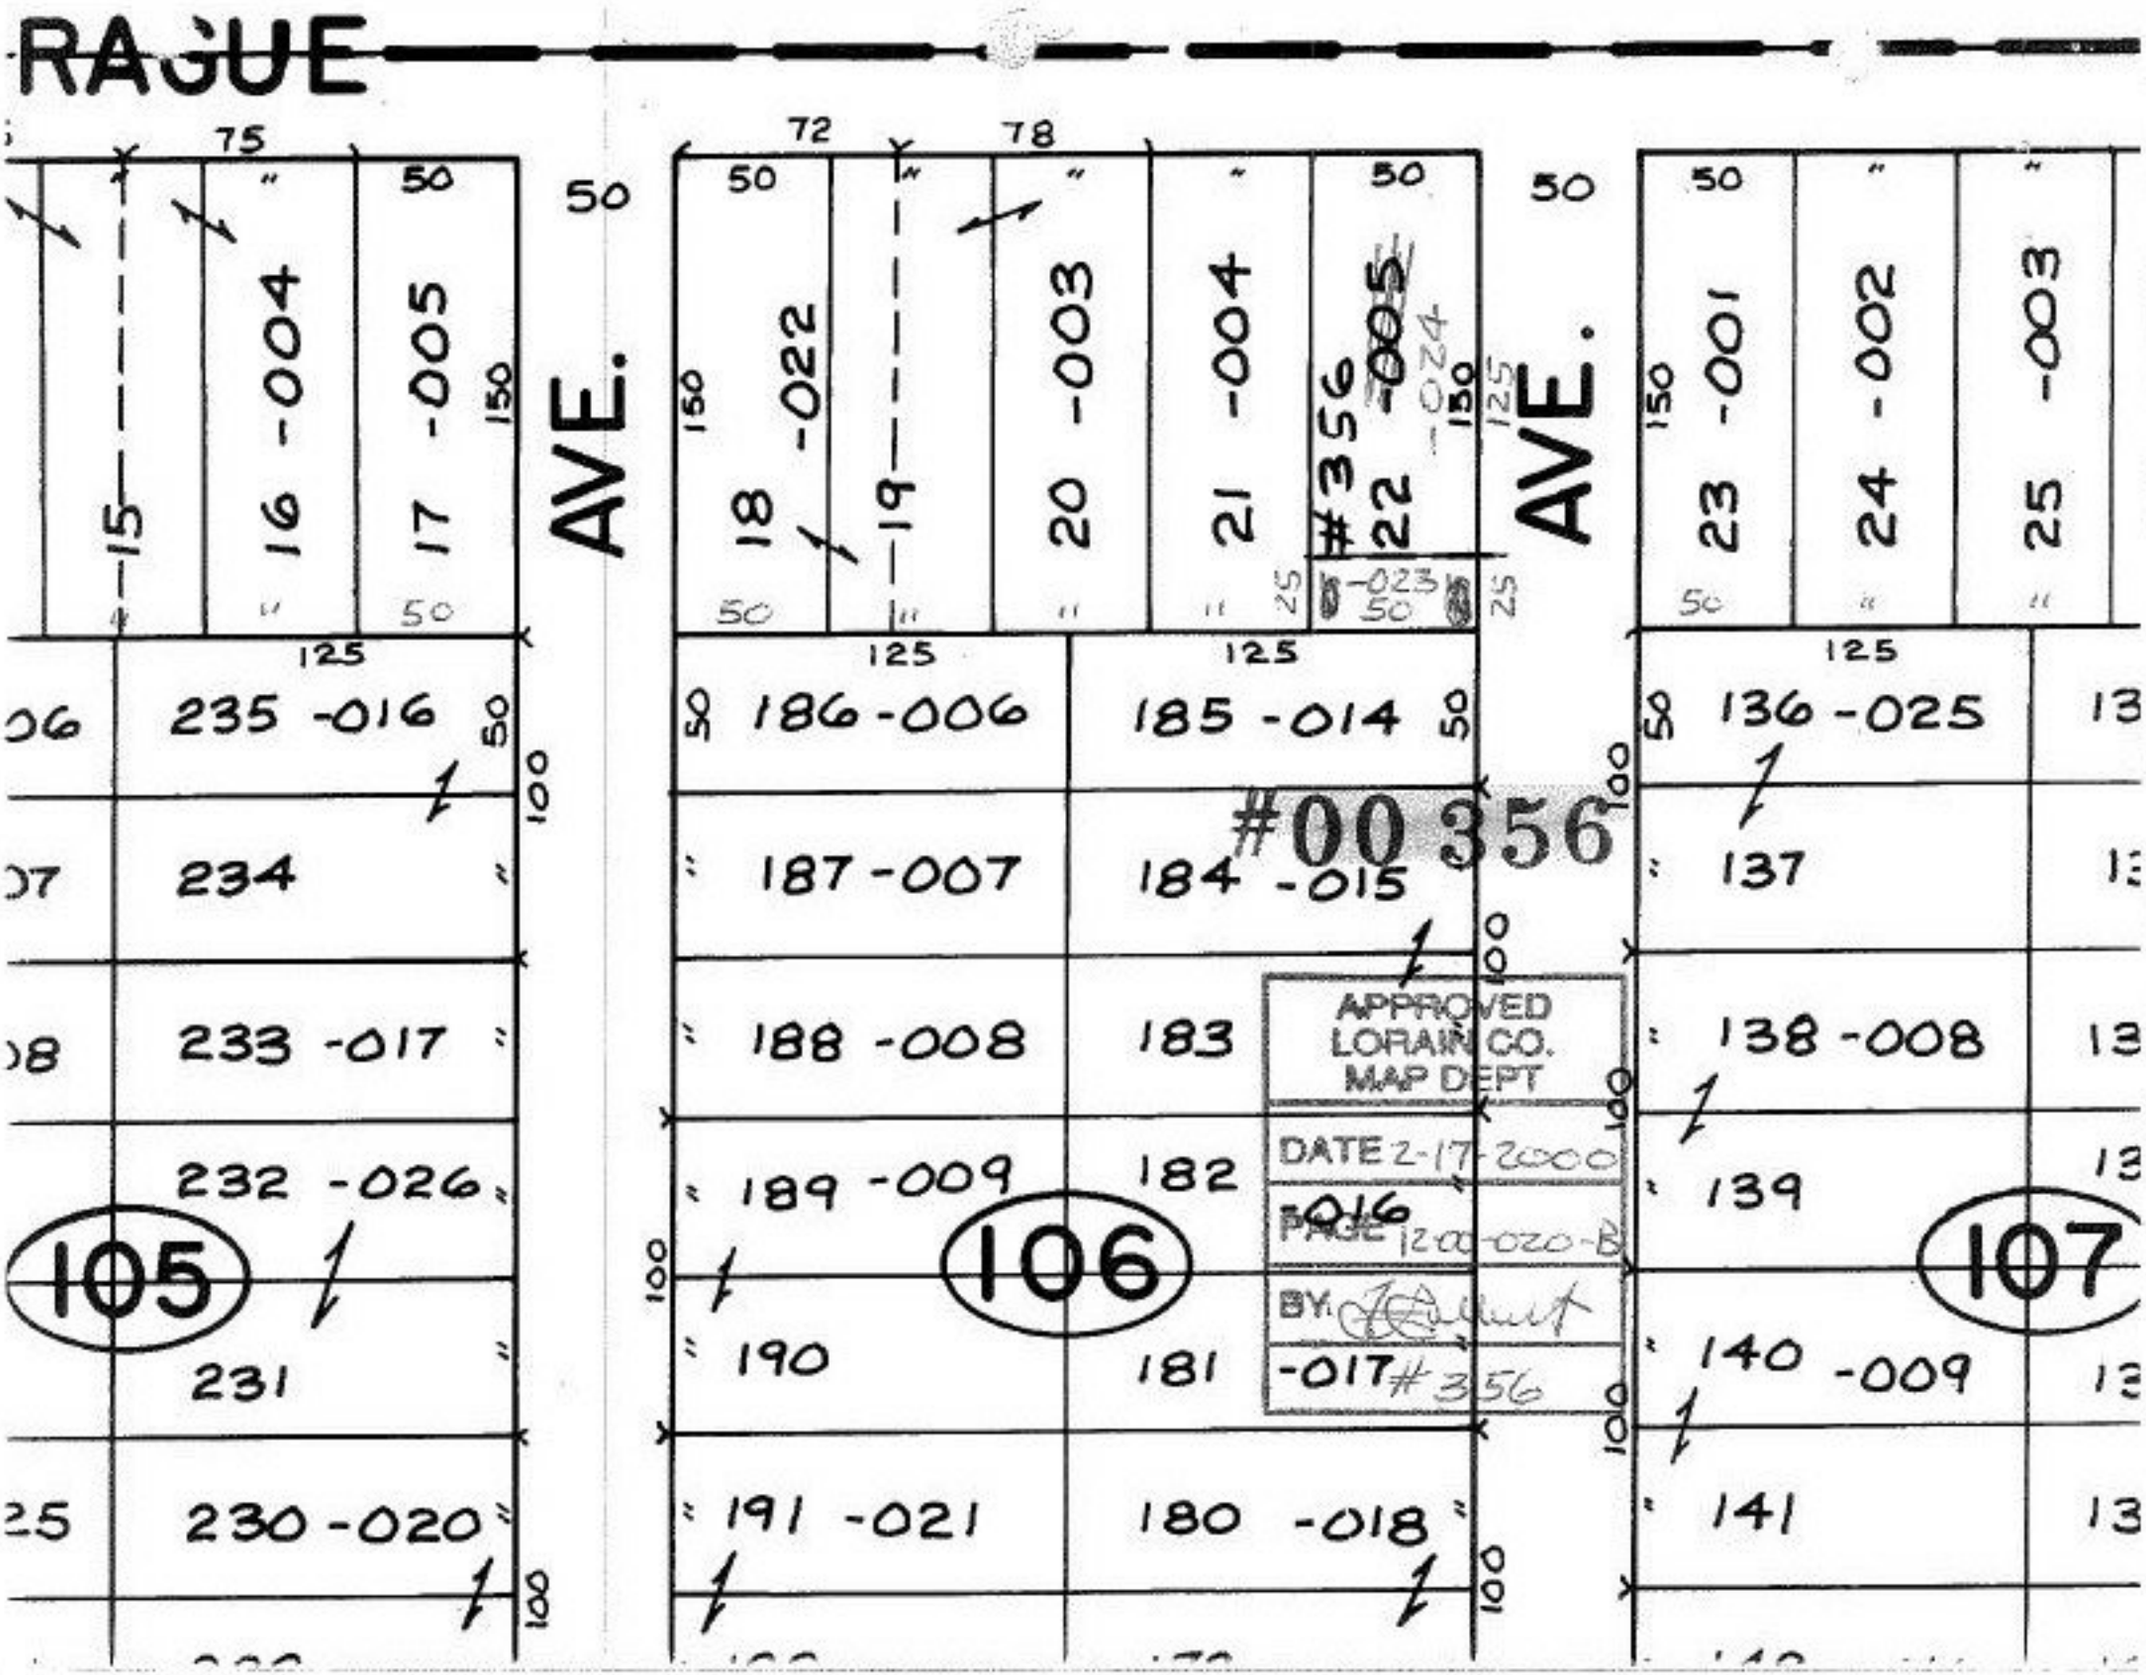
RAGUE
AVE.
AVE.
105
106
107
#00 356
APPROVED
LORAIN CO.
MAP DEPT
DATE 2-17-2000
PAGE 12-00-020-B
BY
#356
235 -016
234
233 -017
232 -026
231
230 -020
186 -006
187 -007
188 -008
189 -009
190
191 -021
185 -014
184 -015
183
182
181
180 -018
136 -025
137
138 -008
139
140 -009
141
15
16 -004
17 -005
18 -022
19
20 -003
21 -004
22 -005
23 -001
24 -002
25 -003