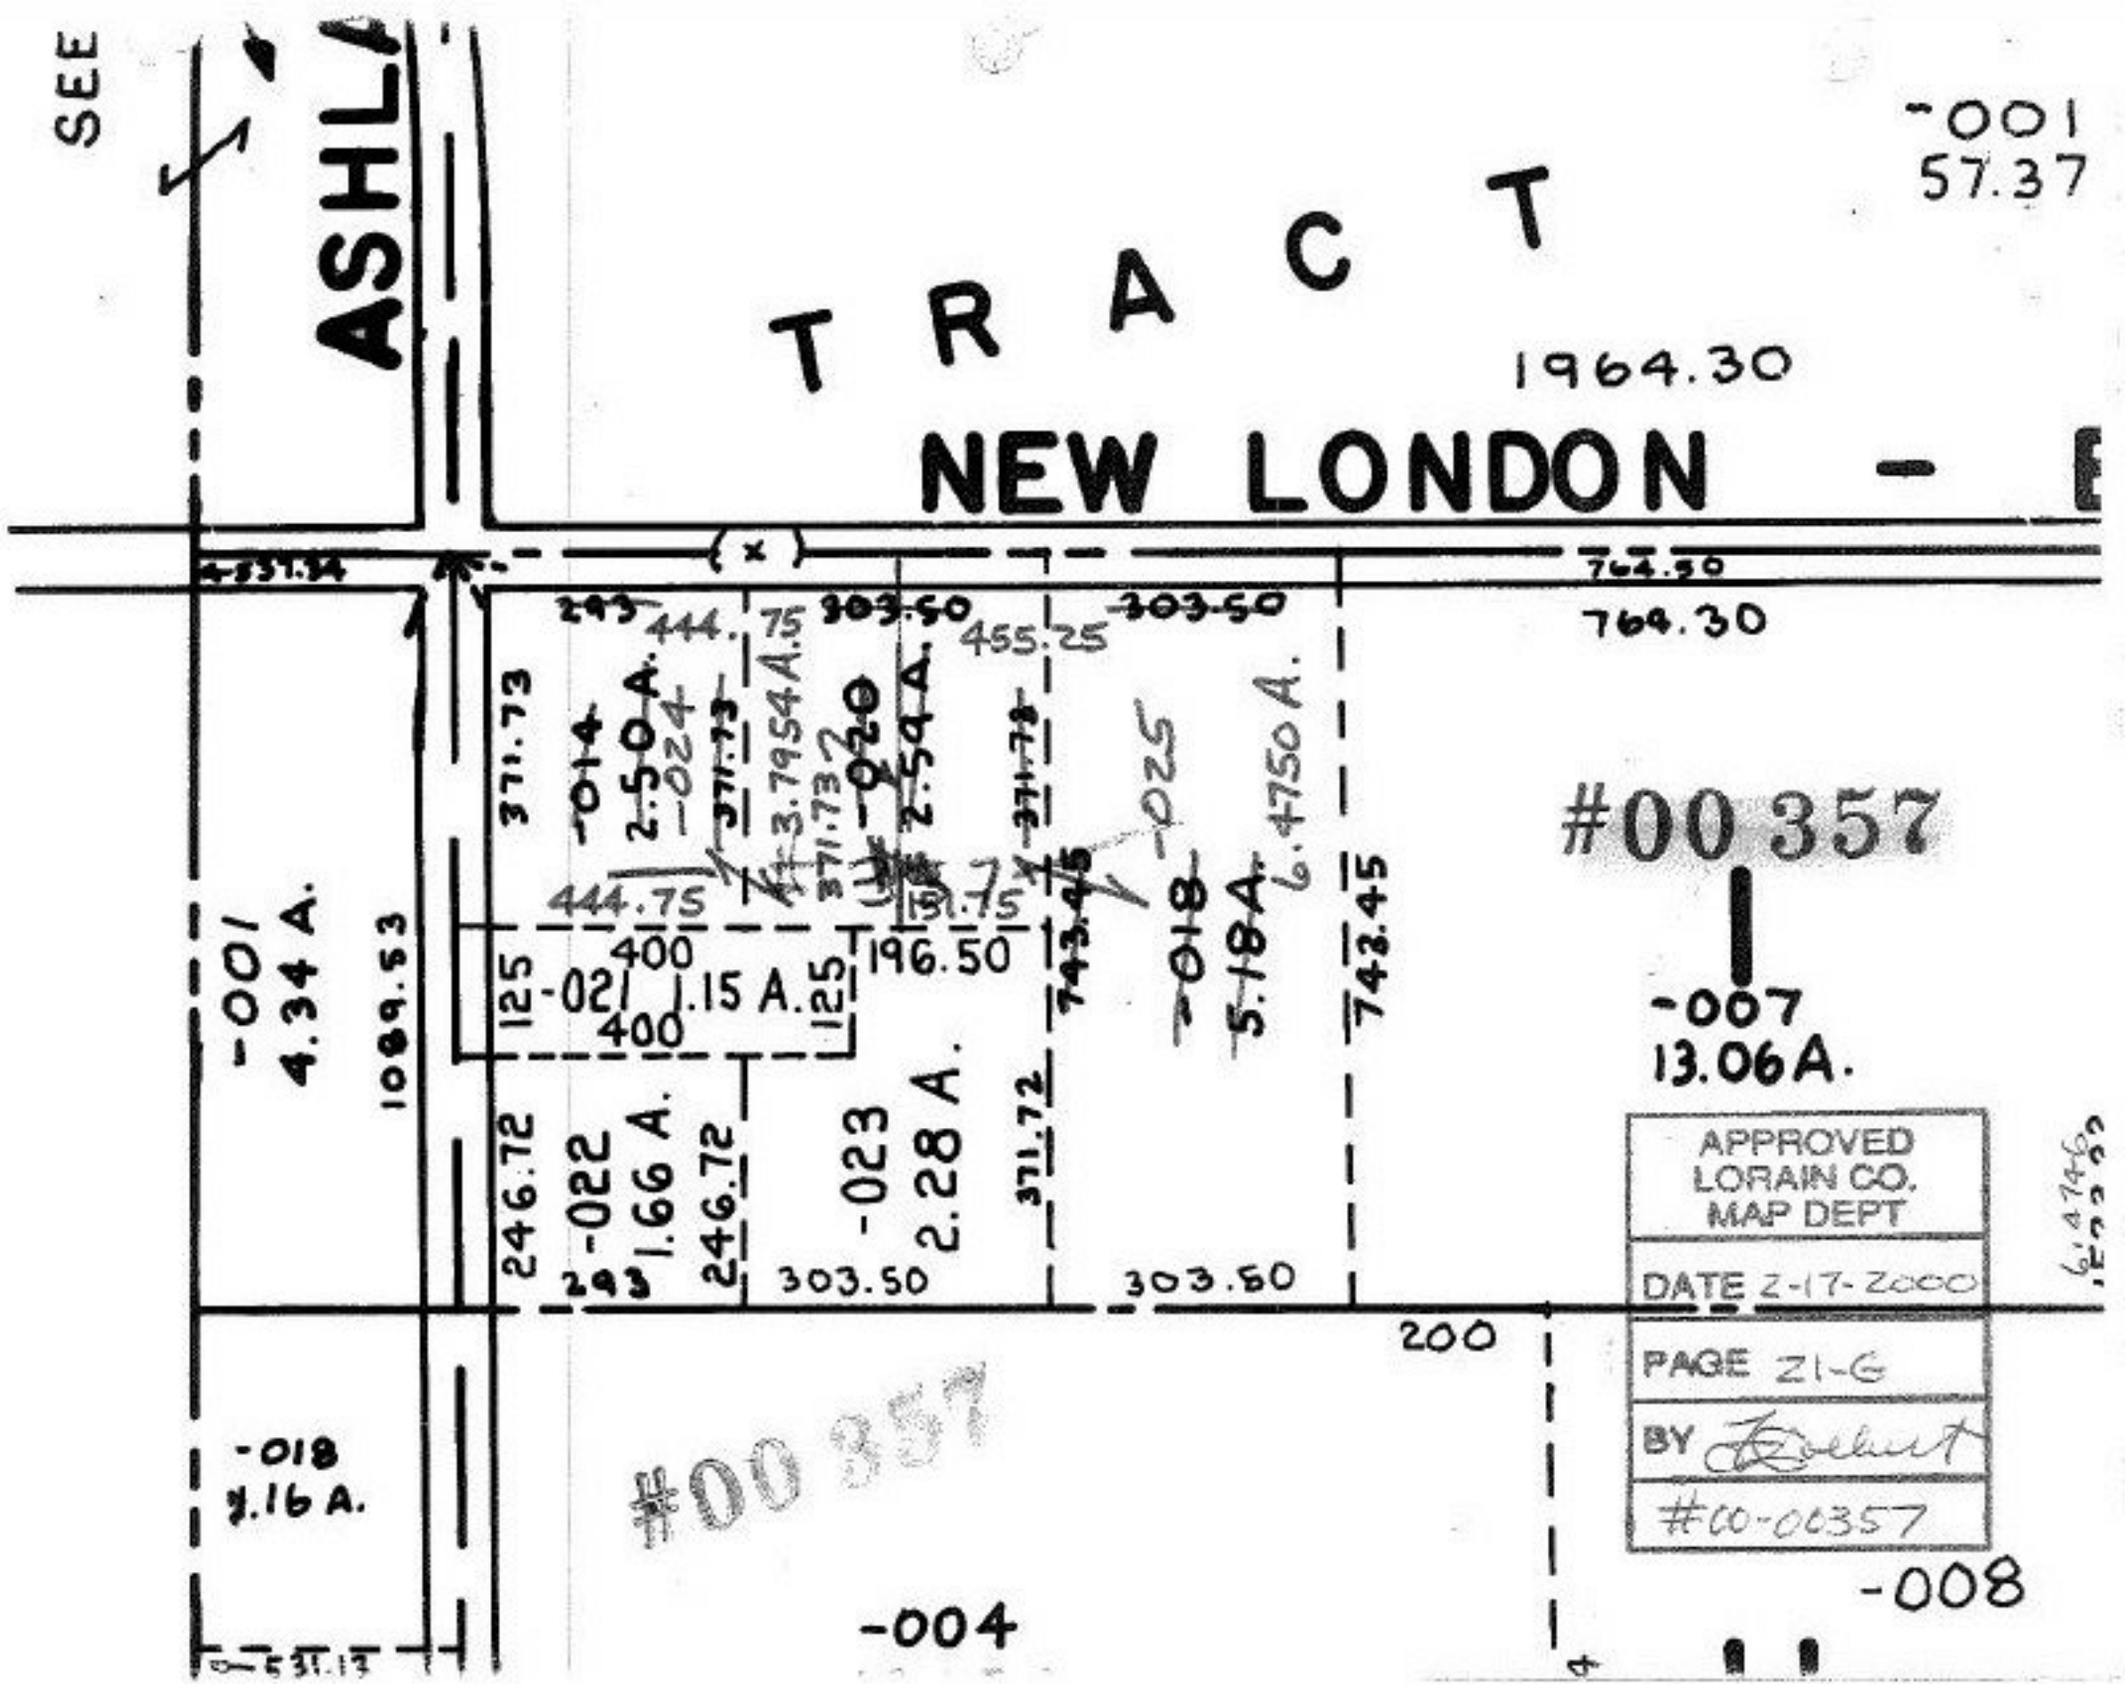
SEE
ASHLA
TRACT
-001
57.37
1964.30
NEW LONDON
764.30
764.30
-001
4.34 A.
1089.53
-014
2.50 A.
-024
3.7954 A.
-020
2.54 A.
-025
6.4750 A.
-018
5.184
#00357
-007
13.06A.
-021
.15 A.
-022
1.66 A.
-023
2.28 A.
-018
9.16 A.
-004
-008
APPROVED
LORAIN CO.
MAP DEPT
DATE 2-17-2000
PAGE 21-G
BY
#00-00357
#00357