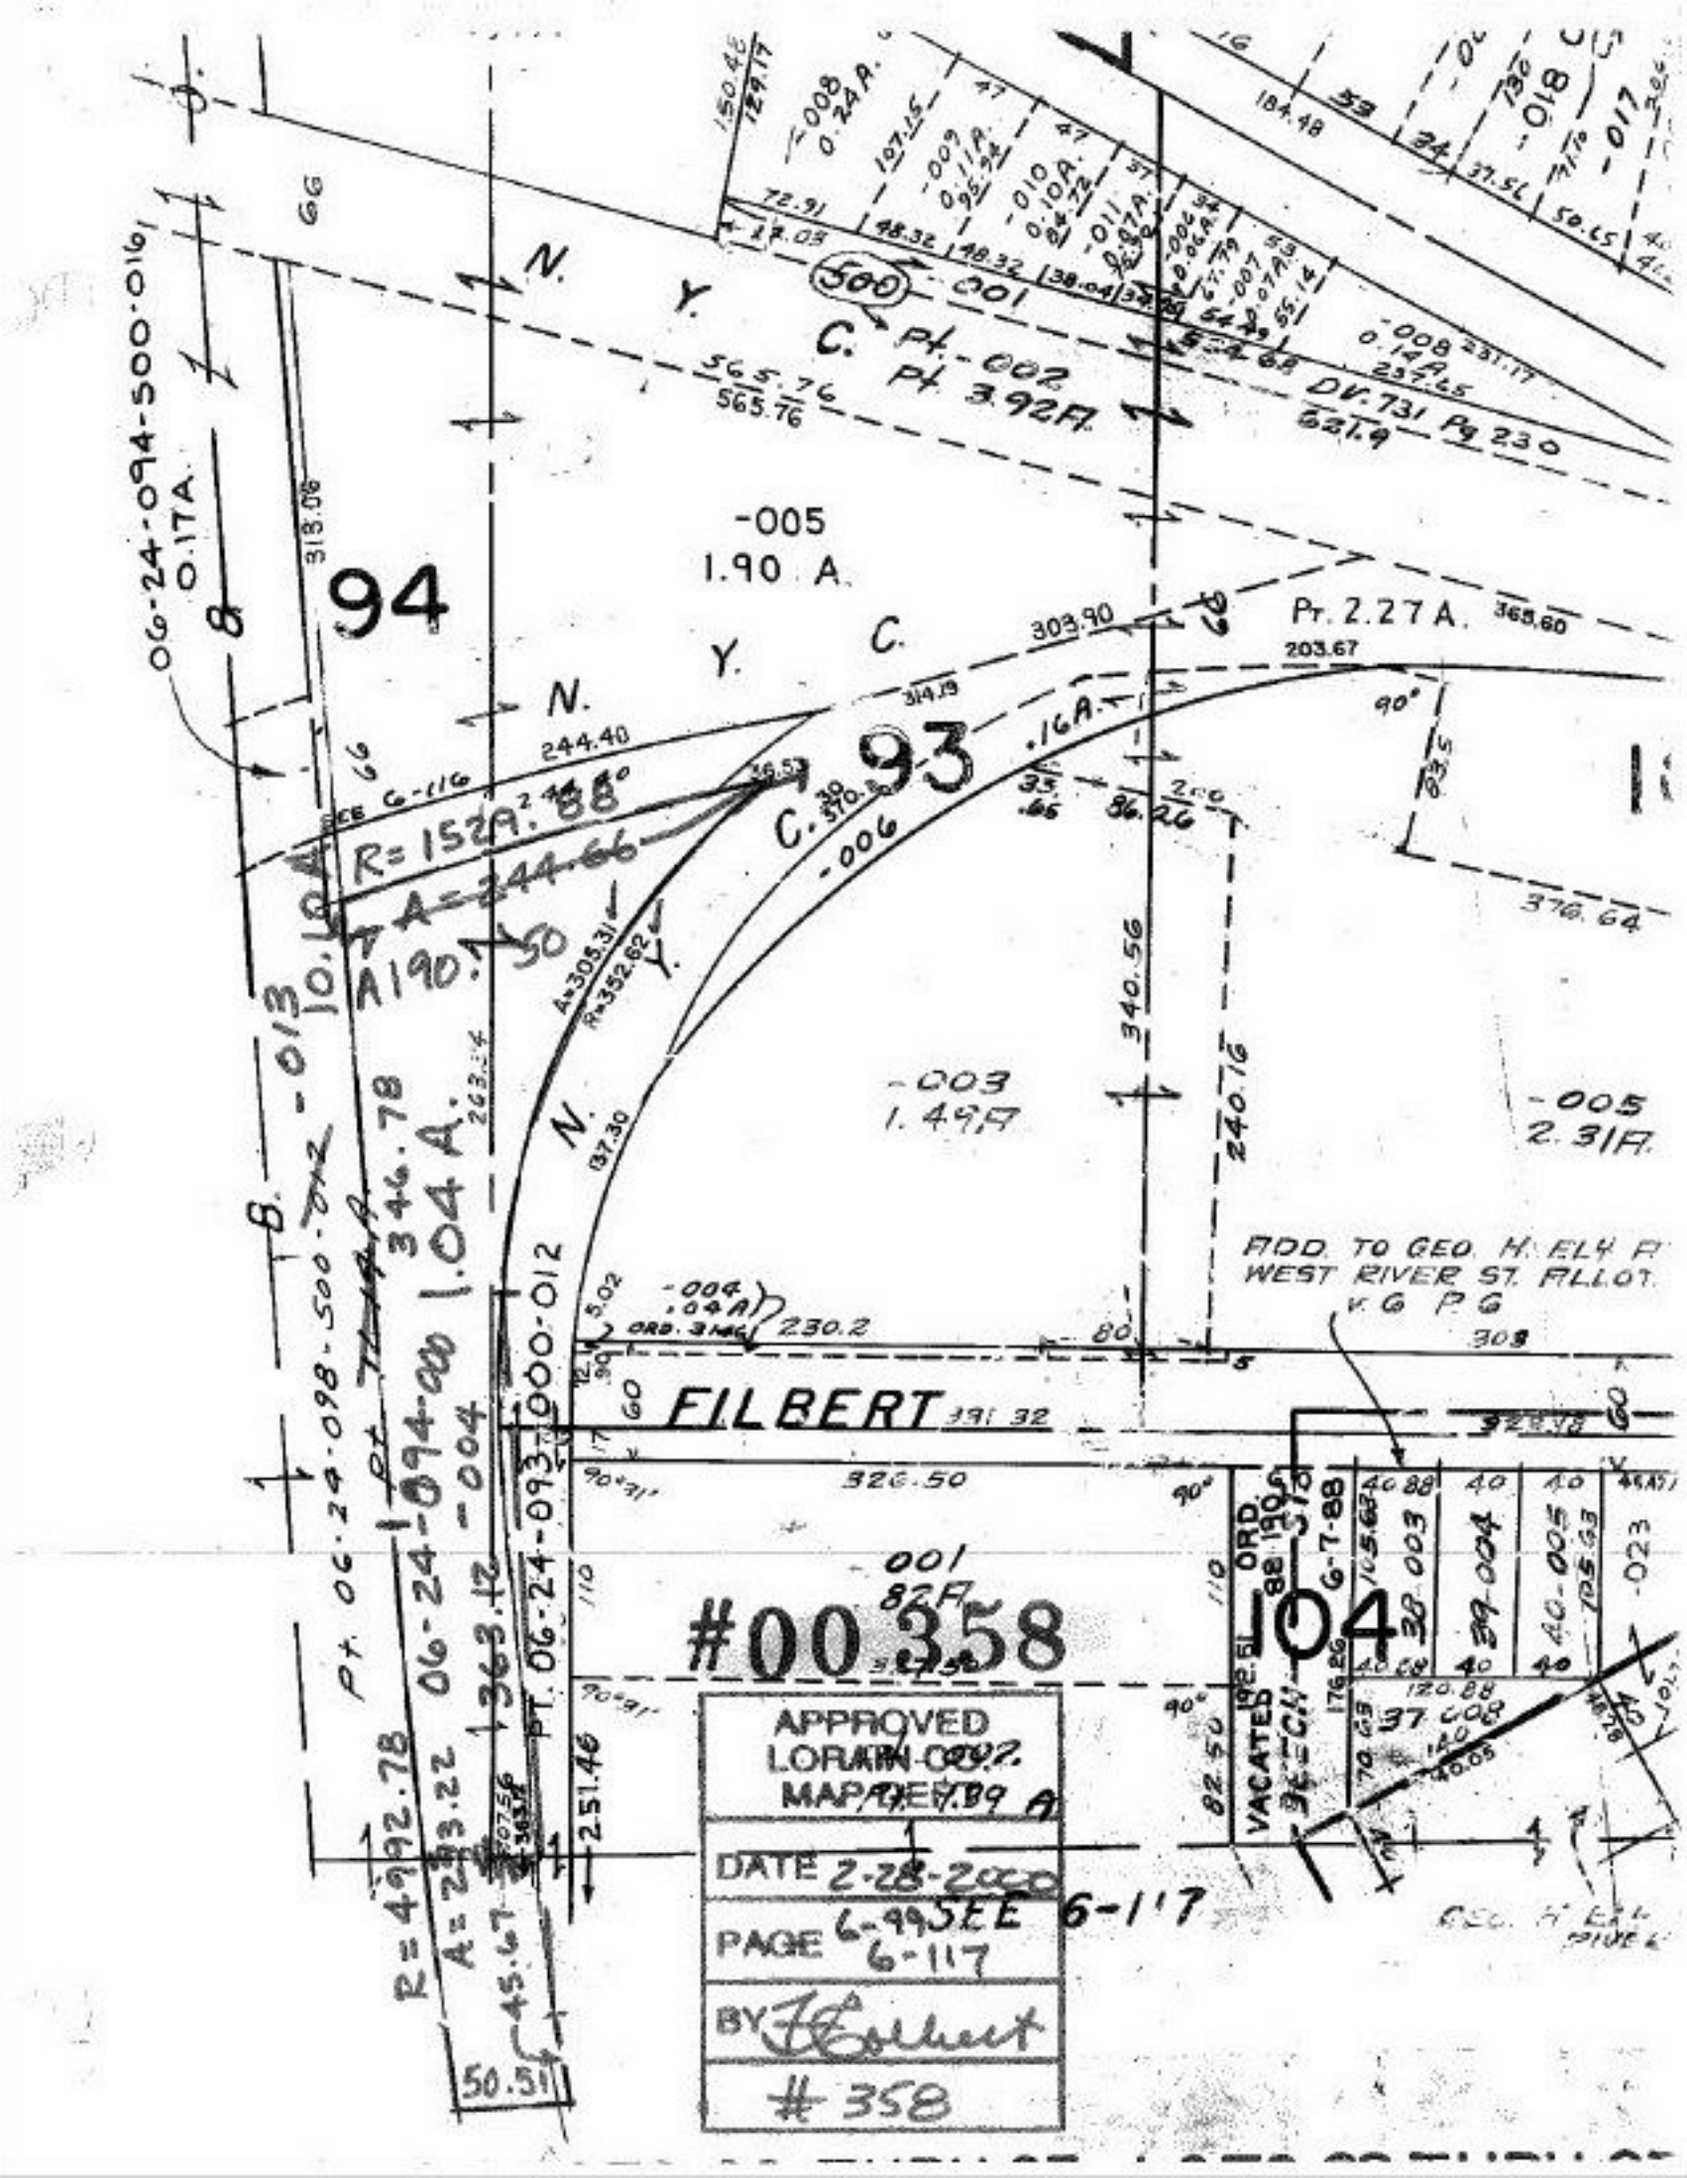
06-24-094-500-0161
0.17A.
94
93
-005
1.90 A.
N. Y. C.
Pt. 3.92A.
Pt. 2.27A.
DV. 731 Pg 230
-001
-002
-003
1.49A
-004
.04A
-005
2.31A.
-006
.16A.
-007
-008
0.14A.
-009
0.11A.
-010
0.10A.
-011
0.87A.
-012
-013
-017
-018
-023
R=1529.88°
A=244.66
A=305.31
R=352.62
C. 370.30
ADD. TO GEO. H. ELY P
WEST RIVER ST. ALLOT.
V. G P. G
FILBERT
326.50
ORD. 3146
ORD. 3513
VACATED
104
#00358
APPROVED
LORAIN CO.
MAP REVISED
DATE 2-28-2000
PAGE 6-99 SEE 6-117
BY
#358