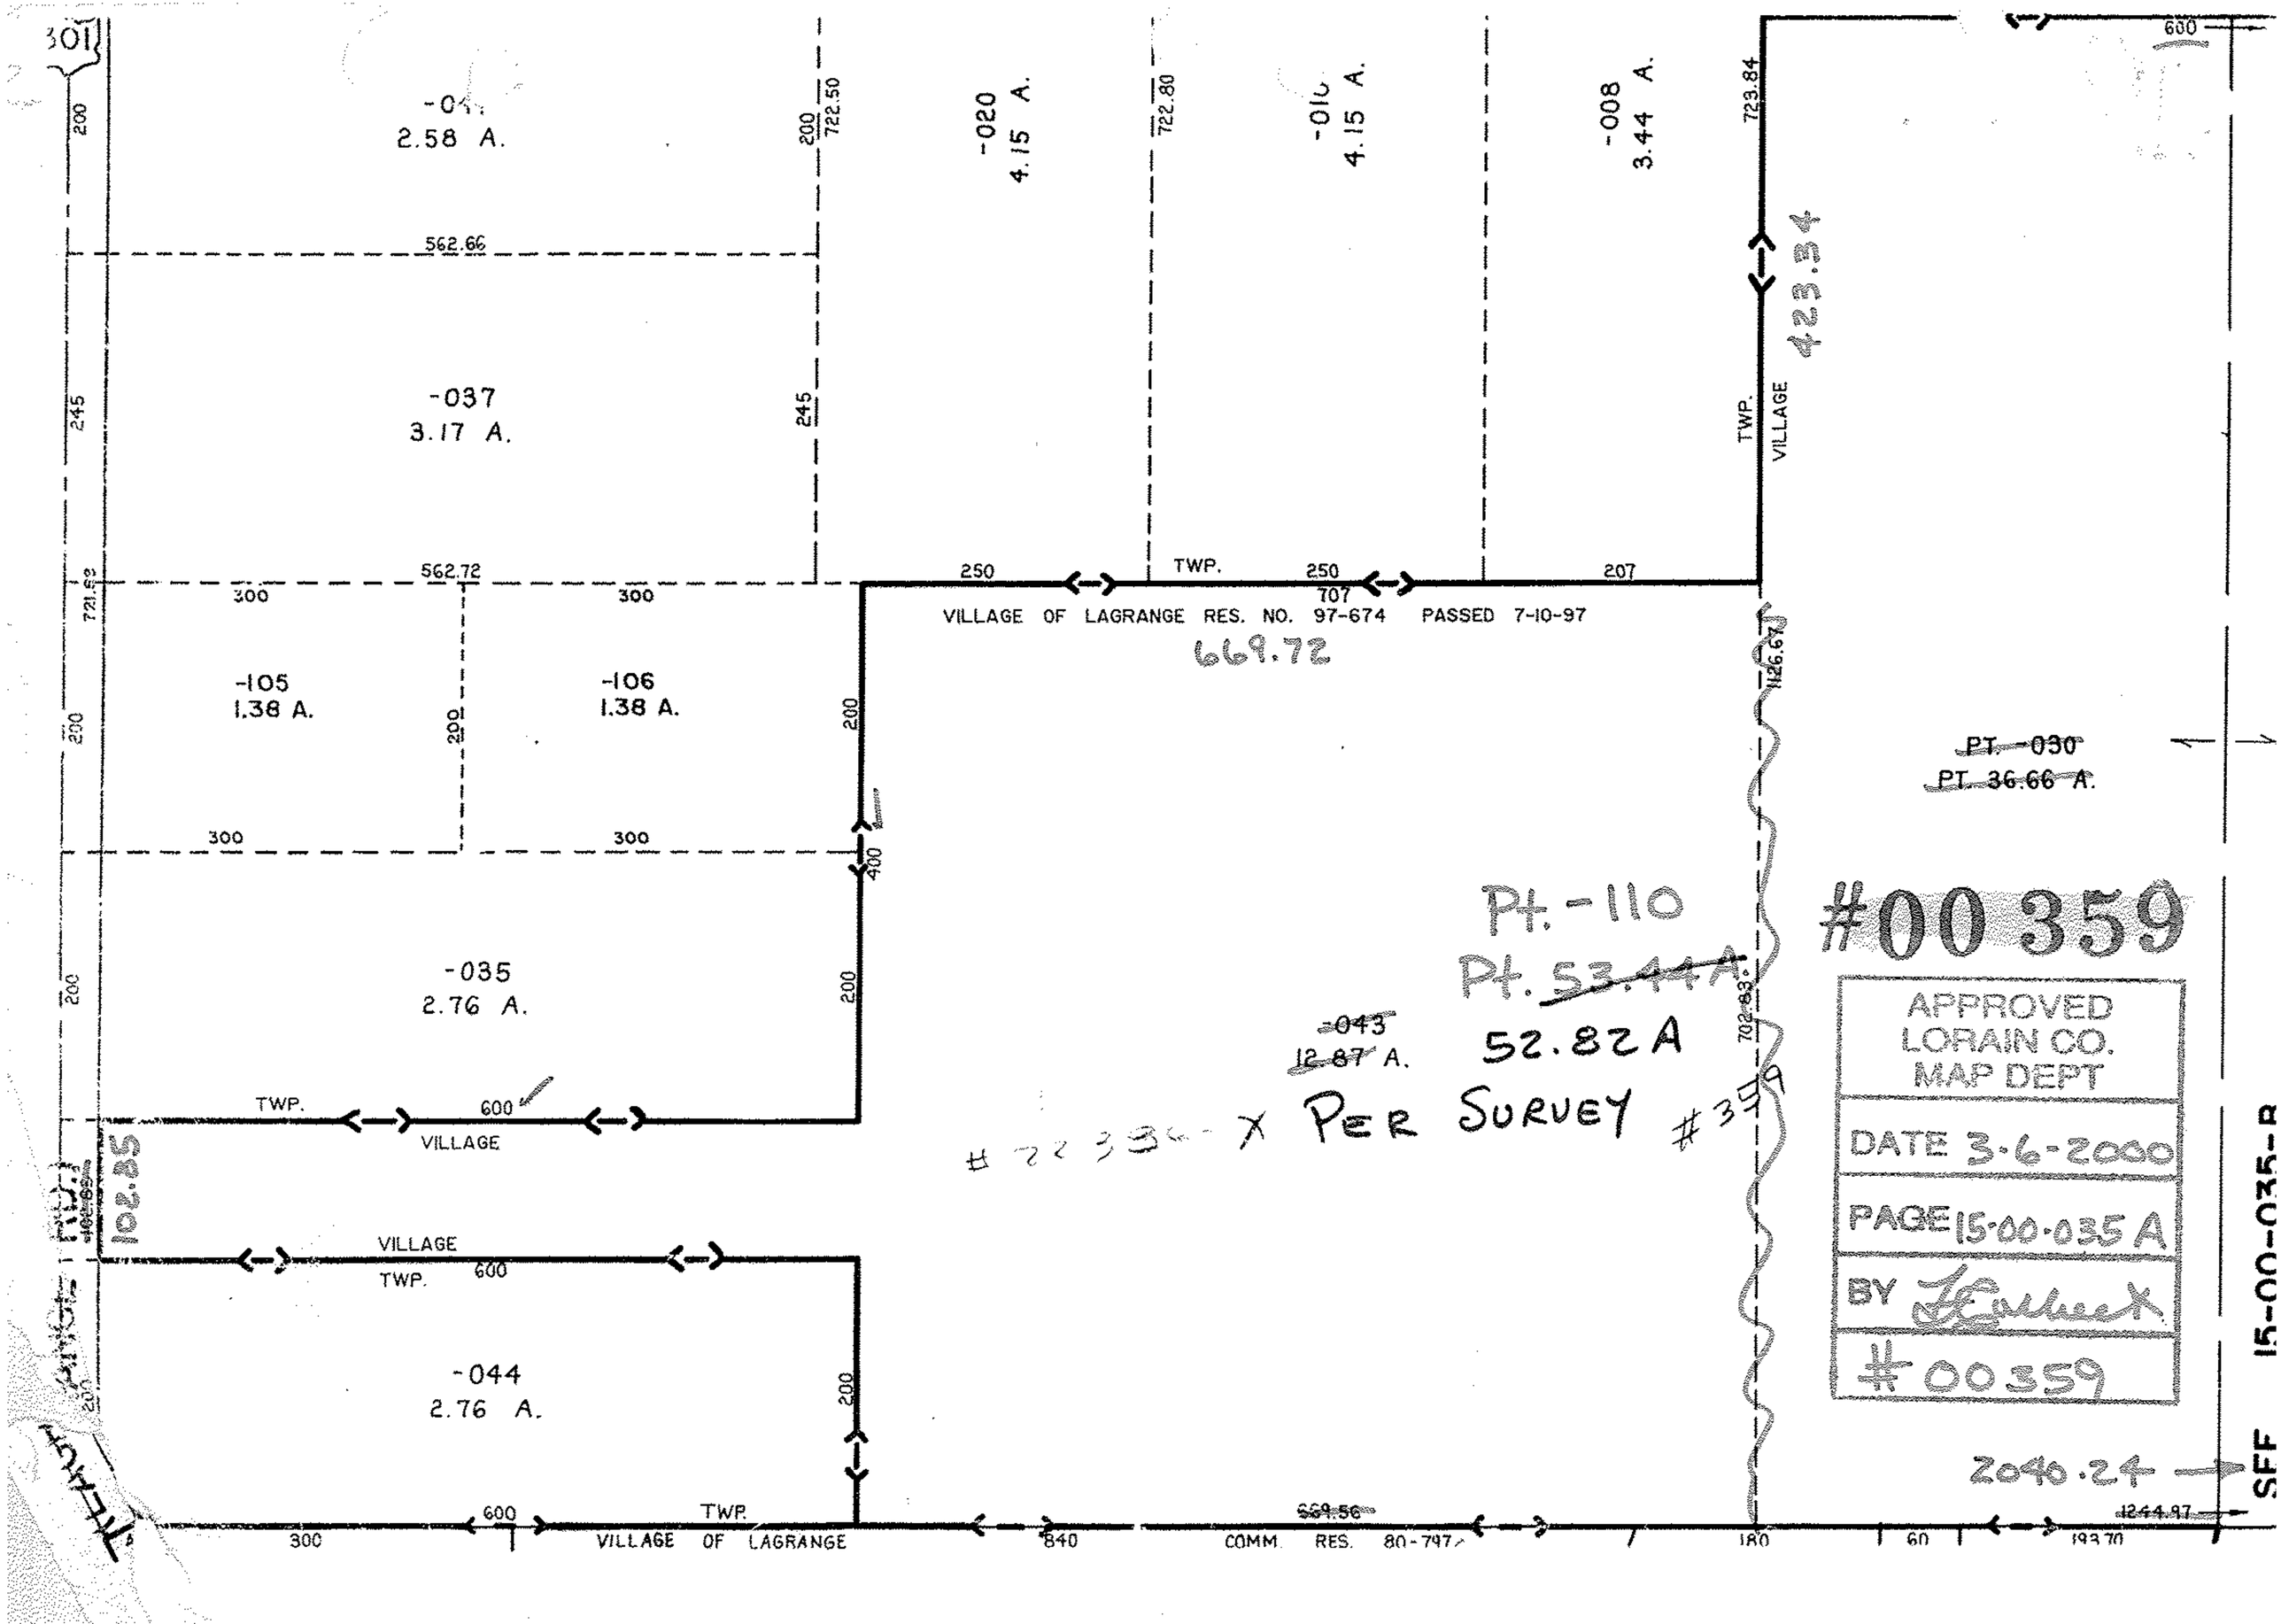
301
-044
2.58 A.
-020
4.15 A.
-010
4.15 A.
-008
3.44 A.
-037
3.17 A.
-105
1.38 A.
-106
1.38 A.
-035
2.76 A.
-044
2.76 A.
562.66
562.72
722.50
722.80
723.84
423.34
TWP.
VILLAGE
VILLAGE OF LAGRANGE RES. NO. 97-674 PASSED 7-10-97
669.72
1126.67
PT. -030
PT. 36.66 A.
Pt. -110
Pt. 53.44 A.
52.82 A
-043
12.87 A.
PER SURVEY
#359
#00359
APPROVED
LORAIN CO.
MAP DEPT
DATE 3-6-2000
PAGE 15-00-035 A
BY
#00359
2040.24
102.85
VILLAGE OF LAGRANGE
COMM. RES. 80-797
669.56
1244.97
SEE 15-00-035-B