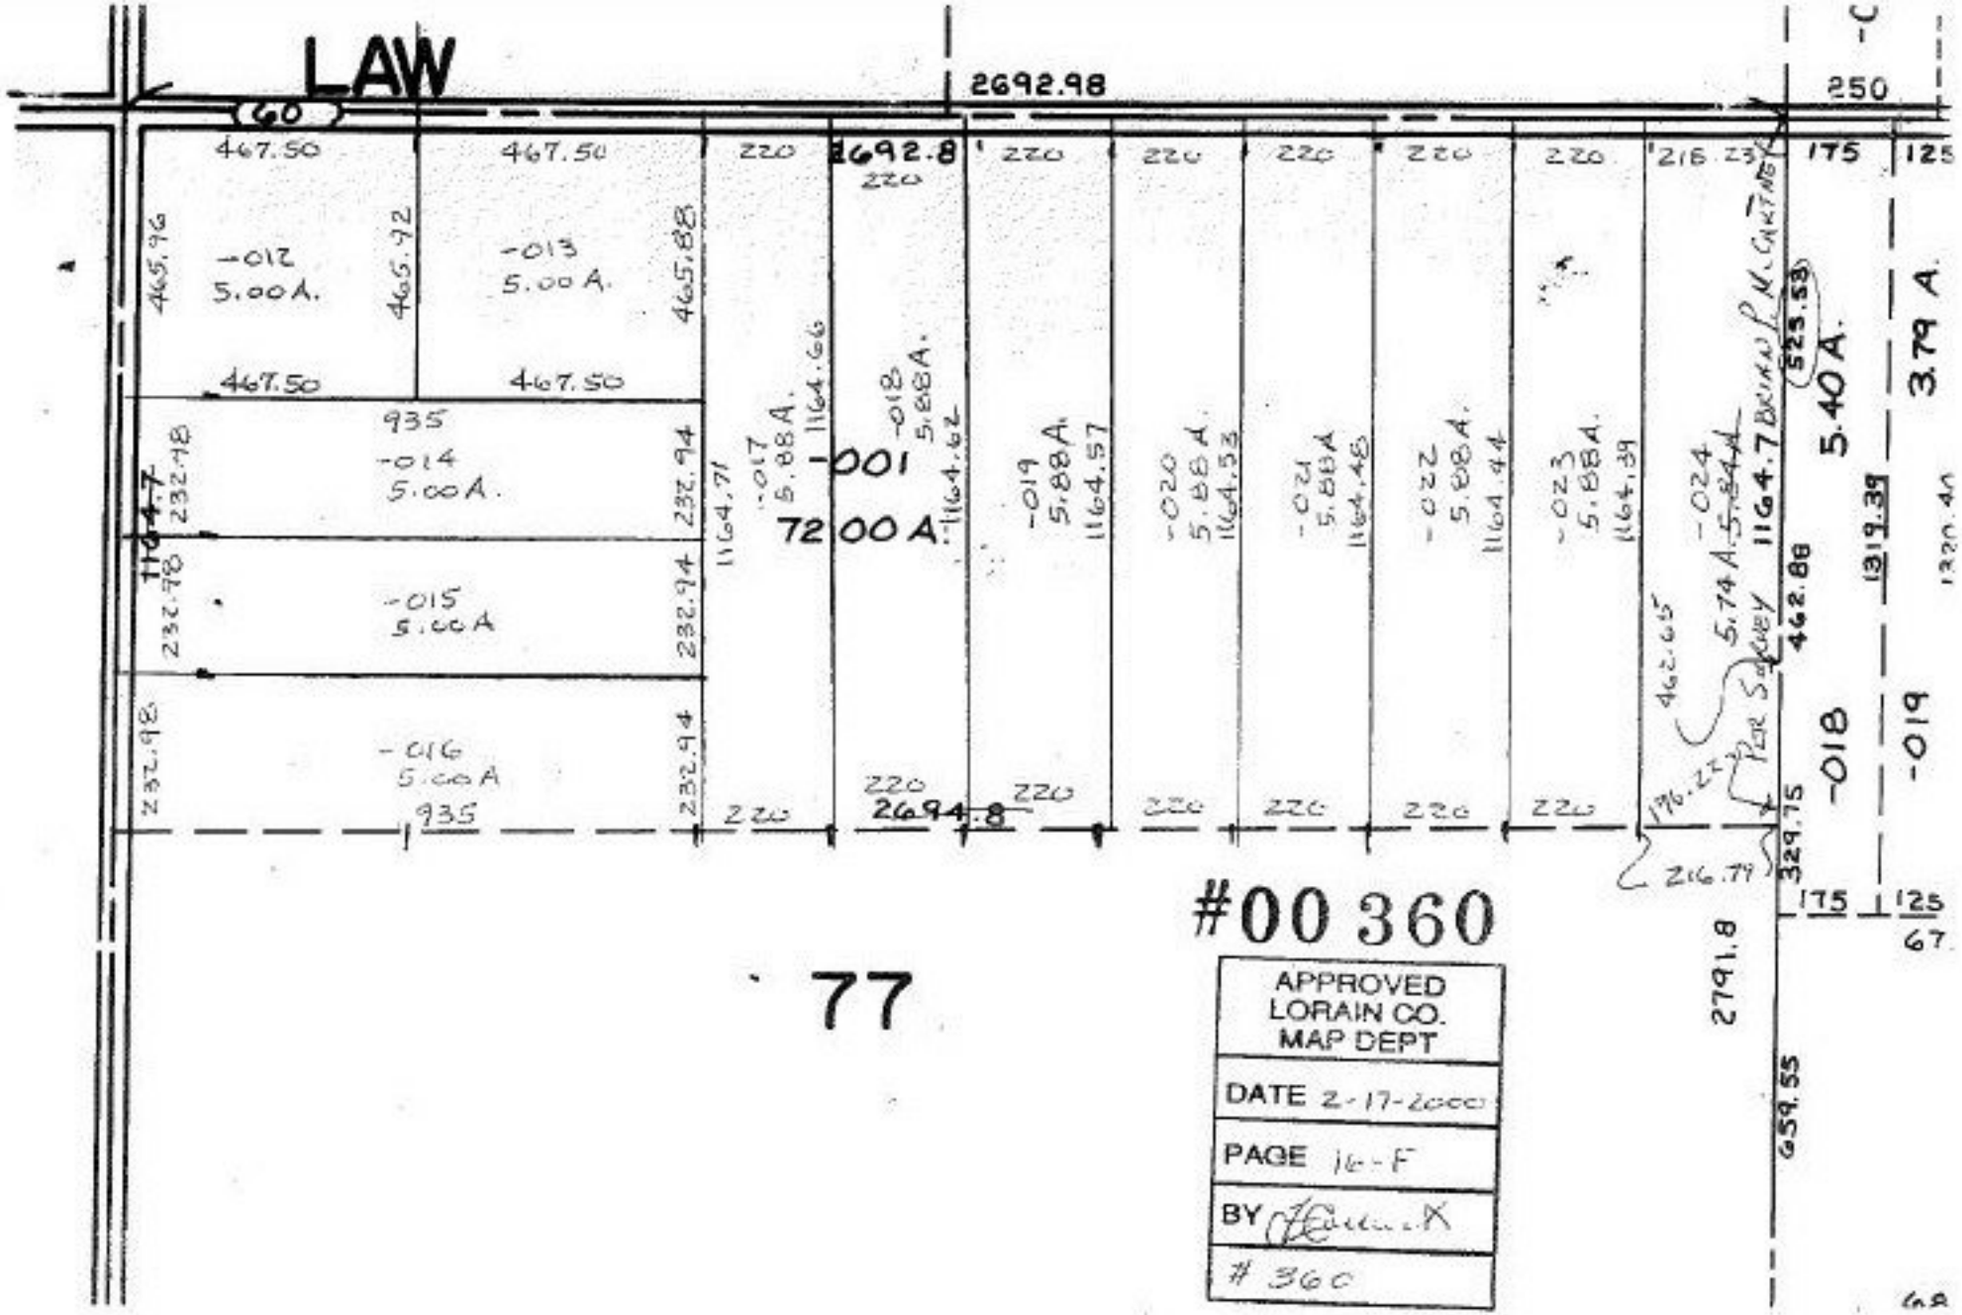

#00 360

77

APPROVED LORAIN CO. MAP DEPT
DATE 2-17-2000
PAGE 16-F
BY [illegible]
360

TS
4-24-00