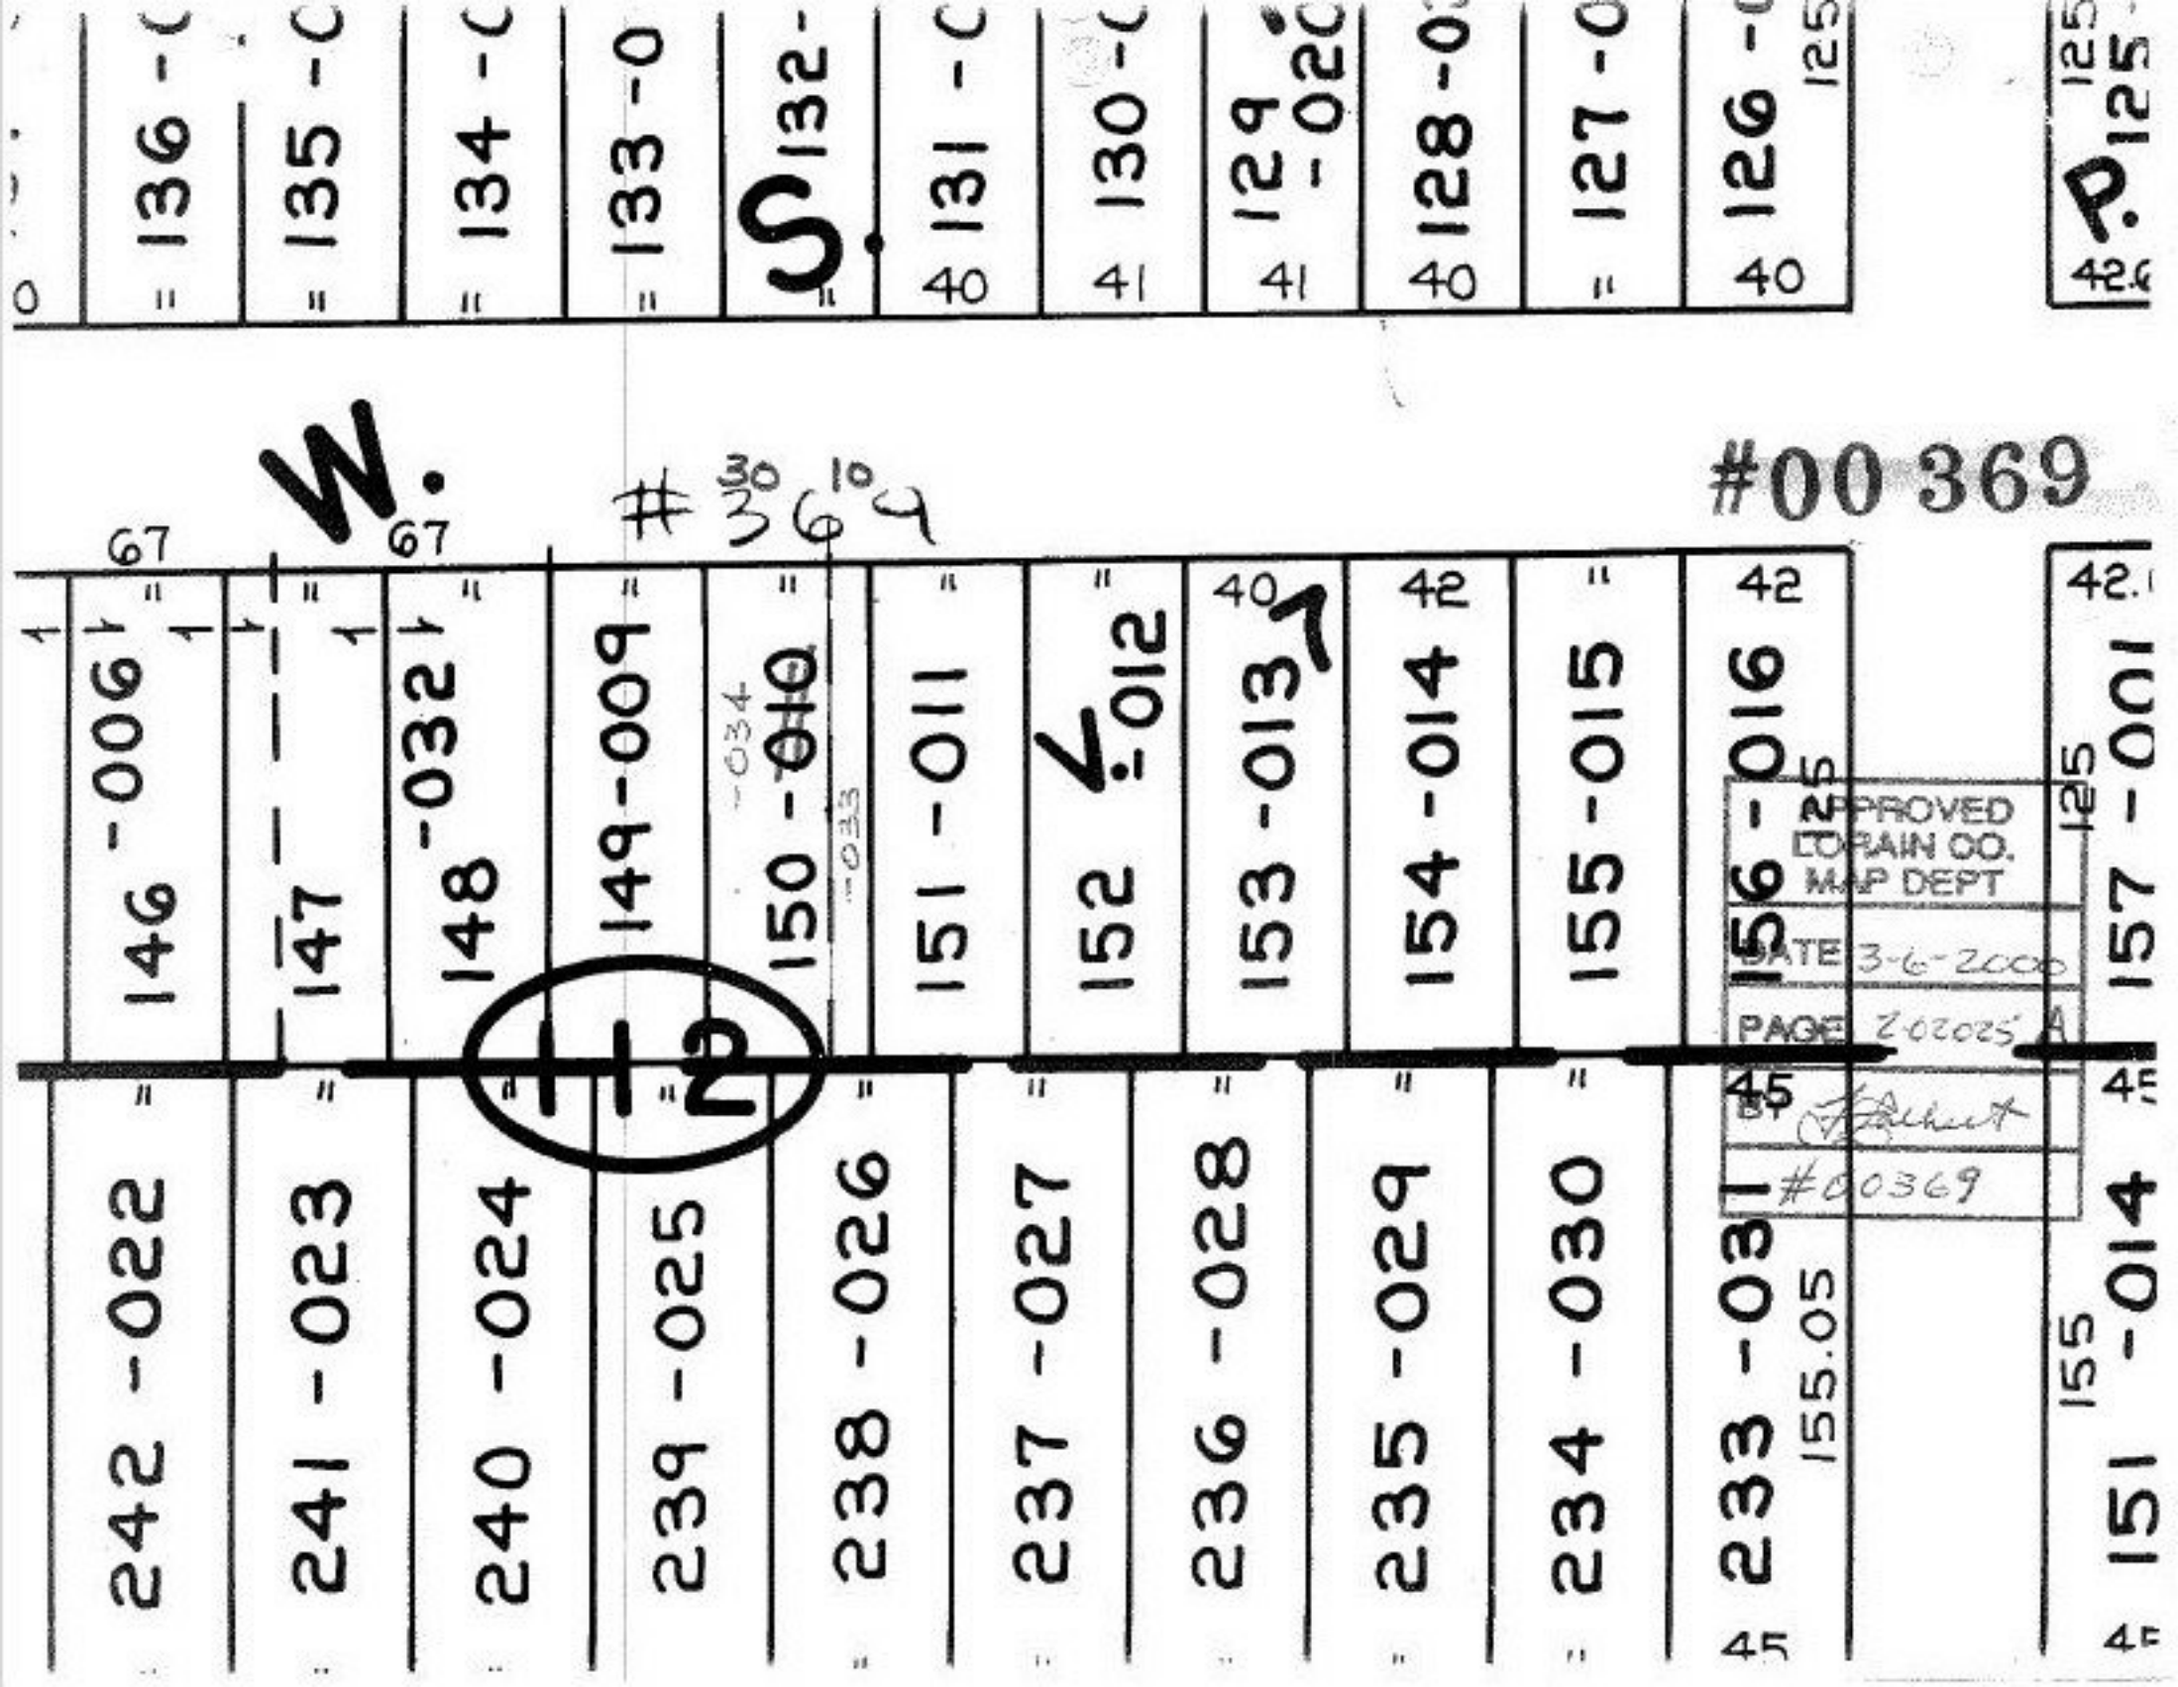

#00 369
#3 30 6 10 9
W.
S.
P.
112
APPROVED
LORAIN CO.
MAP DEPT
DATE 3-6-2000
PAGE 2-02025 A
BY
#00369