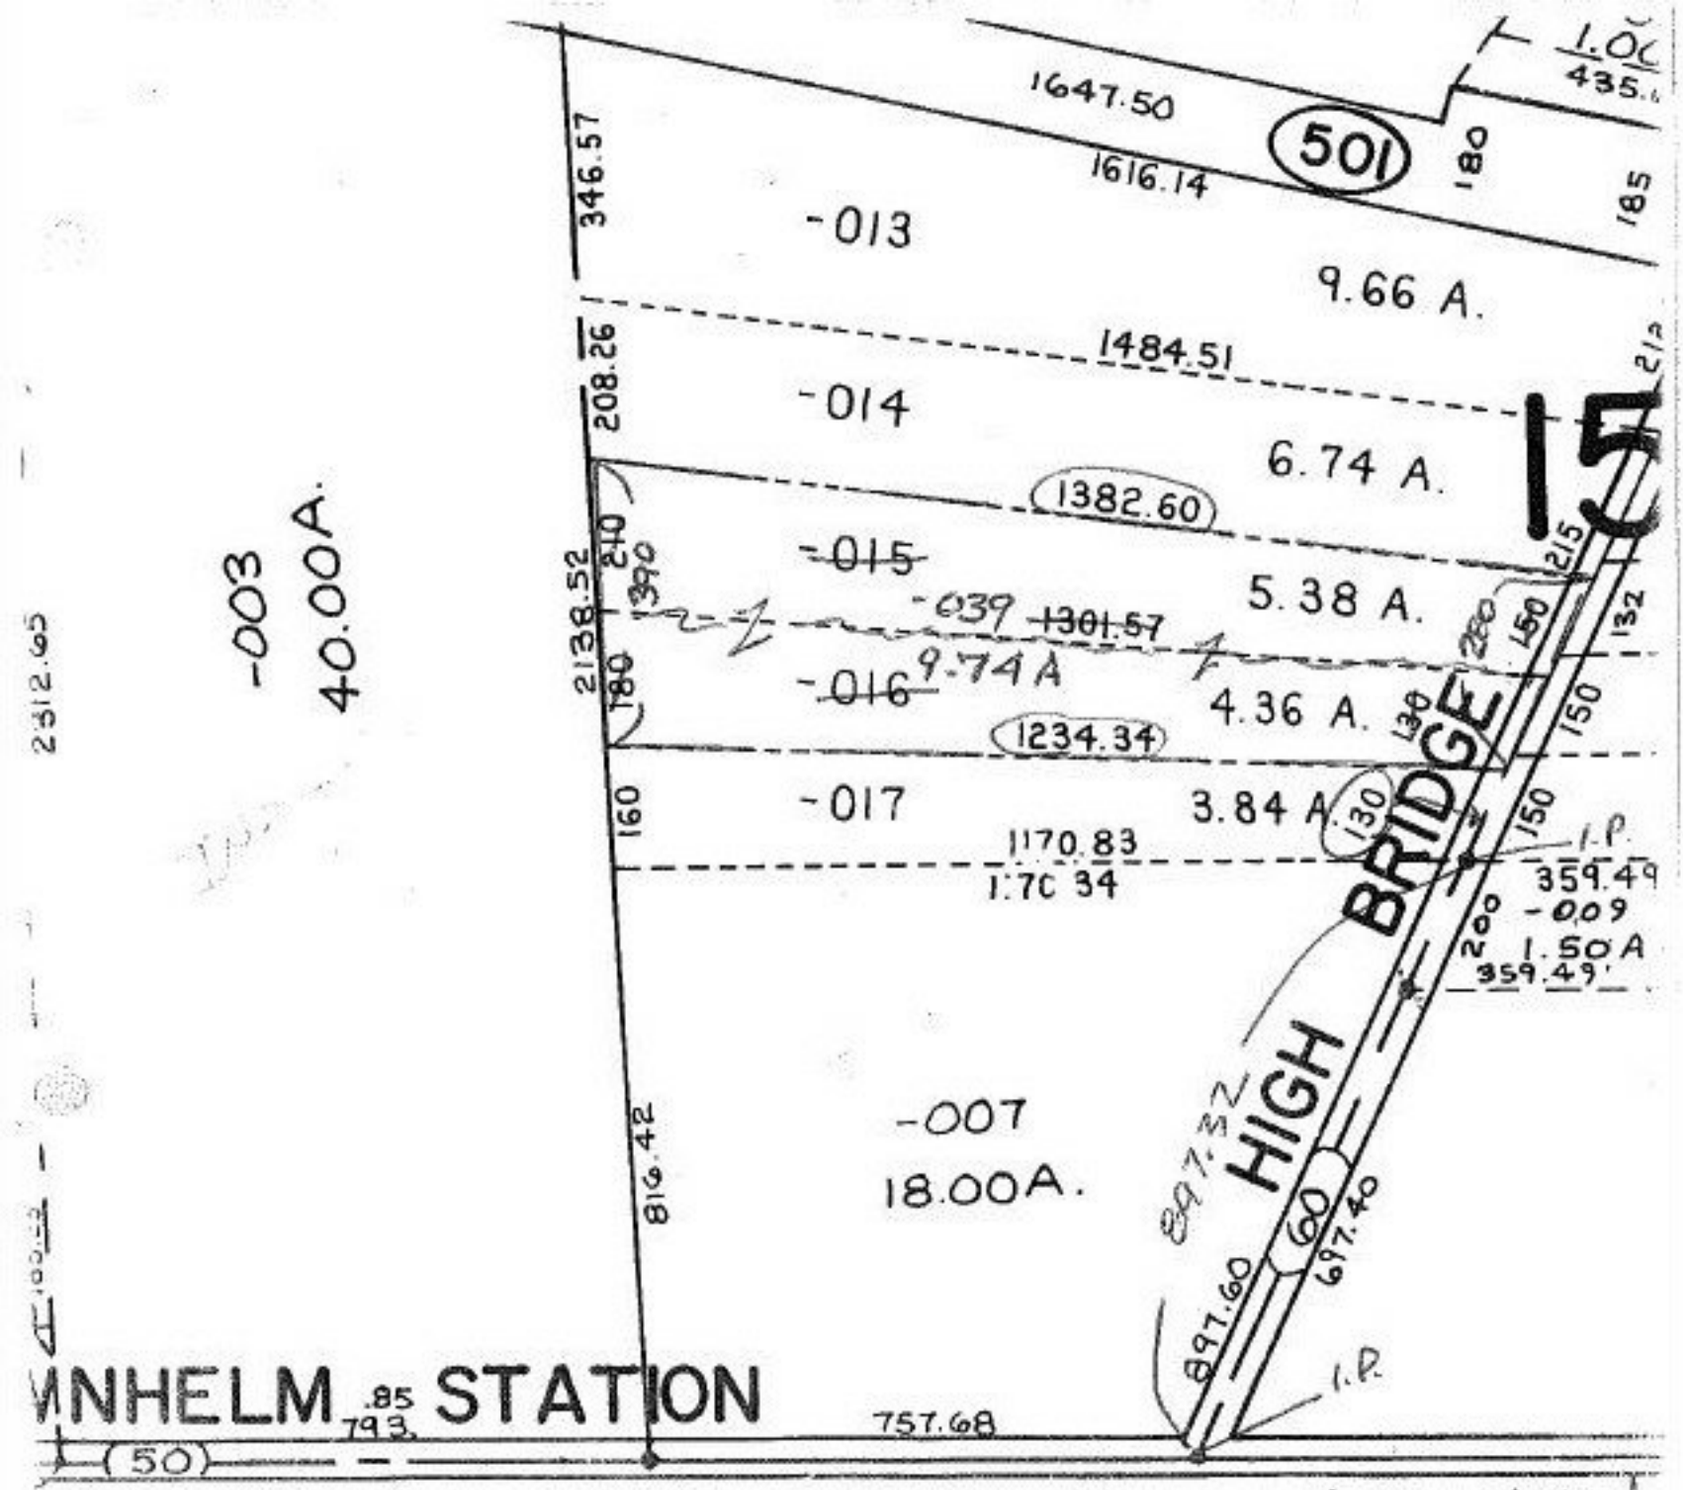
1.0C
435.
1647.50
1616.14
501
180
185
346.57
-013
9.66 A.
1484.51
208.26
-014
6.74 A.
1382.60
-015
-039 1301.57
5.38 A.
-016 9.74 A
4.36 A.
1234.34
-017
3.84 A.
1170.83
1170 34
-003
40.00A.
2312.05
2138.52
210
390
180
160
816.42
-007
18.00A.
897.32
897.60
697.40
60
HIGH BRIDGE
215
280
150
132
130
150
130
150
I.P.
359.49
-009
1.50A
359.49
200
I.P.
757.68
793.85
(50)
NNHELM STATION
33
SEE I-E
COMBINATION
#00374
See
MICHAEL G HORA SURVEY
CL=0.05=10,000
Prior Inst Ref-
DOC 475044 & CB3618
APPROVED
LORAIN CO.
MAP DEPT.
DATE 5-24-00
PARCEL 1-A
BY T.Moylan
PPN 00374