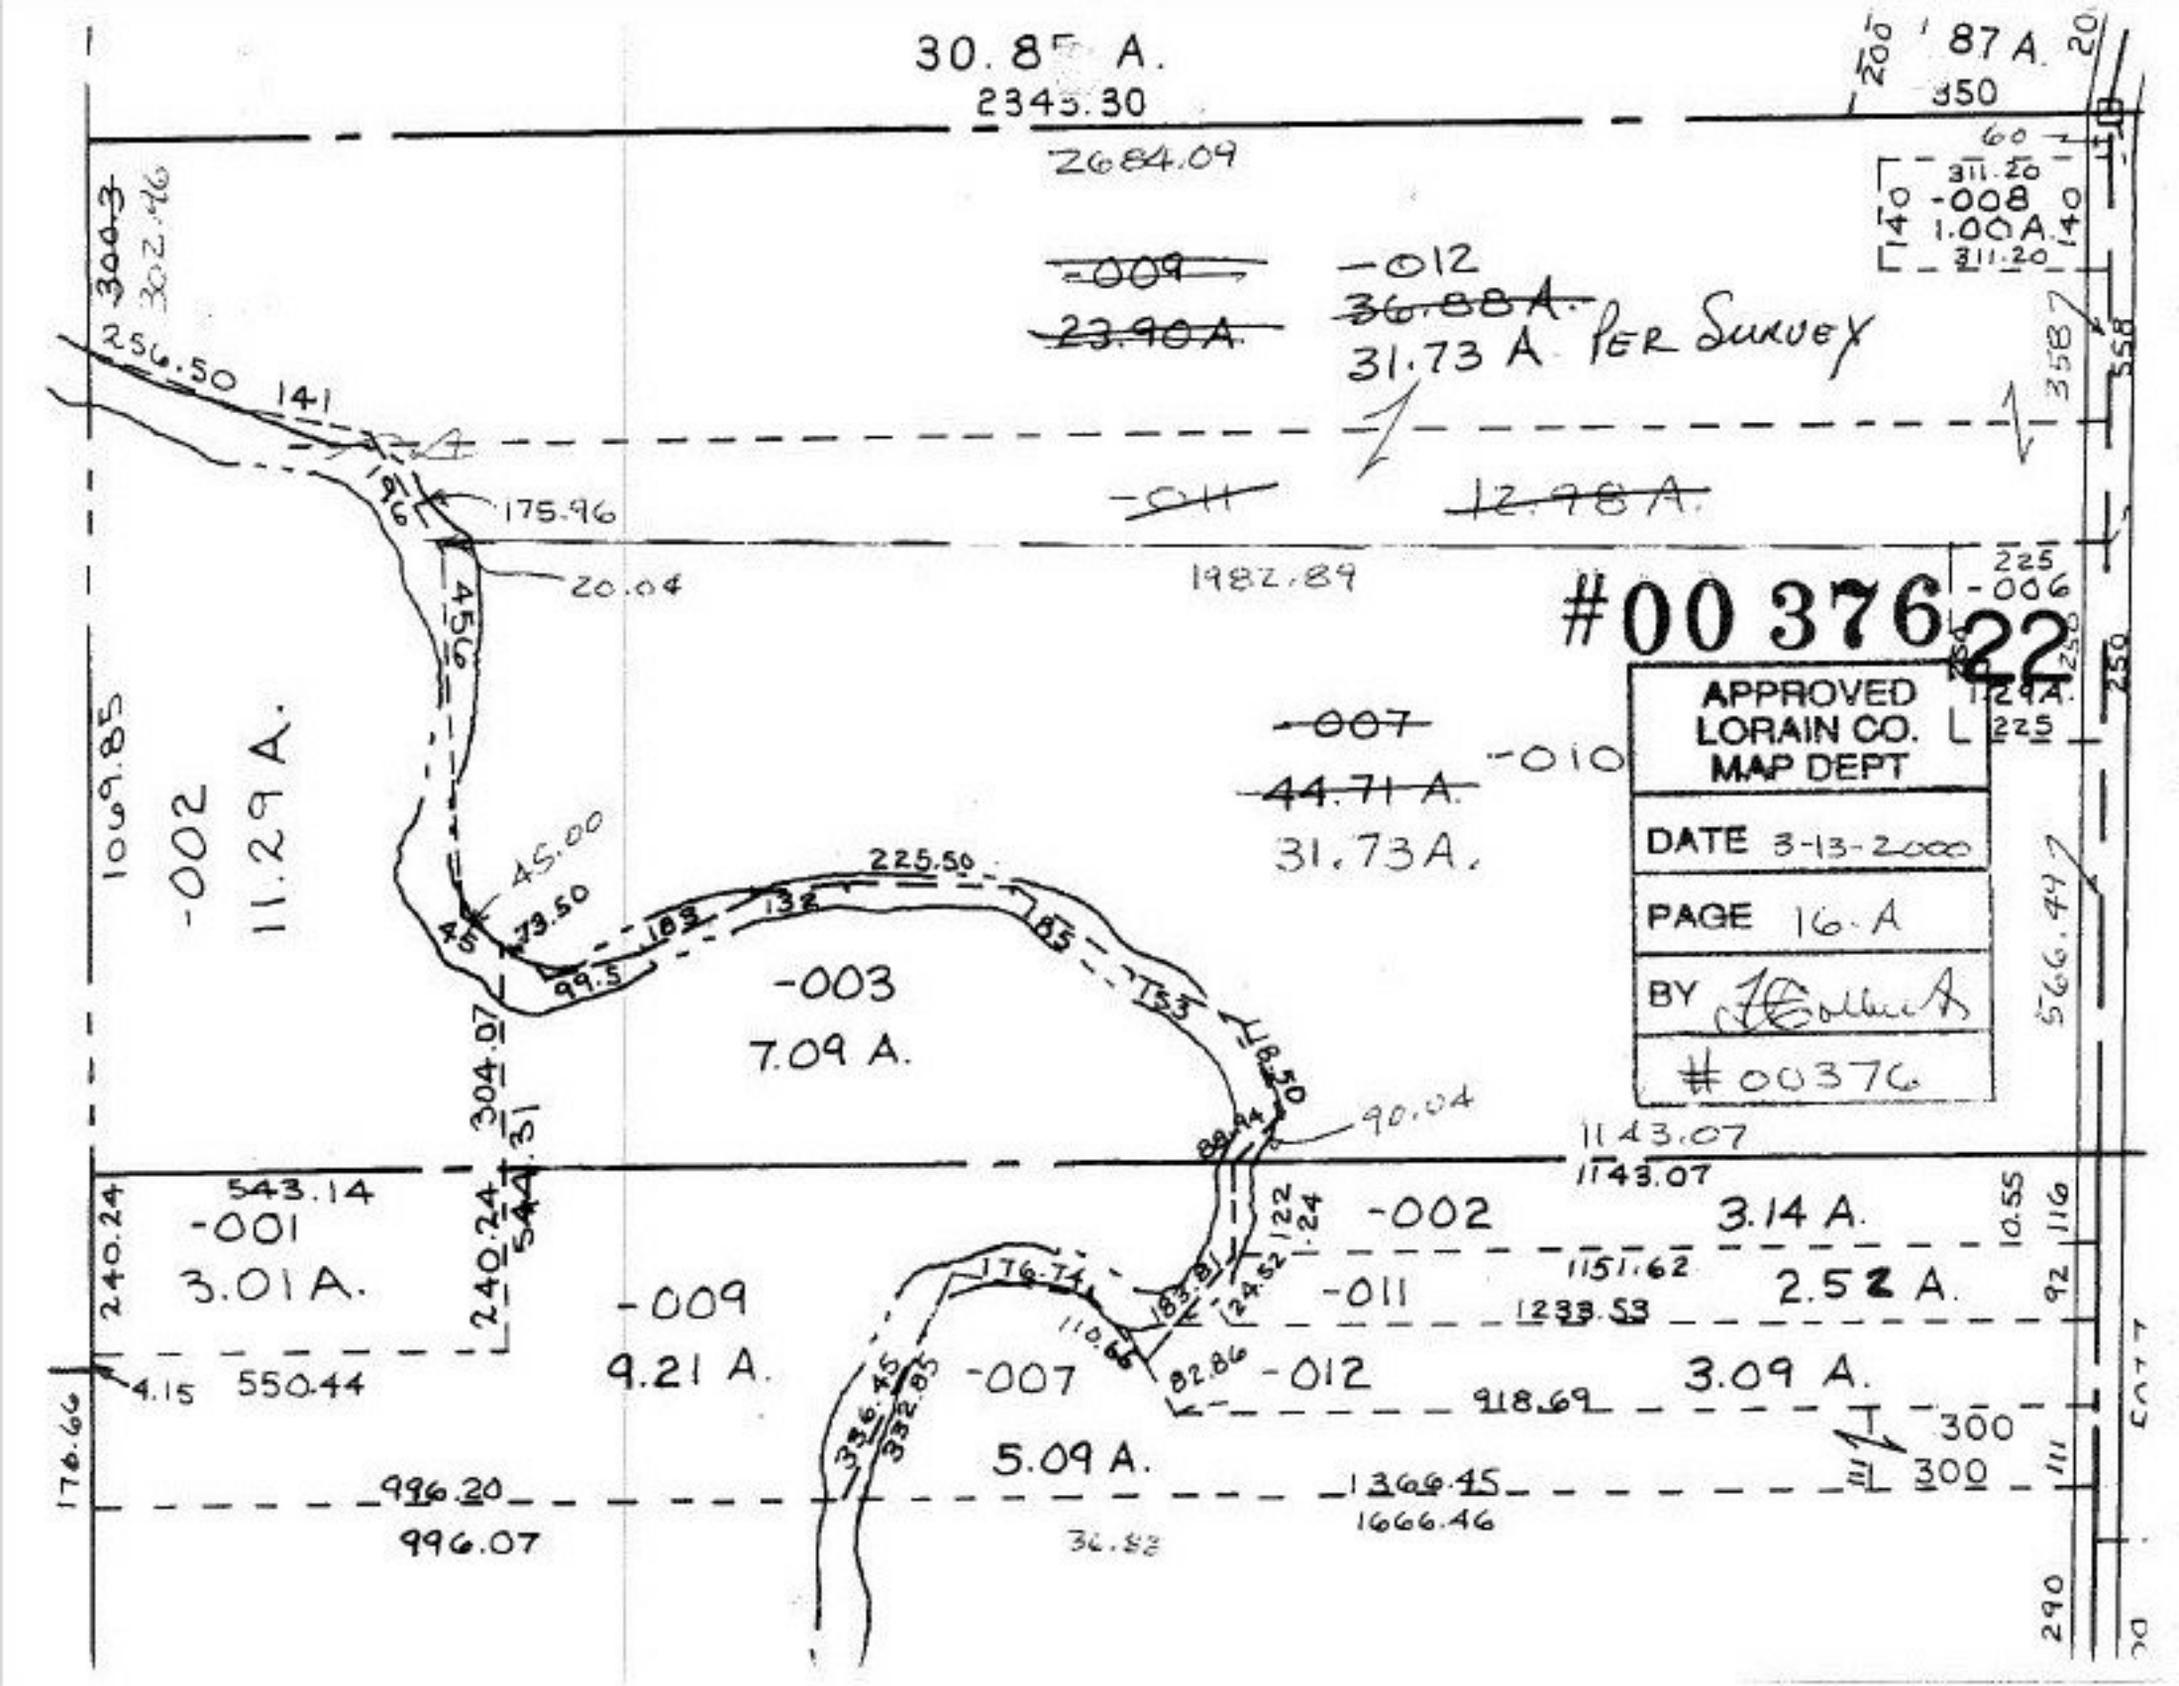
30.85 A.
2345.30
2684.09
87 A.
350
200
-009
23.90A
-012
36.88A.
31.73 A PER SURVEY
-011
12.78A.
1982.89
-008
1.00A
311.20
140
-006
11.29A
225
250
-007
44.71 A.
-010
31.73A.
#00376
APPROVED
LORAIN CO.
MAP DEPT
DATE 3-13-2000
PAGE 16-A
BY
#00376
-002
11.29 A.
-003
7.09 A.
-001
3.01A.
-009
9.21 A.
-007
5.09 A.
-002
3.14 A.
-011
2.52 A.
-012
3.09 A.
1143.07
1151.62
1233.53
918.69
1366.45
1666.46
996.20
996.07
550.44
543.14
544.31
304.07
240.24
1069.85
566.49
358
300
290
225.50
175.96
20.04
45.00
73.50
99.5
90.04
118.50
176.74
183.81
110.67
82.86
336.45
332.85
30.52