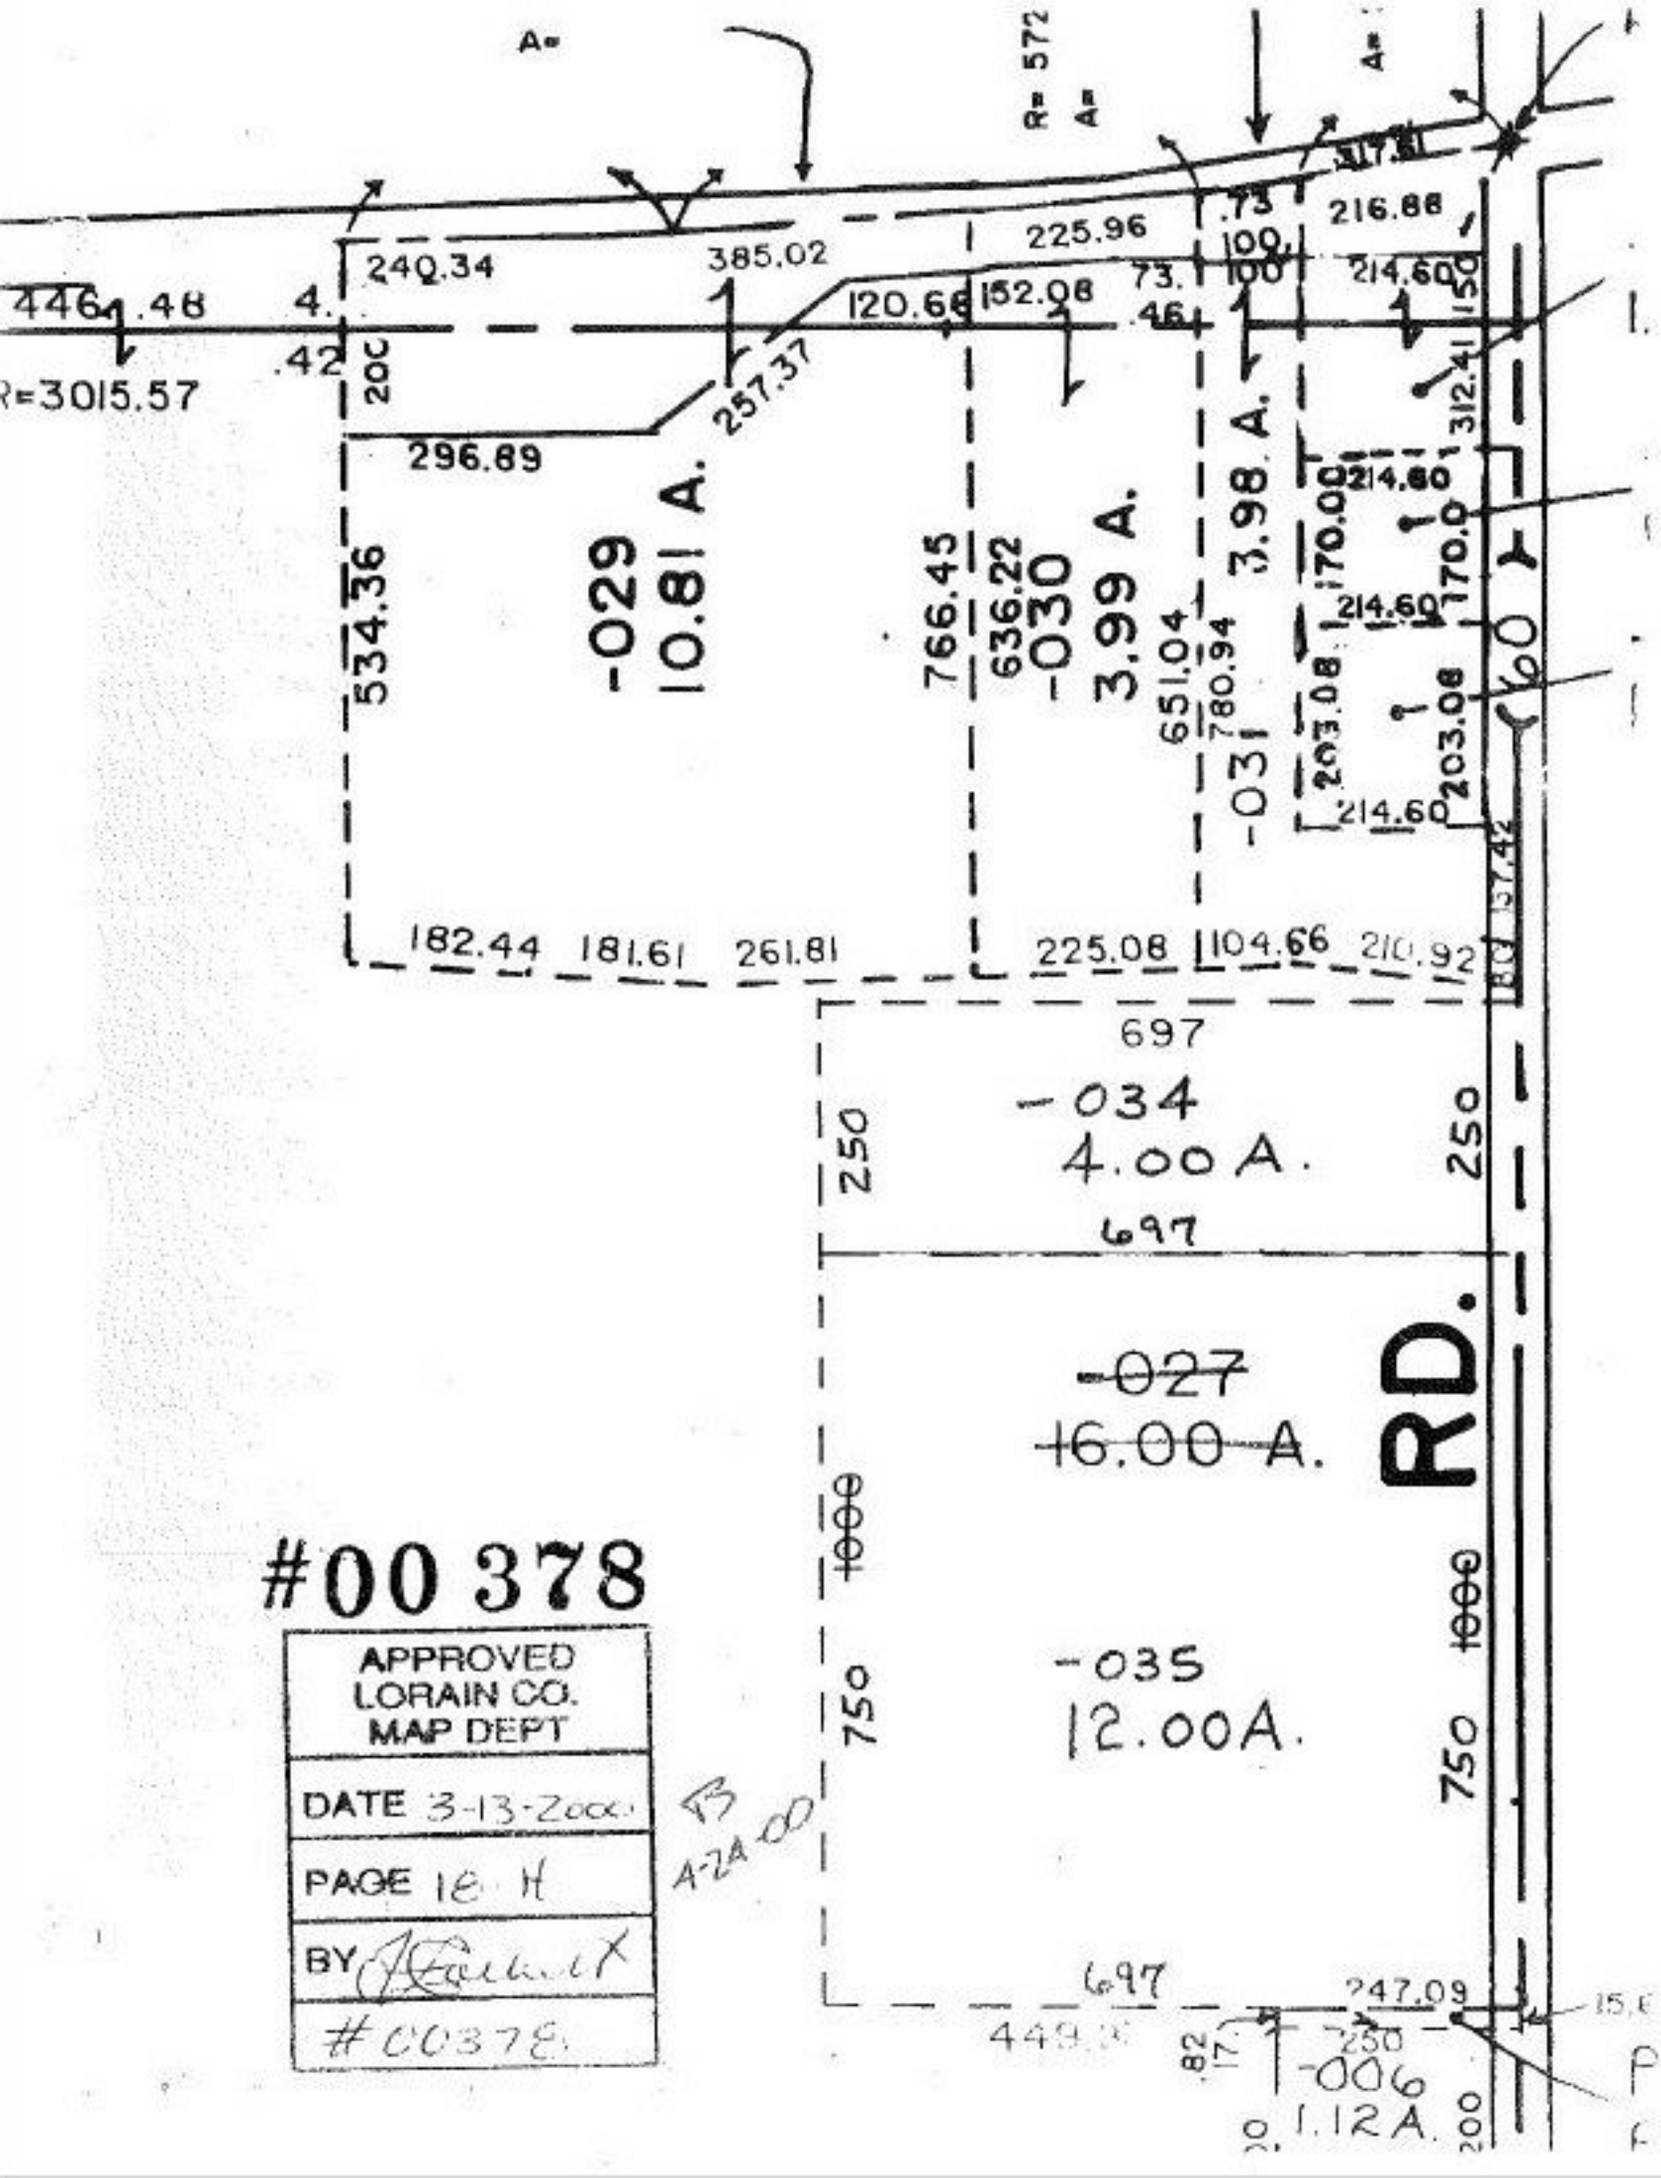

#00 378

APPROVED LORAIN CO. MAP DEPT
DATE 3-13-2000
PAGE 18 H
BY [signature]
#00378

B
A-2A 00