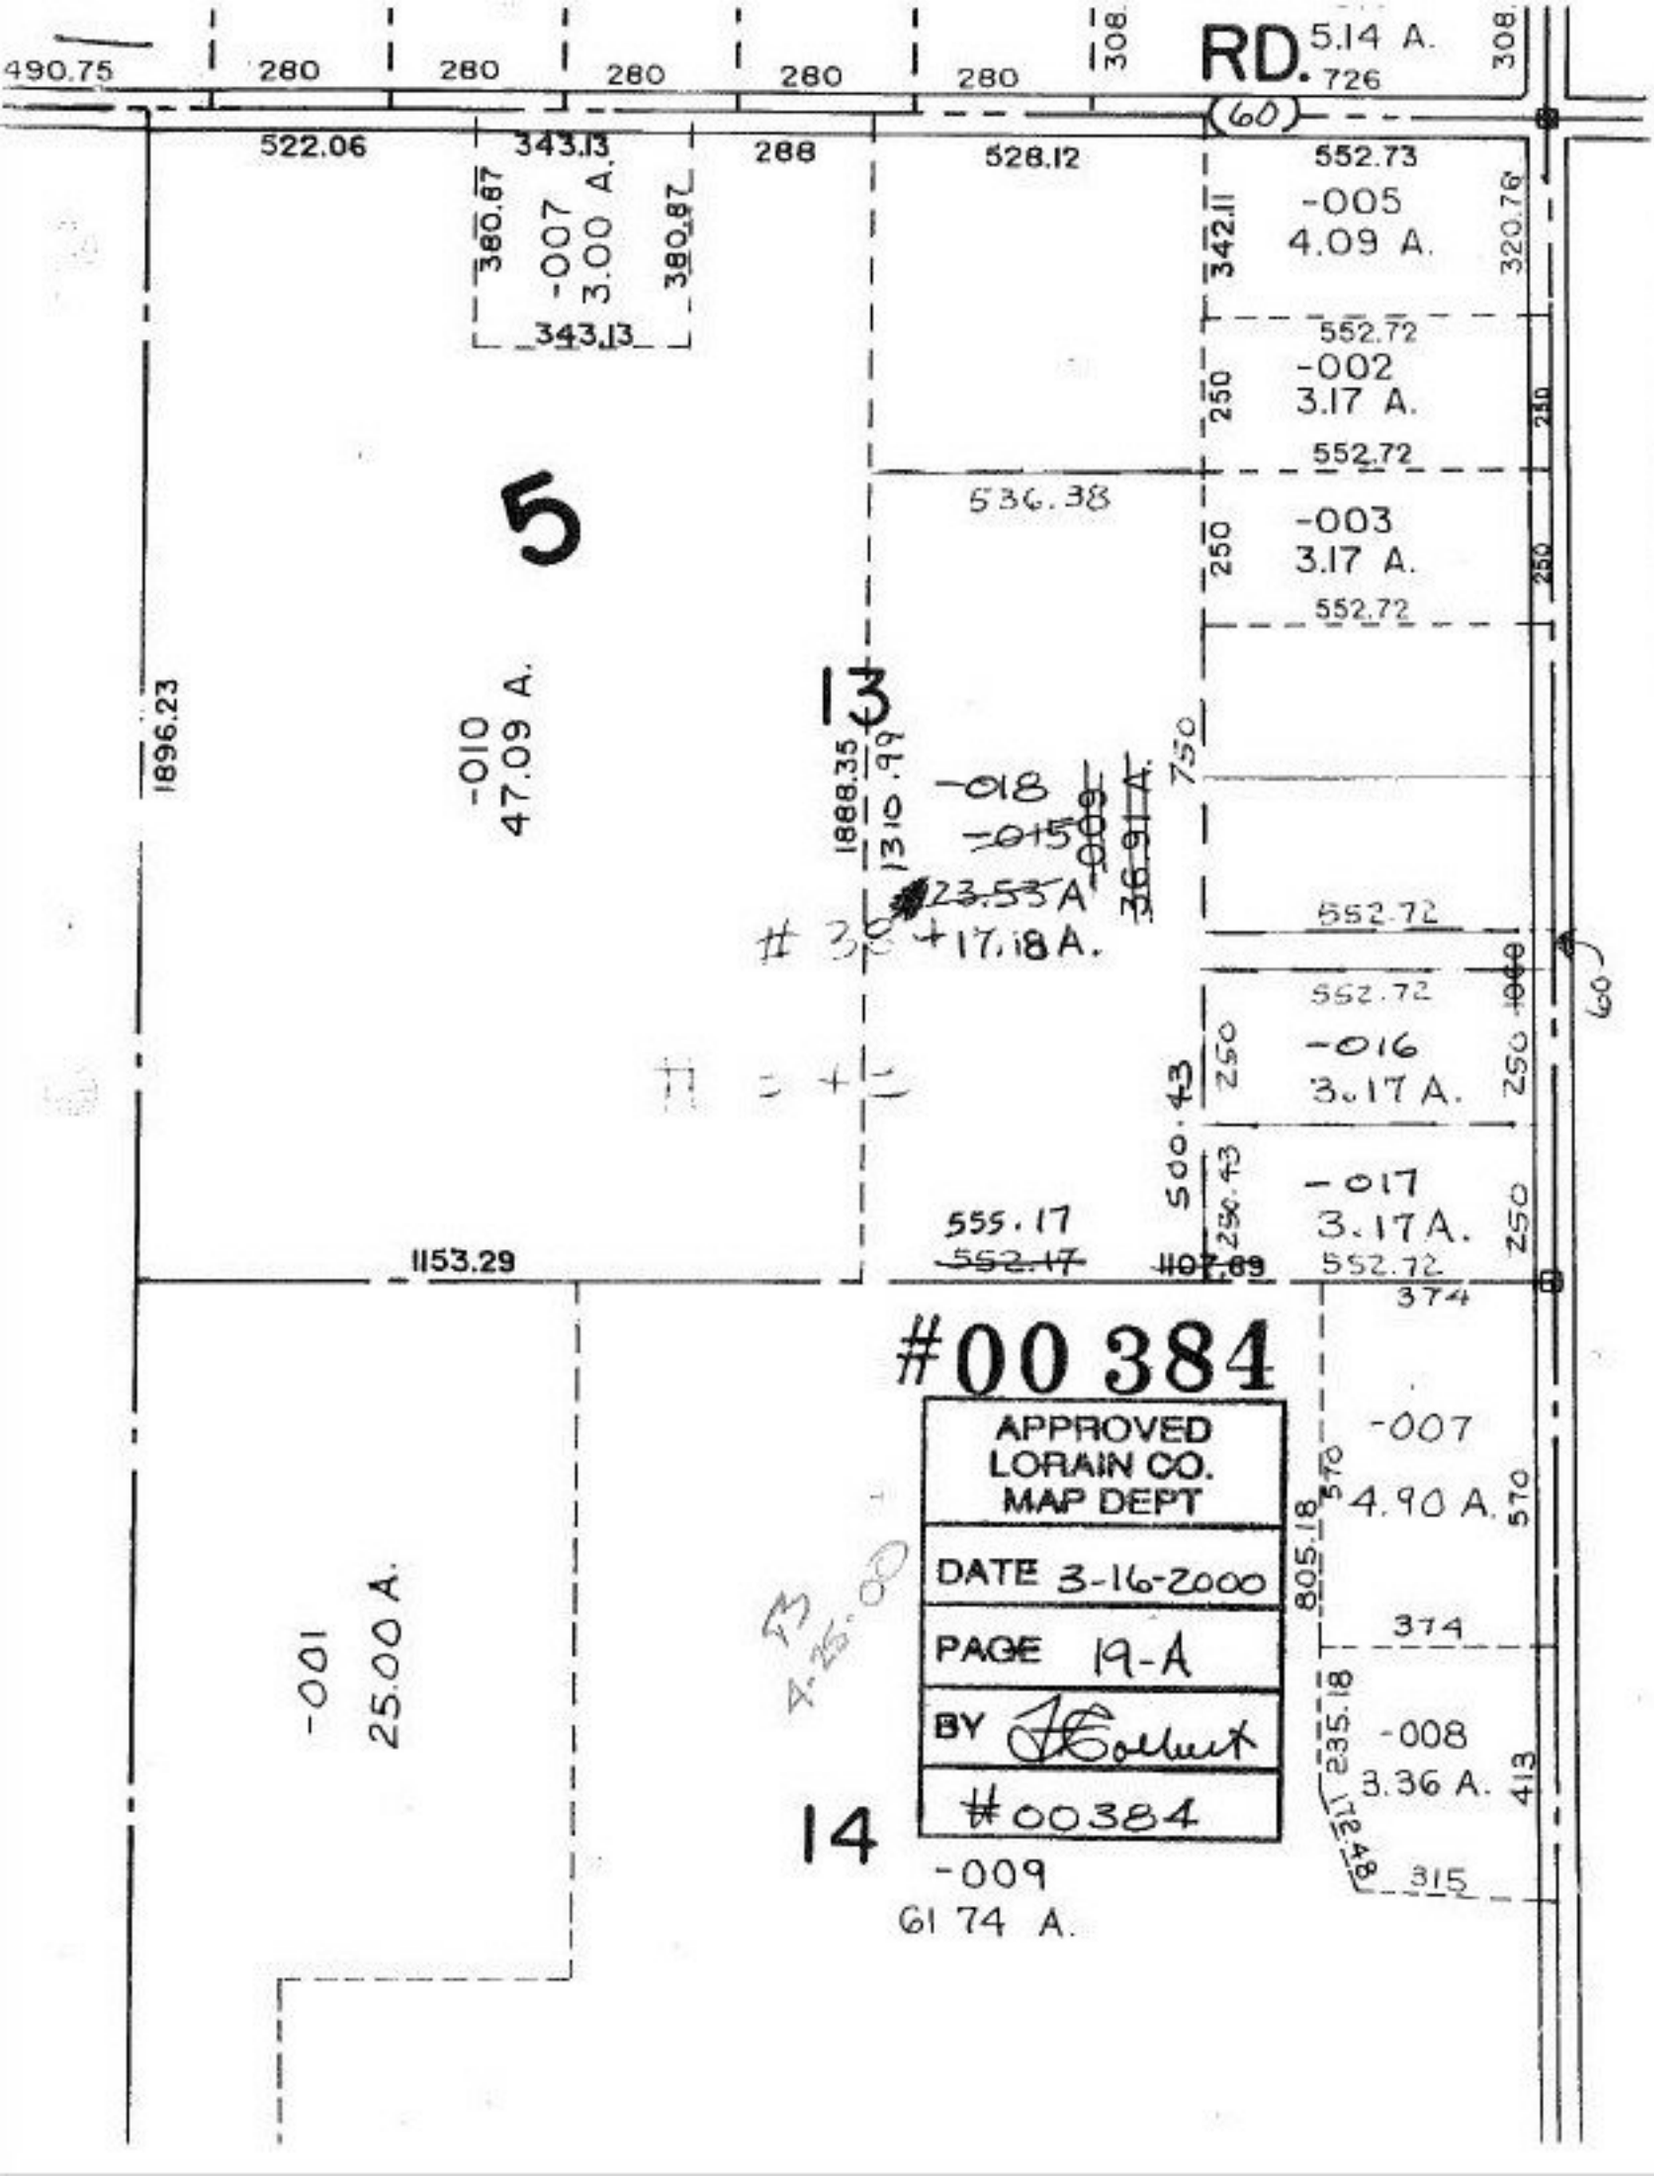

RD. 5.14 A.
490.75
280
280
280
280
280
308
308
726
(60)
522.06
343.13
288
528.12
552.73
380.87
-007
3.00 A.
380.87
343.13
342.11
-005
4.09 A.
320.76
552.72
-002
3.17 A.
250
552.72
536.38
5
-003
3.17 A.
250
552.72
1896.23
-010
47.09 A.
13
1888.35
1310.99
-018
-015
-009
36.91 A.
750
23.53 A
17.18 A.
552.72
552.72
-016
3.17 A.
250
500.43
250.43
-017
3.17 A.
555.17
552.17
1153.29
1107.69
552.72
374
#00 384
APPROVED
LORAIN CO.
MAP DEPT
DATE 3-16-2000
PAGE 19-A
BY
#00384
-007
4.90 A.
570
805.18
374
-001
25.00 A.
235.18
-008
3.36 A.
413
172.48
315
14
-009
61 74 A.