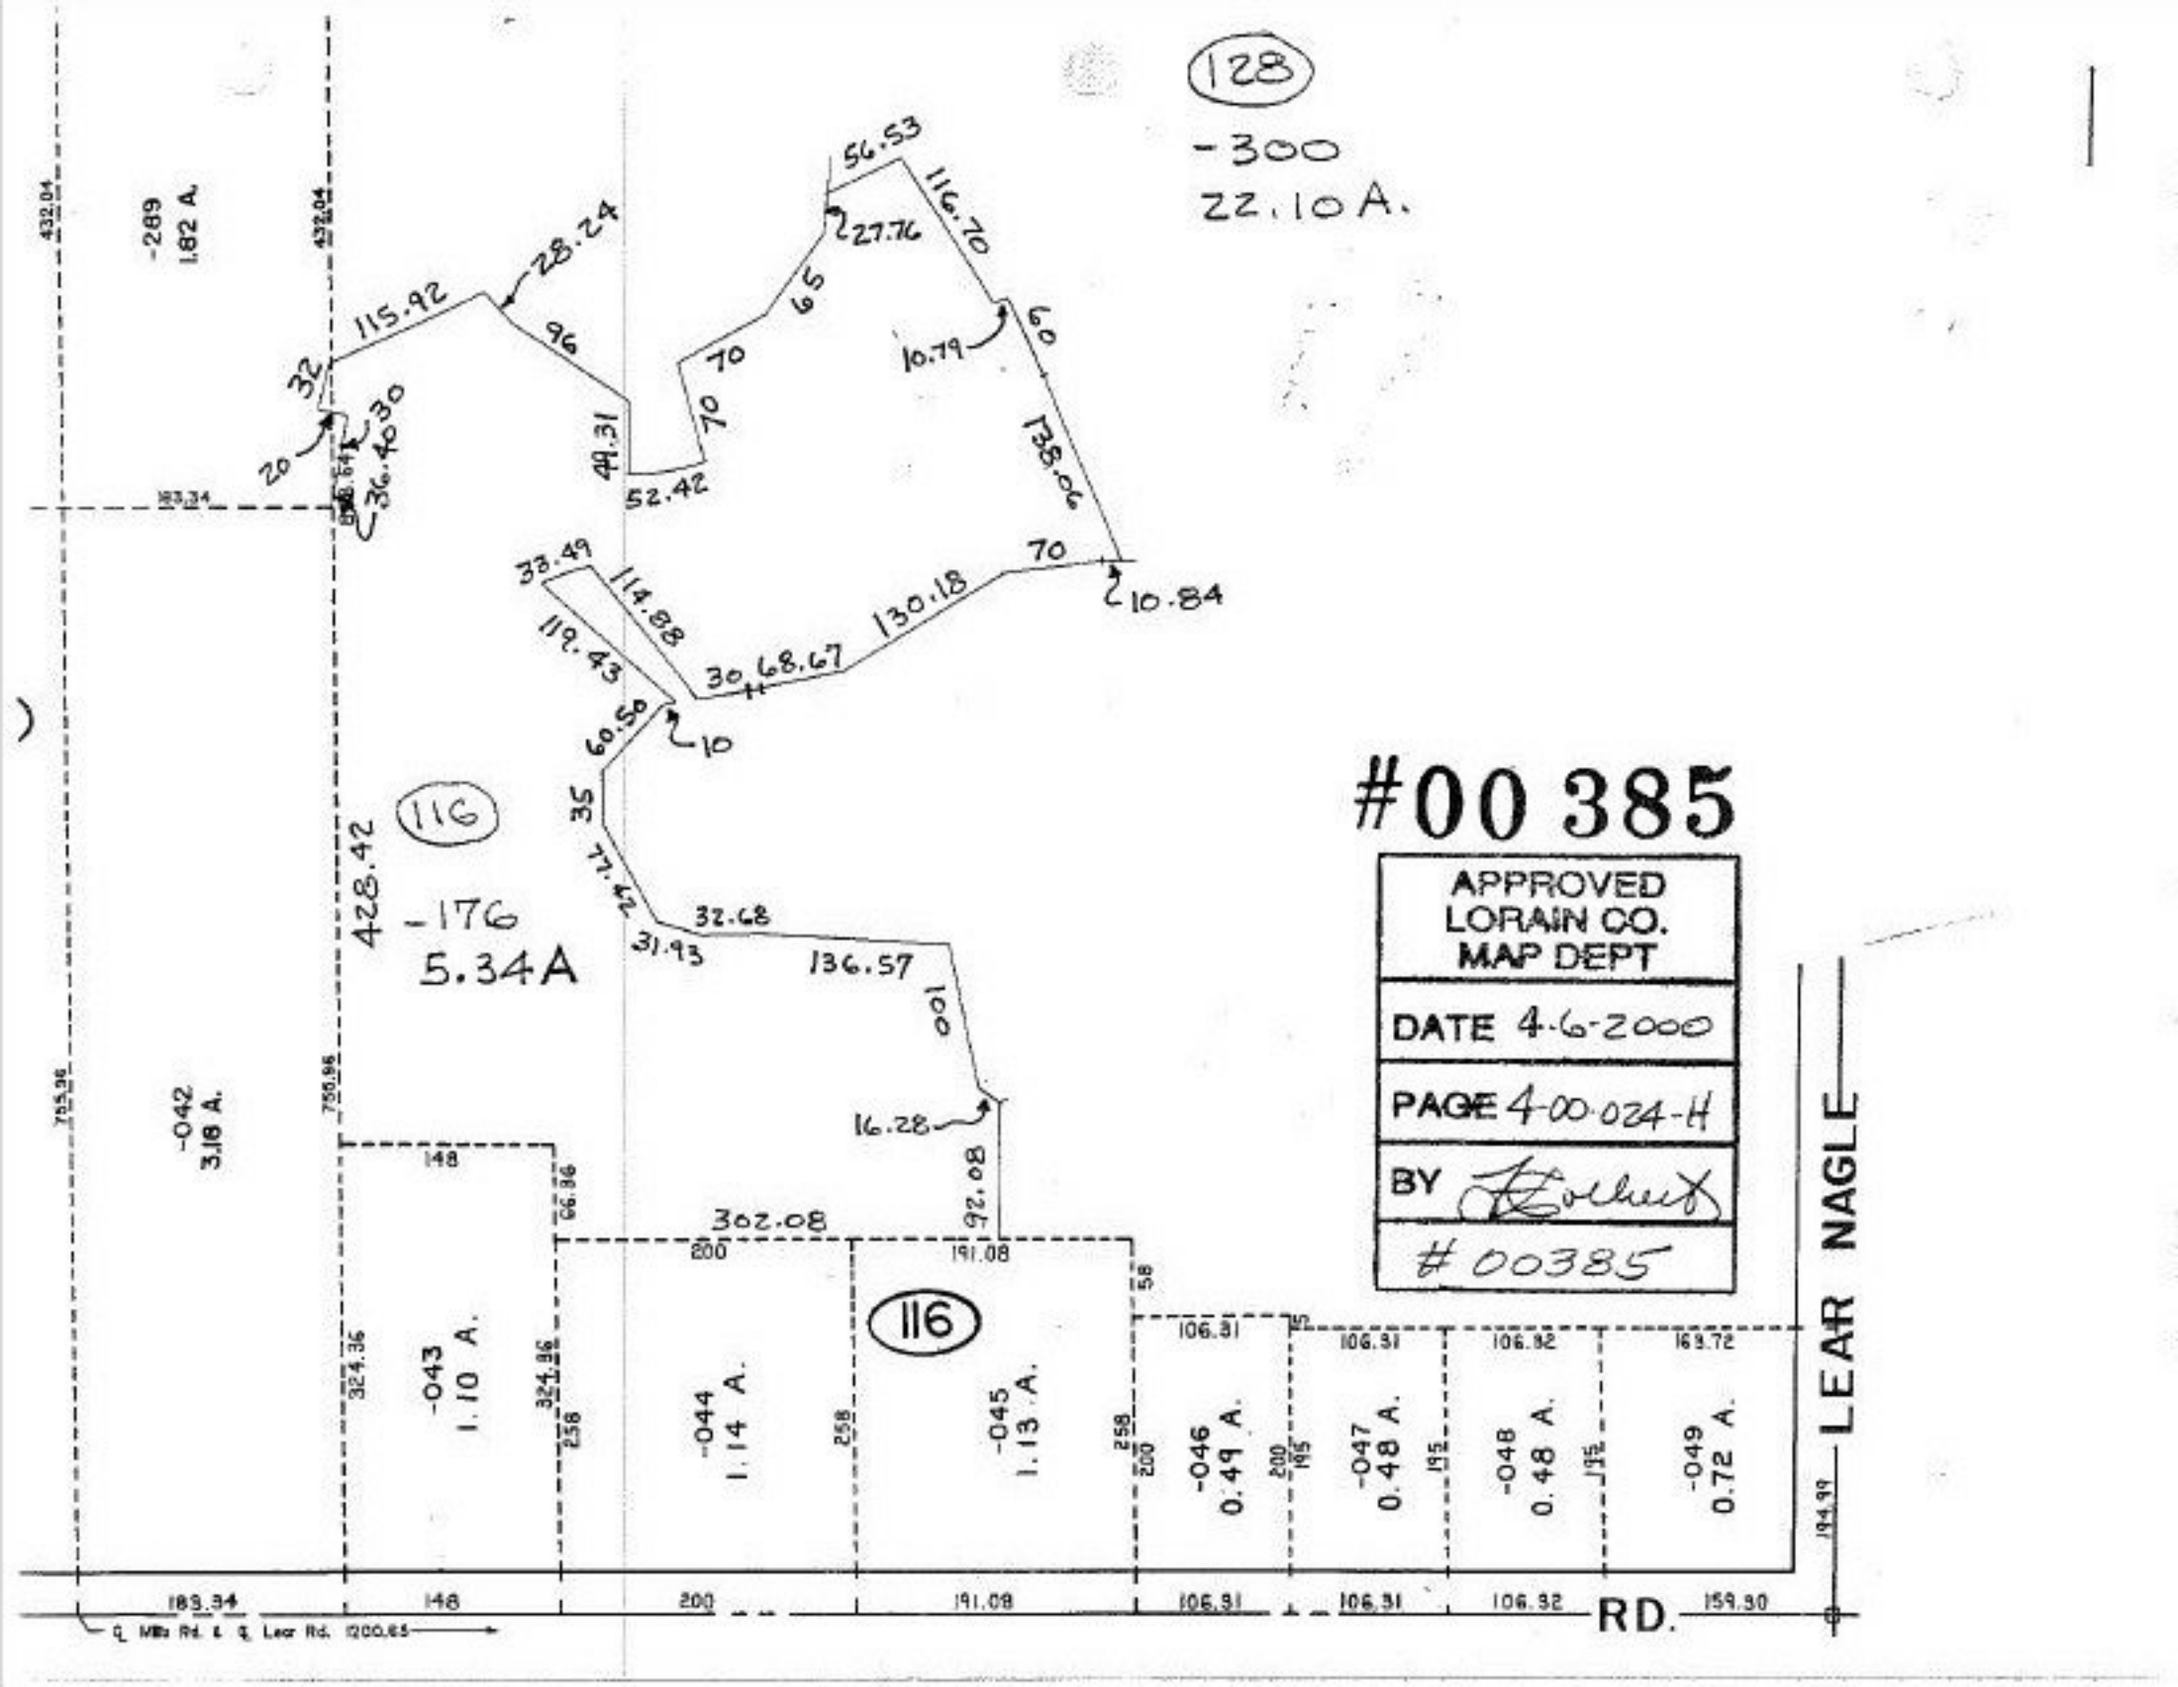
128
-300
22.10 A.
-289
1.82 A.
432.04
432.04
56.53
116.70
27.76
28.28
115.92
96
65
70
10.79
60
32
70
49.31
70
52.42
138.06
20
36.40
30
183.34
38.49
114.88
70
10.84
130.18
119.43
30
68.67
60.50
10
116
35
428.42
-176
5.34A
32.68
31.93
136.57
100
16.28
#00385
APPROVED
LORAIN CO.
MAP DEPT
DATE 4-6-2000
PAGE 4-00-024-H
BY
#00385
755.96
-042
3.18 A.
148
66.86
302.08
200
92.08
191.08
116
106.31
106.31
106.32
169.72
324.36
324.86
258
-043
1.10 A.
-044
1.14 A.
258
-045
1.13 A.
258
200
-046
0.49 A.
200
195
-047
0.48 A.
195
-048
0.48 A.
195
-049
0.72 A.
194.99
LEAR NAGLE
RD.
183.34
148
200
191.08
106.31
106.31
106.32
159.30
℄ Mills Rd. & ℄ Lear Rd. 1200.65