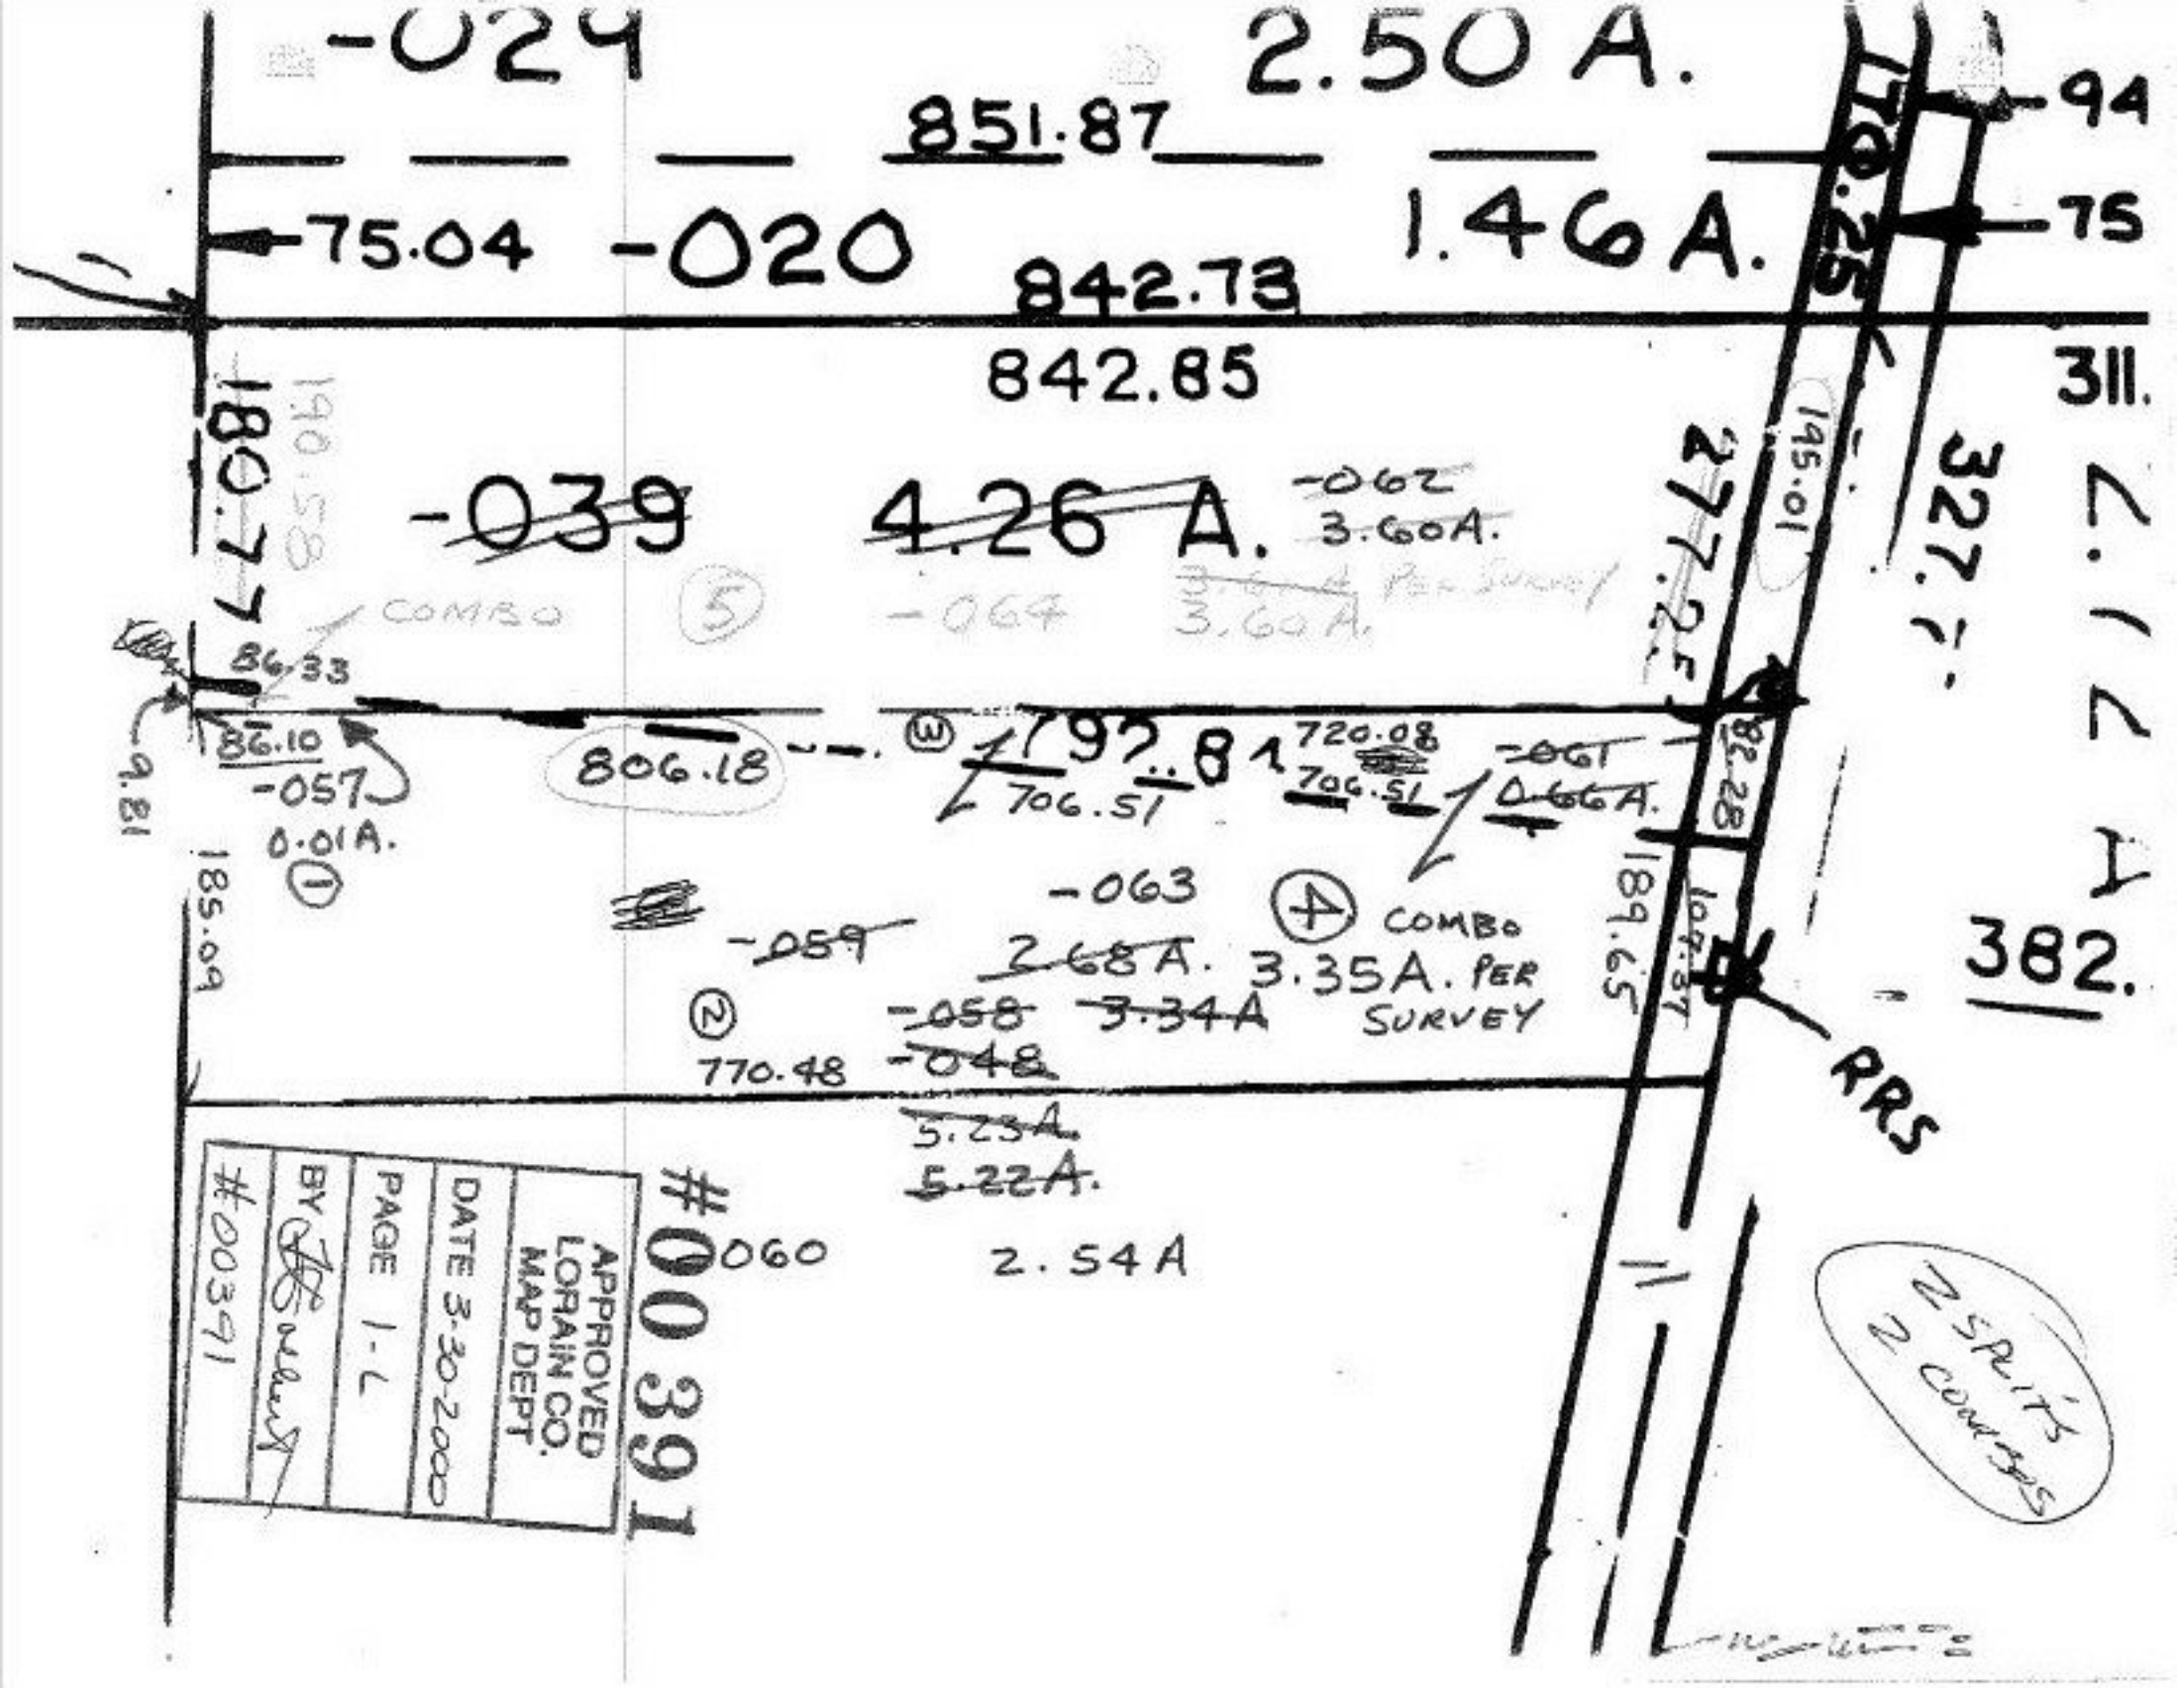
-024
2.50 A.
851.87
94
75.04
-020
1.46 A.
842.73
75
842.85
311.
180.71
-039
4.26 A.
-062
3.60A.
COMBO
5
-064
3.60 A. PER SURVEY
86.33
86.10
-057
0.01A.
1
9.81
185.09
806.18
3
792.81
706.51
720.08
706.51
-061
0.66A.
-063
4
COMBO
-059
2.68A.
3.35A. PER SURVEY
2
770.48
-058
3.34A
-048
5.23A.
5.22A.
#00391
060
2.54A
APPROVED
LORAIN CO.
MAP DEPT.
DATE 3-30-2000
PAGE 1-L
BY
#00391
RRS
