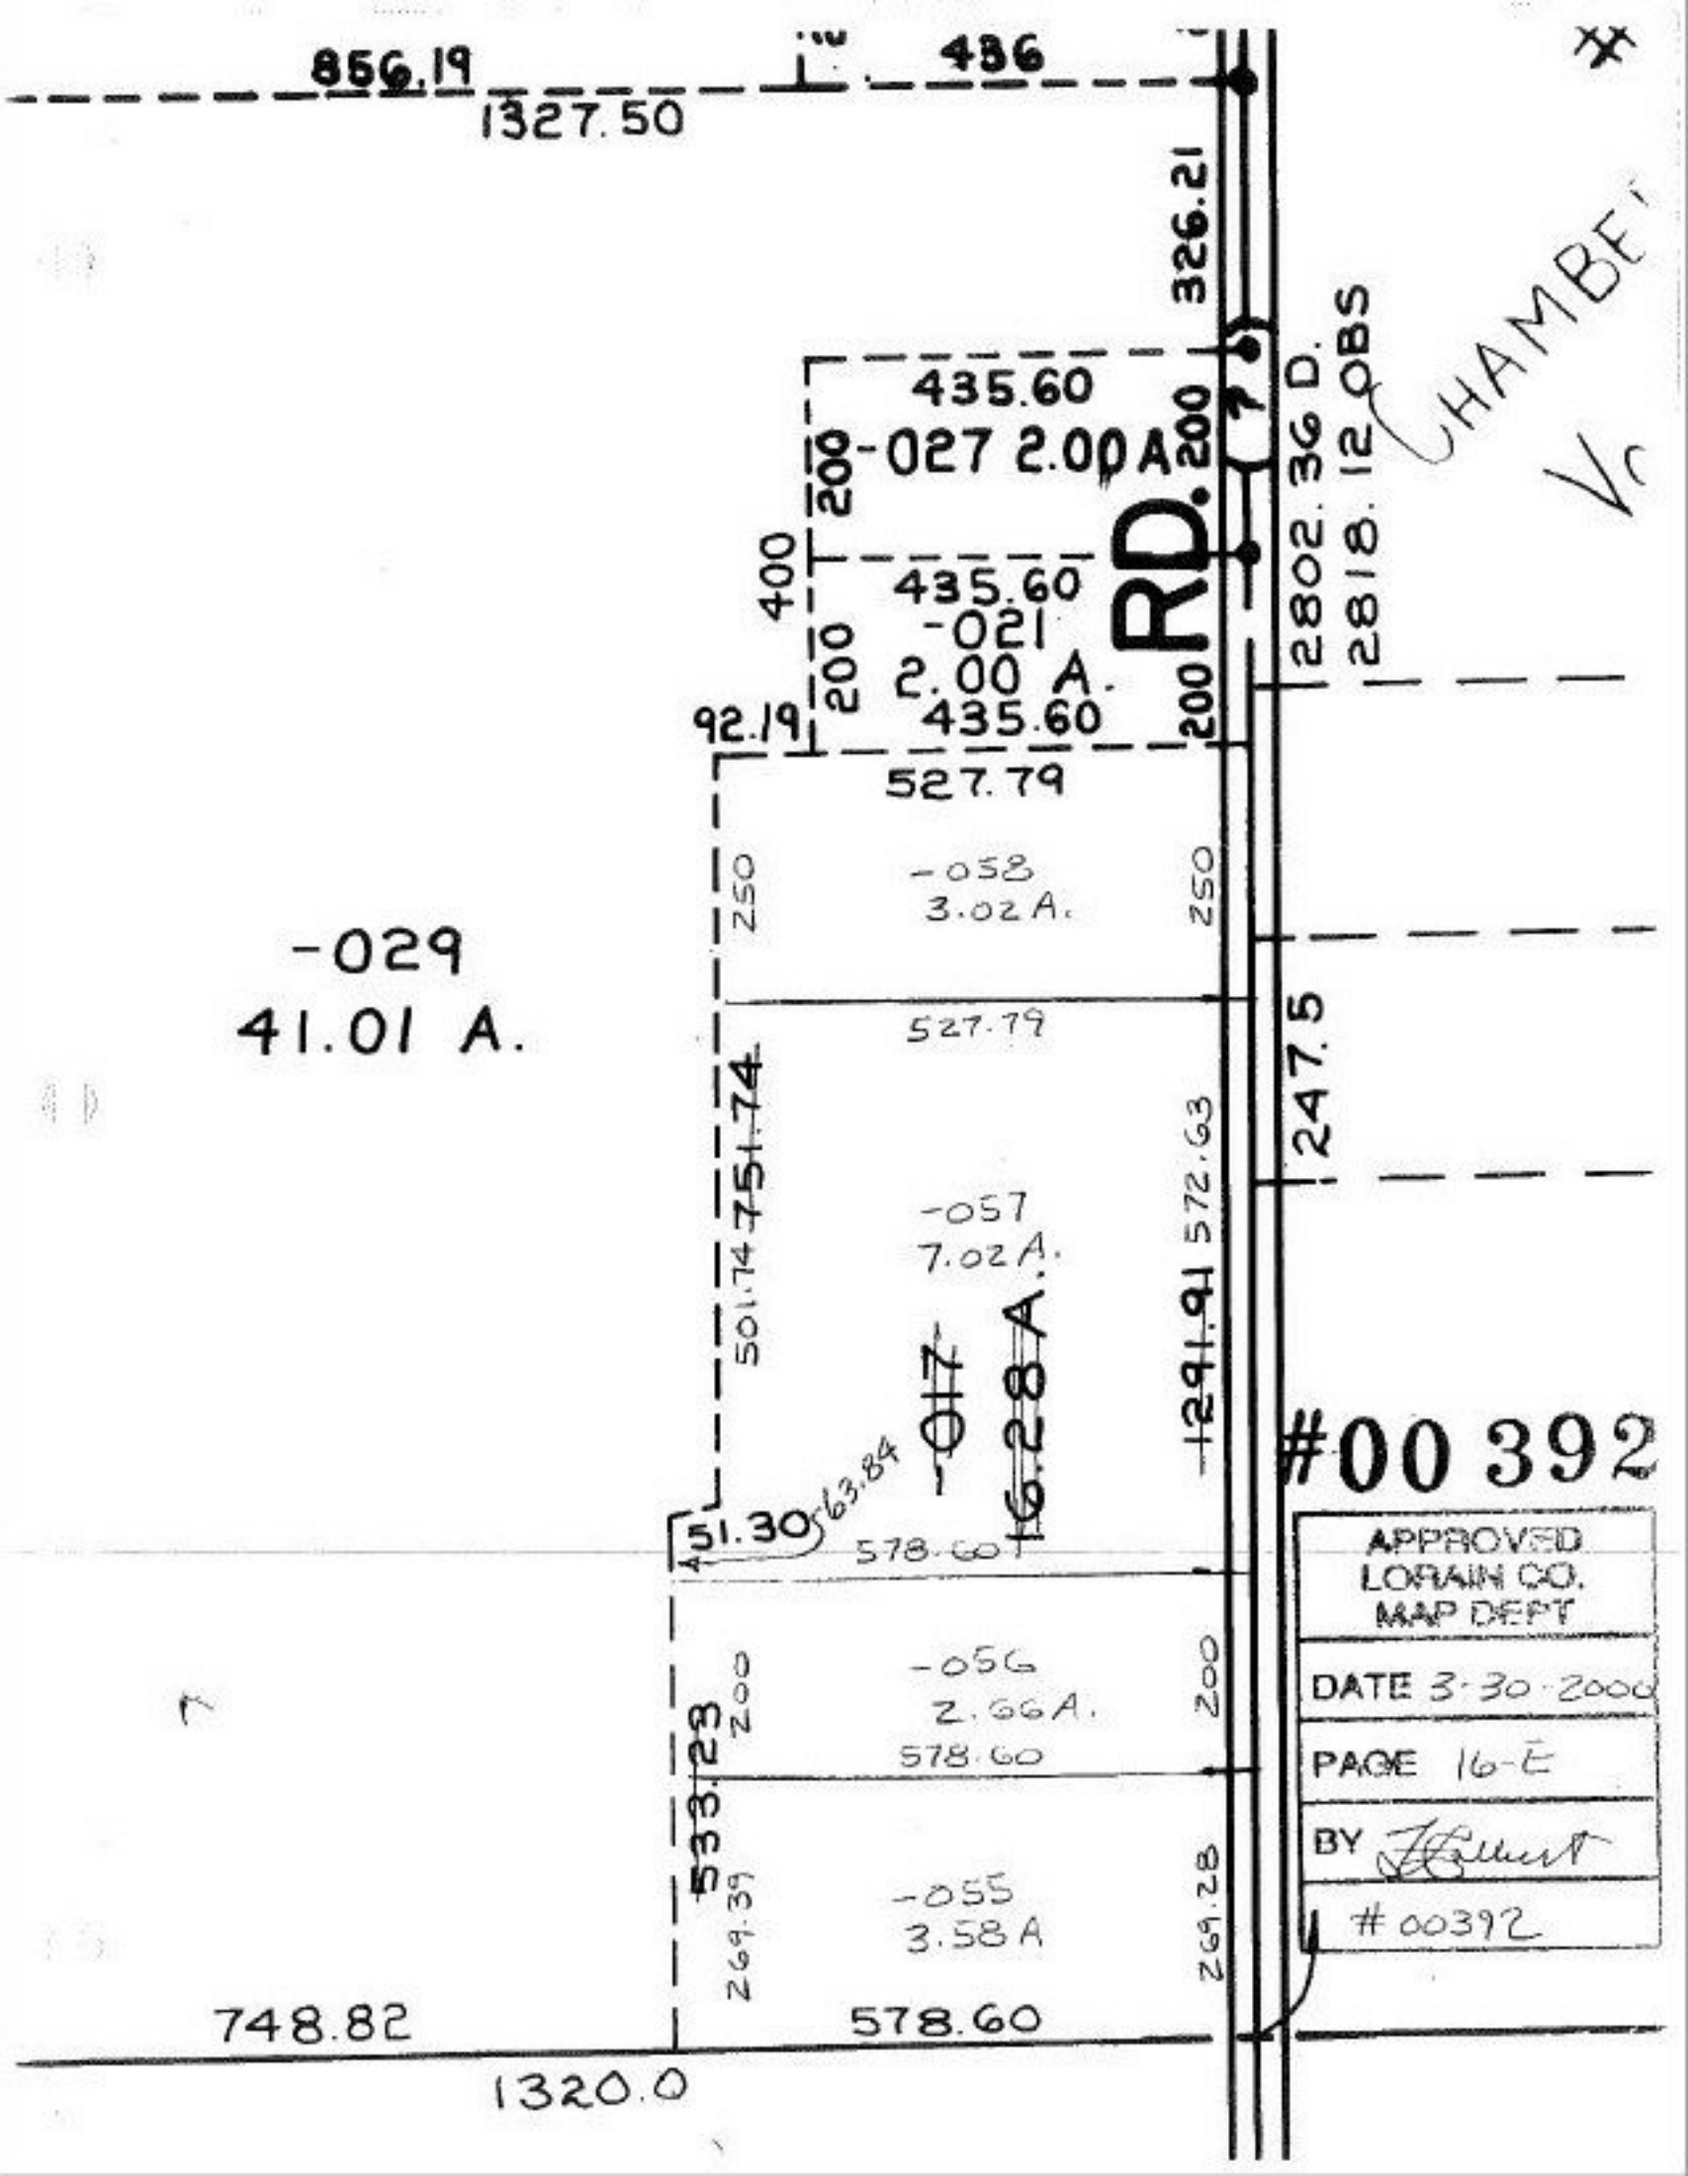
856.19
1327.50
436
326.21
435.60
-027 2.00 A
200
200
400
435.60
-021
2.00 A.
435.60
200
200
92.19
527.79
RD.
2802.36 D.
2818.12 OBS
CHAMBE
-058
3.02 A.
250
250
527.79
-029
41.01 A.
247.5
751.74
501.74
572.63
-057
7.02 A.
291.91
-017
6.28 A.
#00392
APPROVED
LORAIN CO.
MAP DEPT
DATE 3-30-2000
PAGE 16-E
BY
#00392
51.30
63.84
578.60
533.23
200
-056
2.66 A.
578.60
200
269.39
-055
3.58 A
269.28
748.82
578.60
1320.0