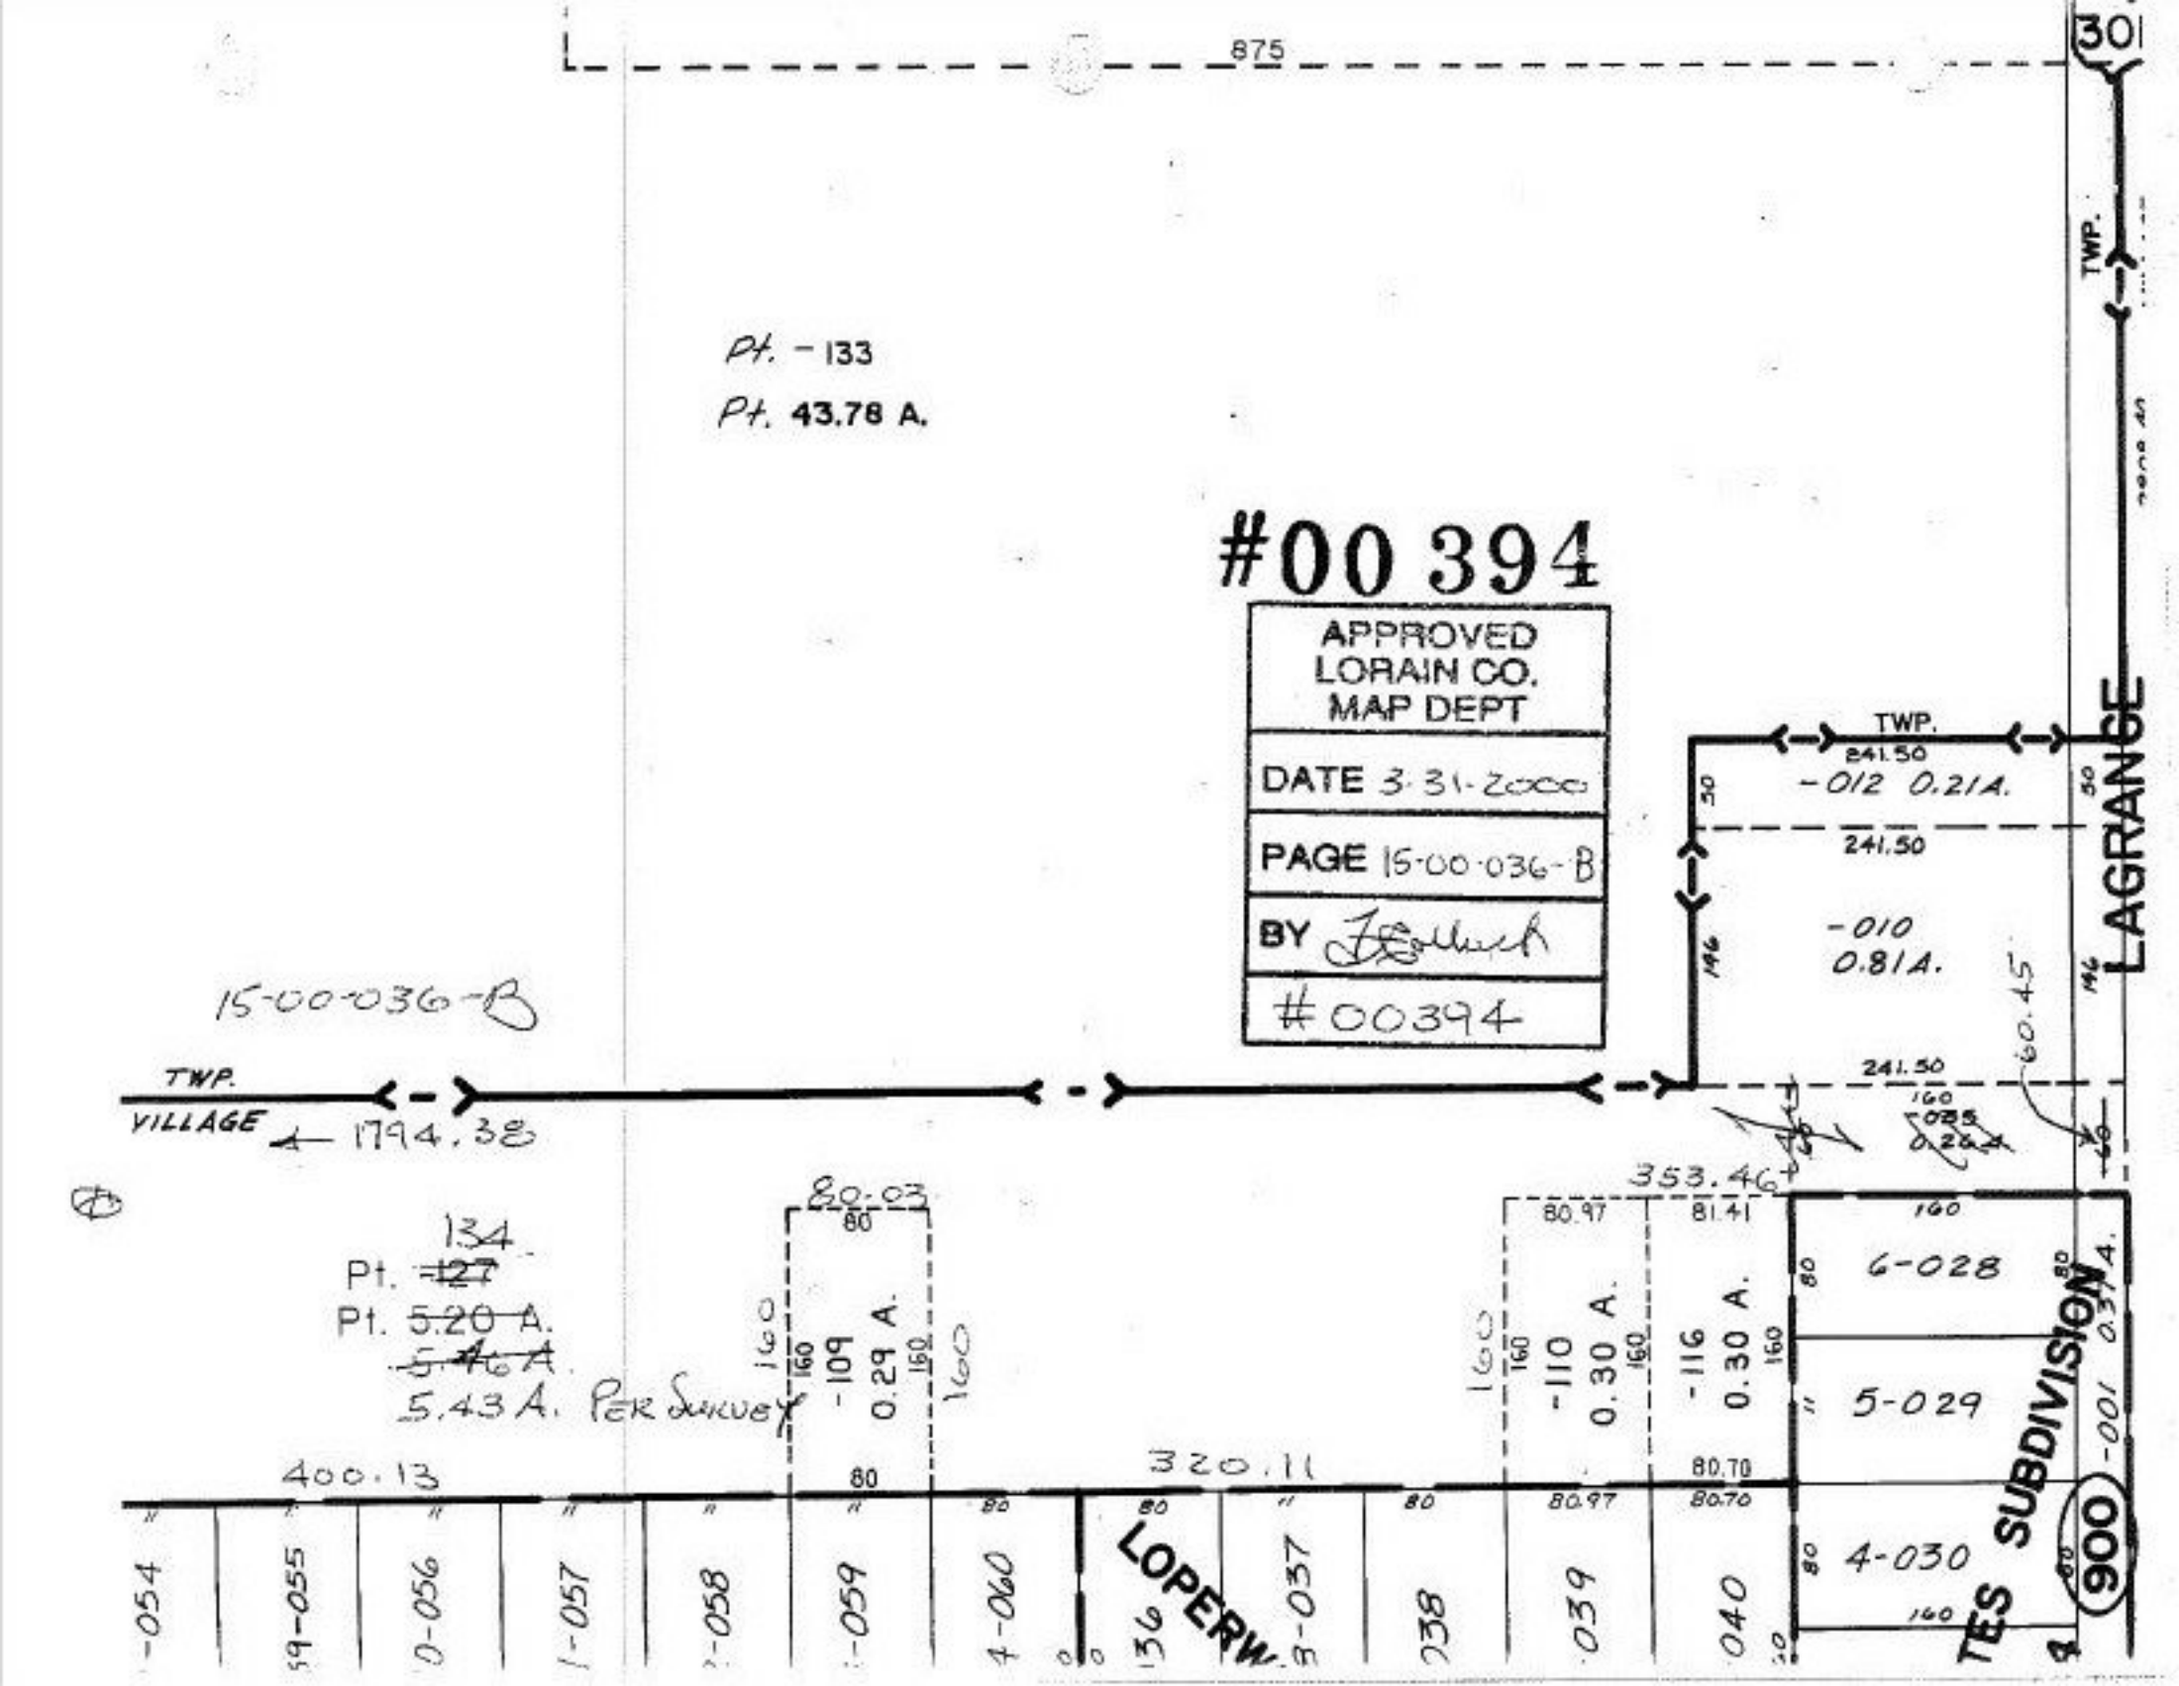
875
30
TWP.
Pt. - 133
Pt. 43.78 A.
#00394
APPROVED
LORAIN CO.
MAP DEPT
DATE 3-31-2000
PAGE 15-00-036-B
BY
#00394
15-00-036-B
TWP.
VILLAGE
1794.38
LAGRANGE
TWP.
241.50
-012 0.21A.
241.50
-010
0.81A.
146
60.45
241.50
353.46
134
Pt. -127
Pt. 5.20 A.
5.46 A.
5.43 A. PER SURVEY
80.03
80
160
-109
0.29 A.
160
100
100
80.97
81.41
-110
0.30 A.
-116
0.30 A.
160
6-028
5-029
4-030
400.13
320.11
80.70
80.97
LOPER
TES SUBDIVISION
900
-001
-054
-055
-056
-057
-058
-059
4-060
136
3-037
238
039
040