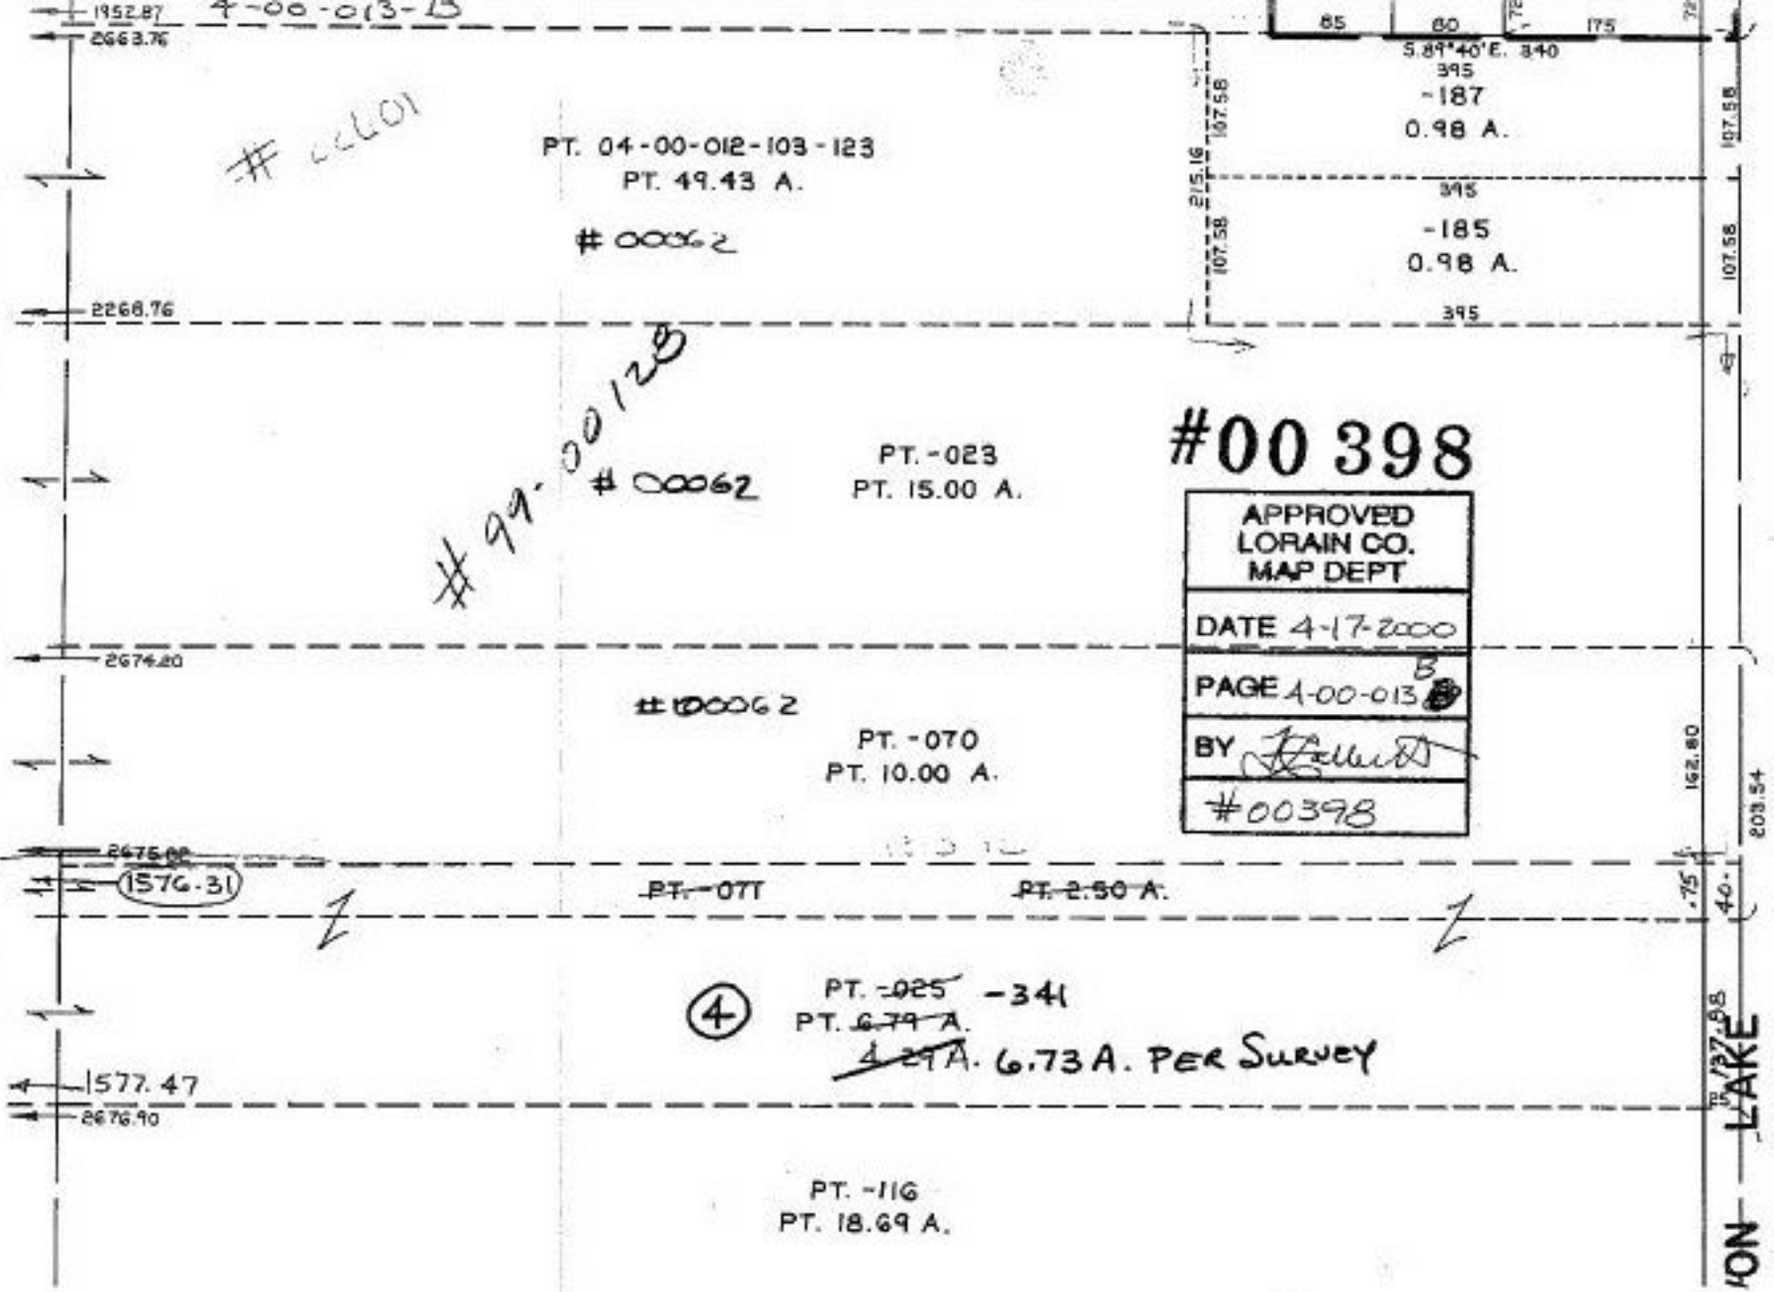
4-00-013-B
1952.87
2663.76
00062
PT. 04-00-012-103-123
PT. 49.43 A.
00062
2268.76
99-00128
00062
PT. -023
PT. 15.00 A.
#00 398
APPROVED
LORAIN CO.
MAP DEPT
DATE 4-17-2000
PAGE 4-00-013 B
BY
#00398
2674.20
00062
PT. -070
PT. 10.00 A.
2675.00
1576.31
PT. -071
PT. 2.50 A.
4
PT. -025 -341
PT. 6.79 A.
4.29 A. 6.73 A. PER SURVEY
1577.47
2676.90
PT. -116
PT. 18.69 A.
S.89°40'E. 840
395
-187
0.98 A.
395
-185
0.98 A.
395
215.16
107.58
107.58
107.58
107.58
85
60
175
162.80
203.54
40.
.75
137.88
ON LAKE