


SPLIT # 99-00230
 0-011-102-088 INTO
 -00-011-102-102, 103

SPLIT # 99-00307
 11-102-053, 072, 087, 103
 13-00-011-102-104, 105.

99-00304
 -102-057, 058, 105
 0-011-102-106, 107

99-00406
 02-029, 047
 1-102-108, 109

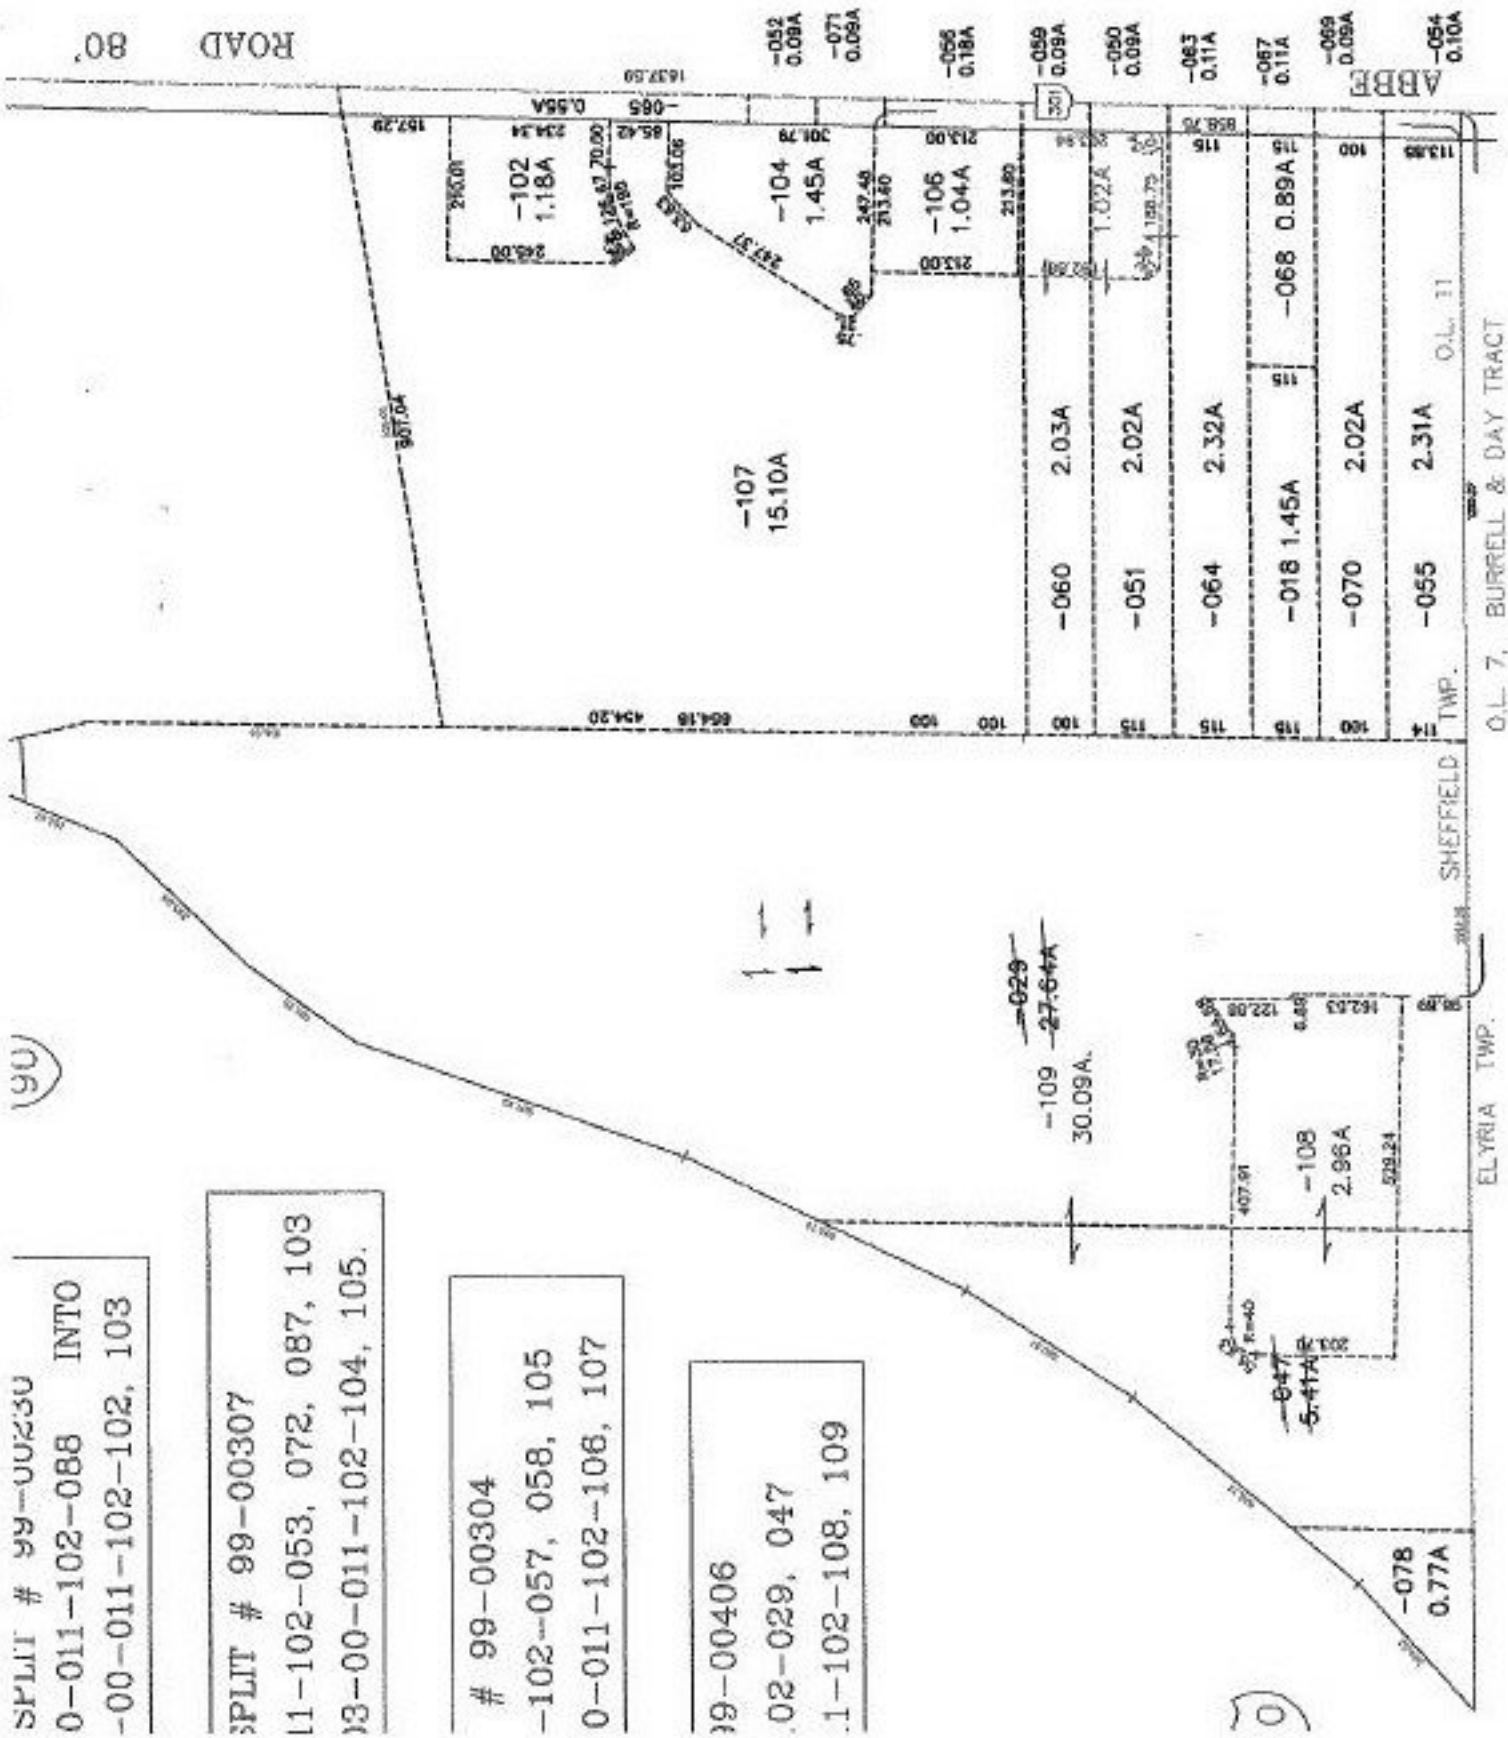

(90)

(0)