54

-025 ✓
~~-003~~
~~93.59 A.~~
92.39 A.

#00 407

APPROVED
LORAIN CO.
MAP DEPT

DATE 4-20-2000

PAGE 1-K

BY [signature]
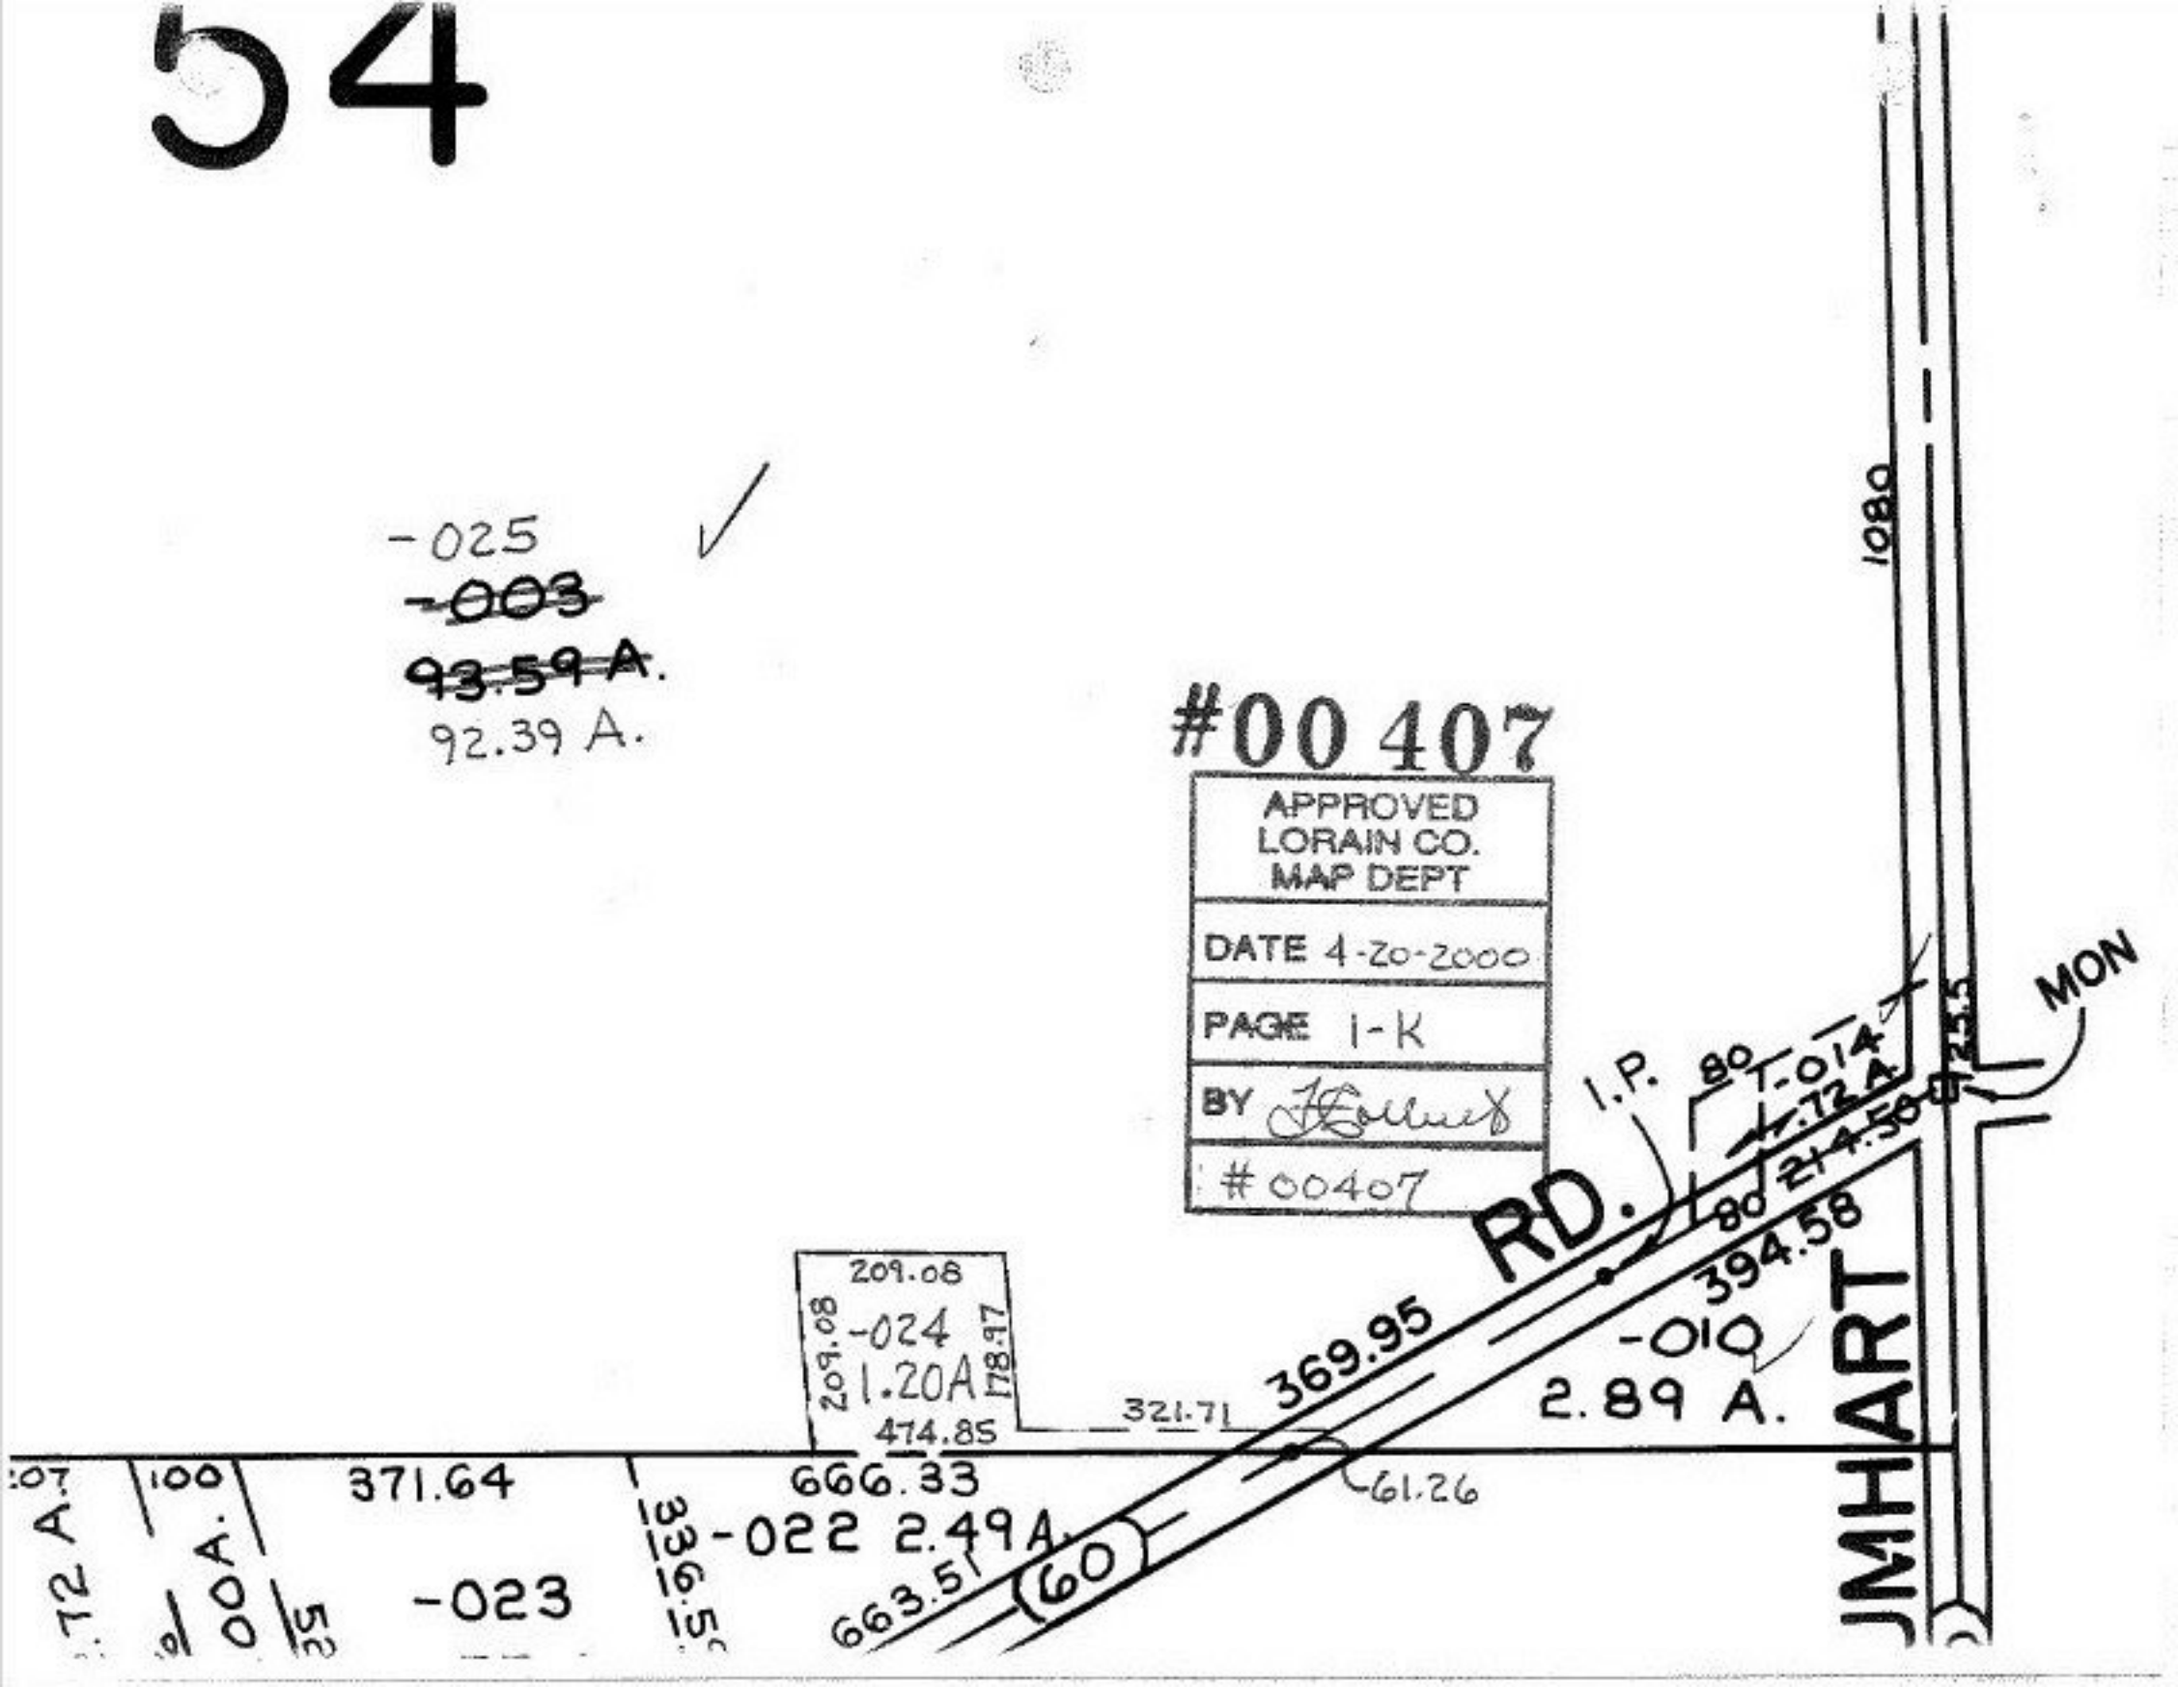
#00407