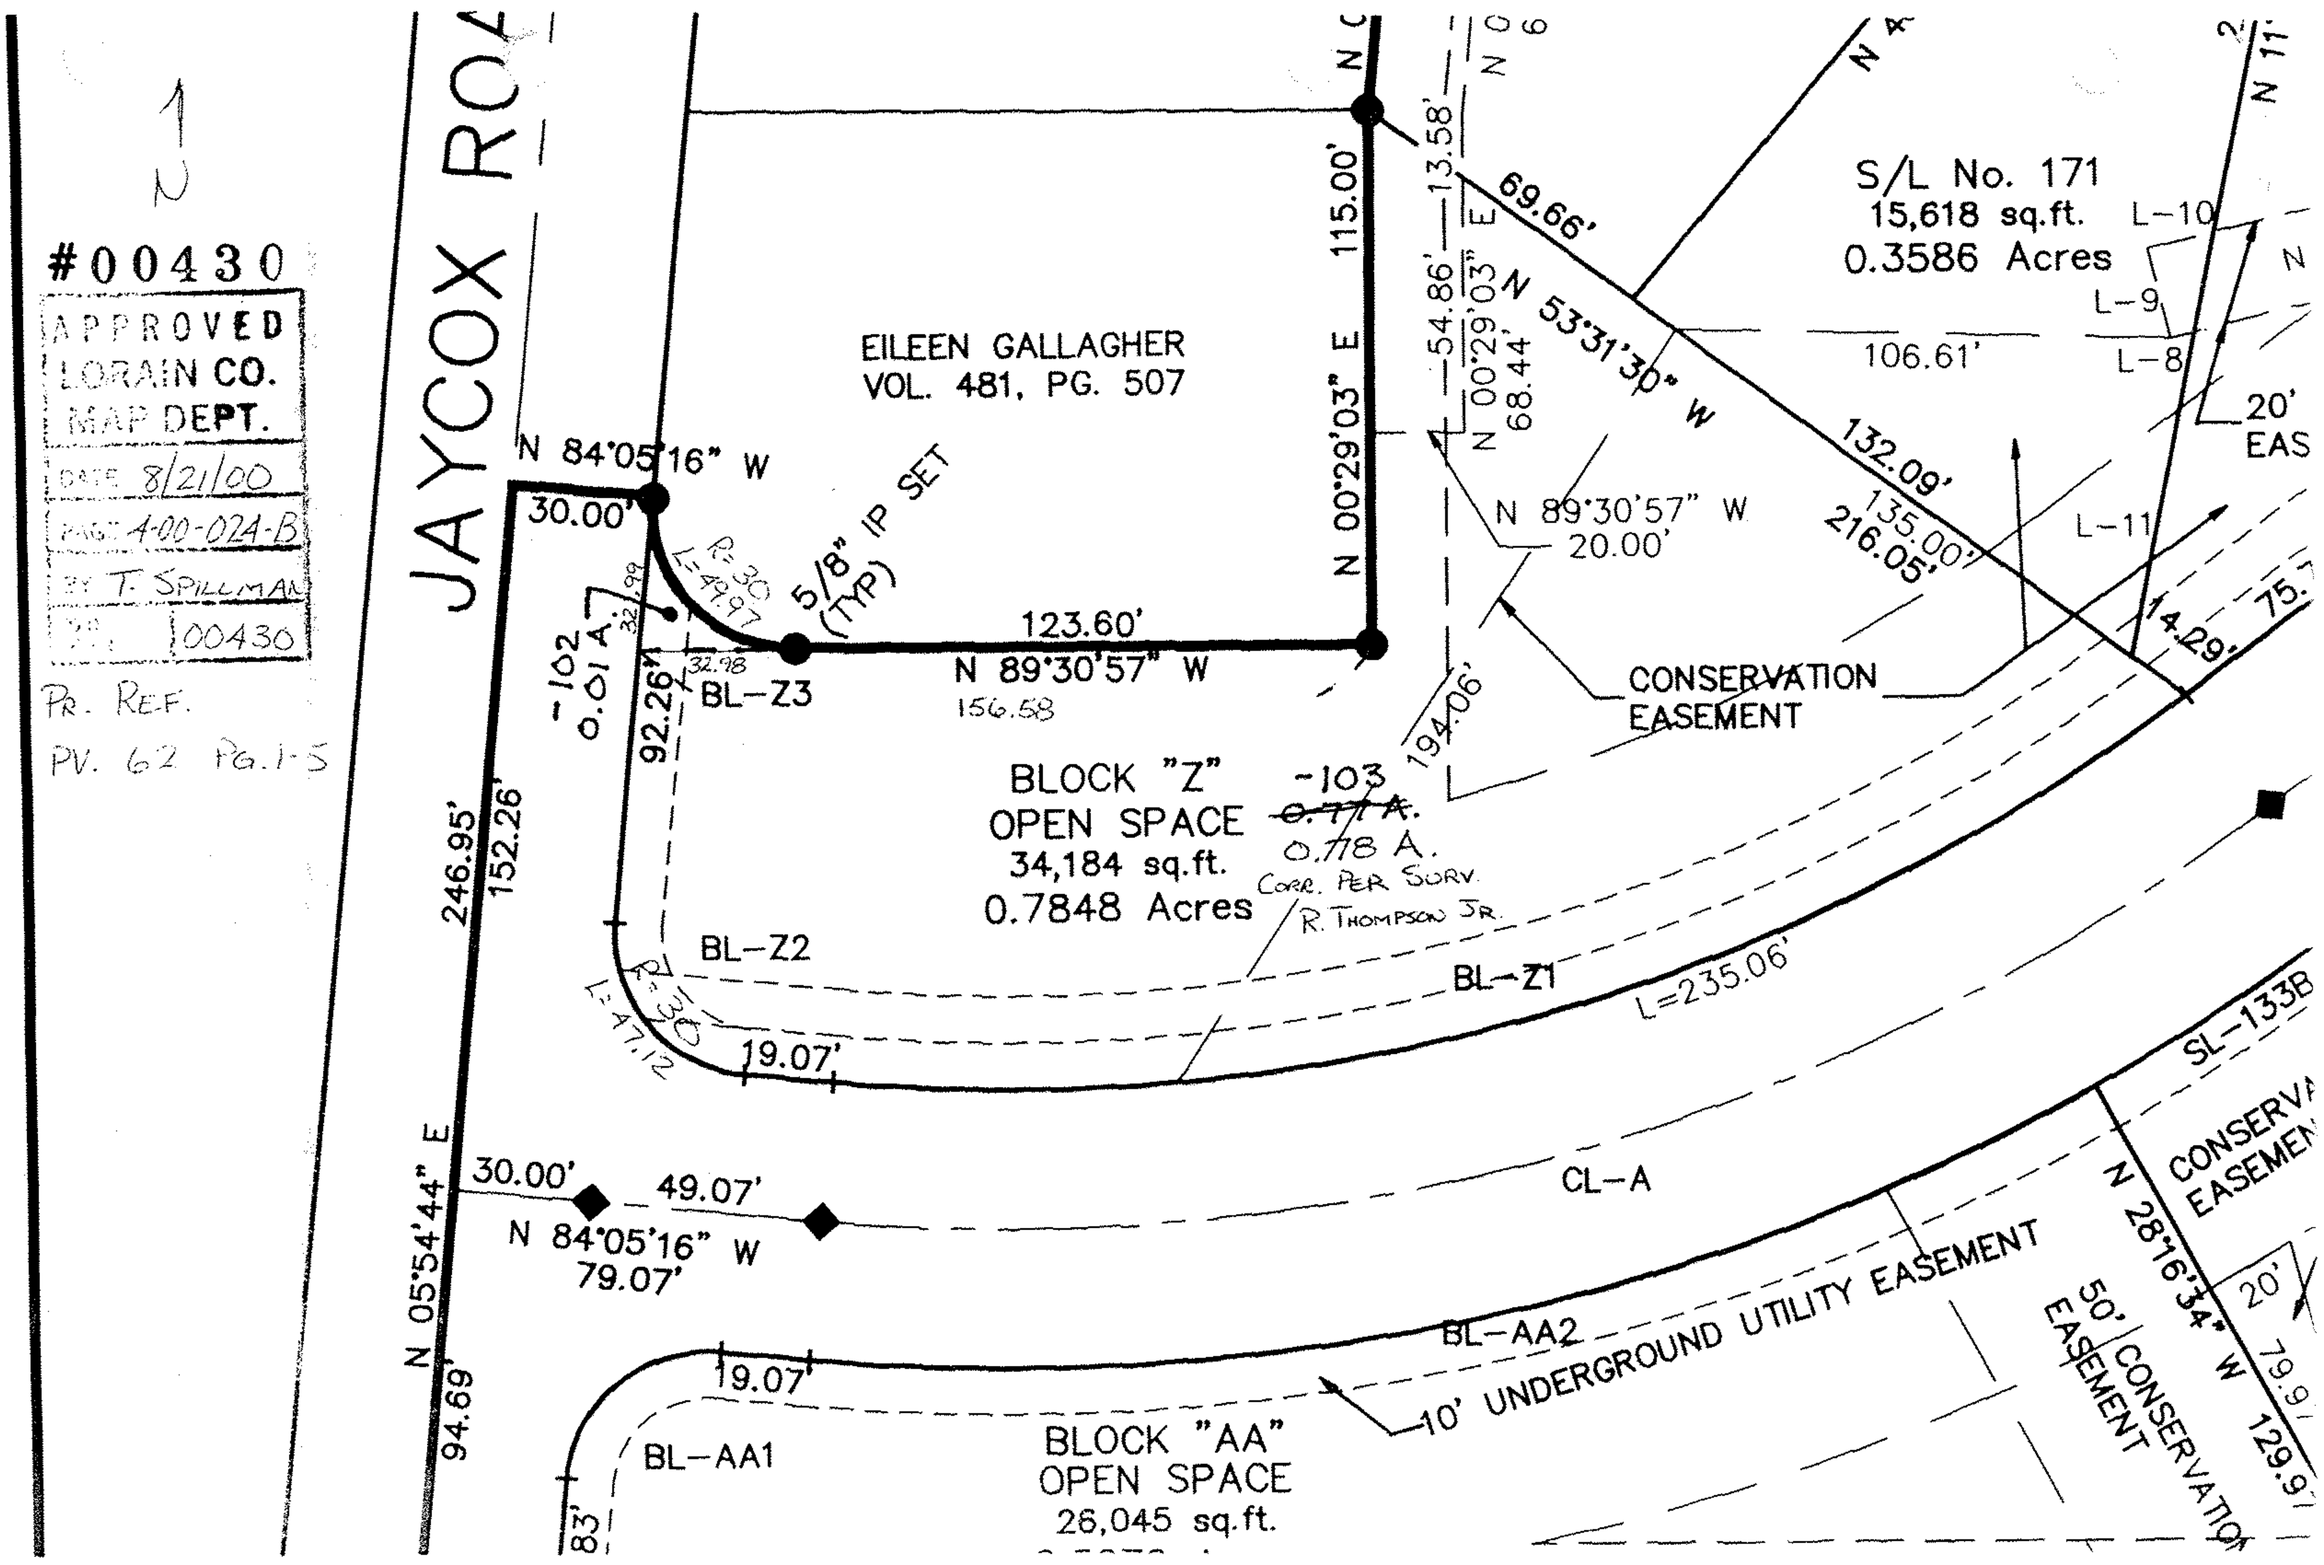

#00430
APPROVED
LORAIN CO.
MAP DEPT.
DATE 8/21/00
PAGE 4-00-024-B
BY T. SPILLMAN
00430
PR. REF.
PV. 62 PG. 1-5
JAYCOX ROA
EILEEN GALLAGHER
VOL. 481, PG. 507
N 84°05'16" W
30.00'
5/8" IP SET (TYP)
R=30
L=49.97
123.60'
N 89°30'57" W
156.58
-102
0.01 A.
92.26'
BL-Z3
N 00°29'03" E
115.00'
13.58'
54.86'
N 00°29'03" E
68.44'
69.66'
N 53°31'30" W
132.09'
135.00'
216.05'
N 89°30'57" W
20.00'
194.06'
CONSERVATION EASEMENT
S/L No. 171
15,618 sq.ft.
0.3586 Acres
L-10
L-9
L-8
L-11
106.61'
20' EAS
14.29'
75.7
BLOCK "Z"
OPEN SPACE
34,184 sq.ft.
0.7848 Acres
-103
~~0.77 A.~~
0.778 A.
CORR. PER SURV.
R. THOMPSON JR.
BL-Z2
BL-Z1
L=235.06'
R=30
L=47.12
19.07'
246.95'
152.26'
N 05°54'44" E
30.00'
49.07'
N 84°05'16" W
79.07'
CL-A
SL-133B
CONSERVA EASEMEN
N 28°16'34" W
129.9
20'
79.9
50' CONSERVATION EASEMENT
BL-AA2
10' UNDERGROUND UTILITY EASEMENT
19.07'
94.69'
BL-AA1
BLOCK "AA"
OPEN SPACE
26,045 sq.ft.
83'