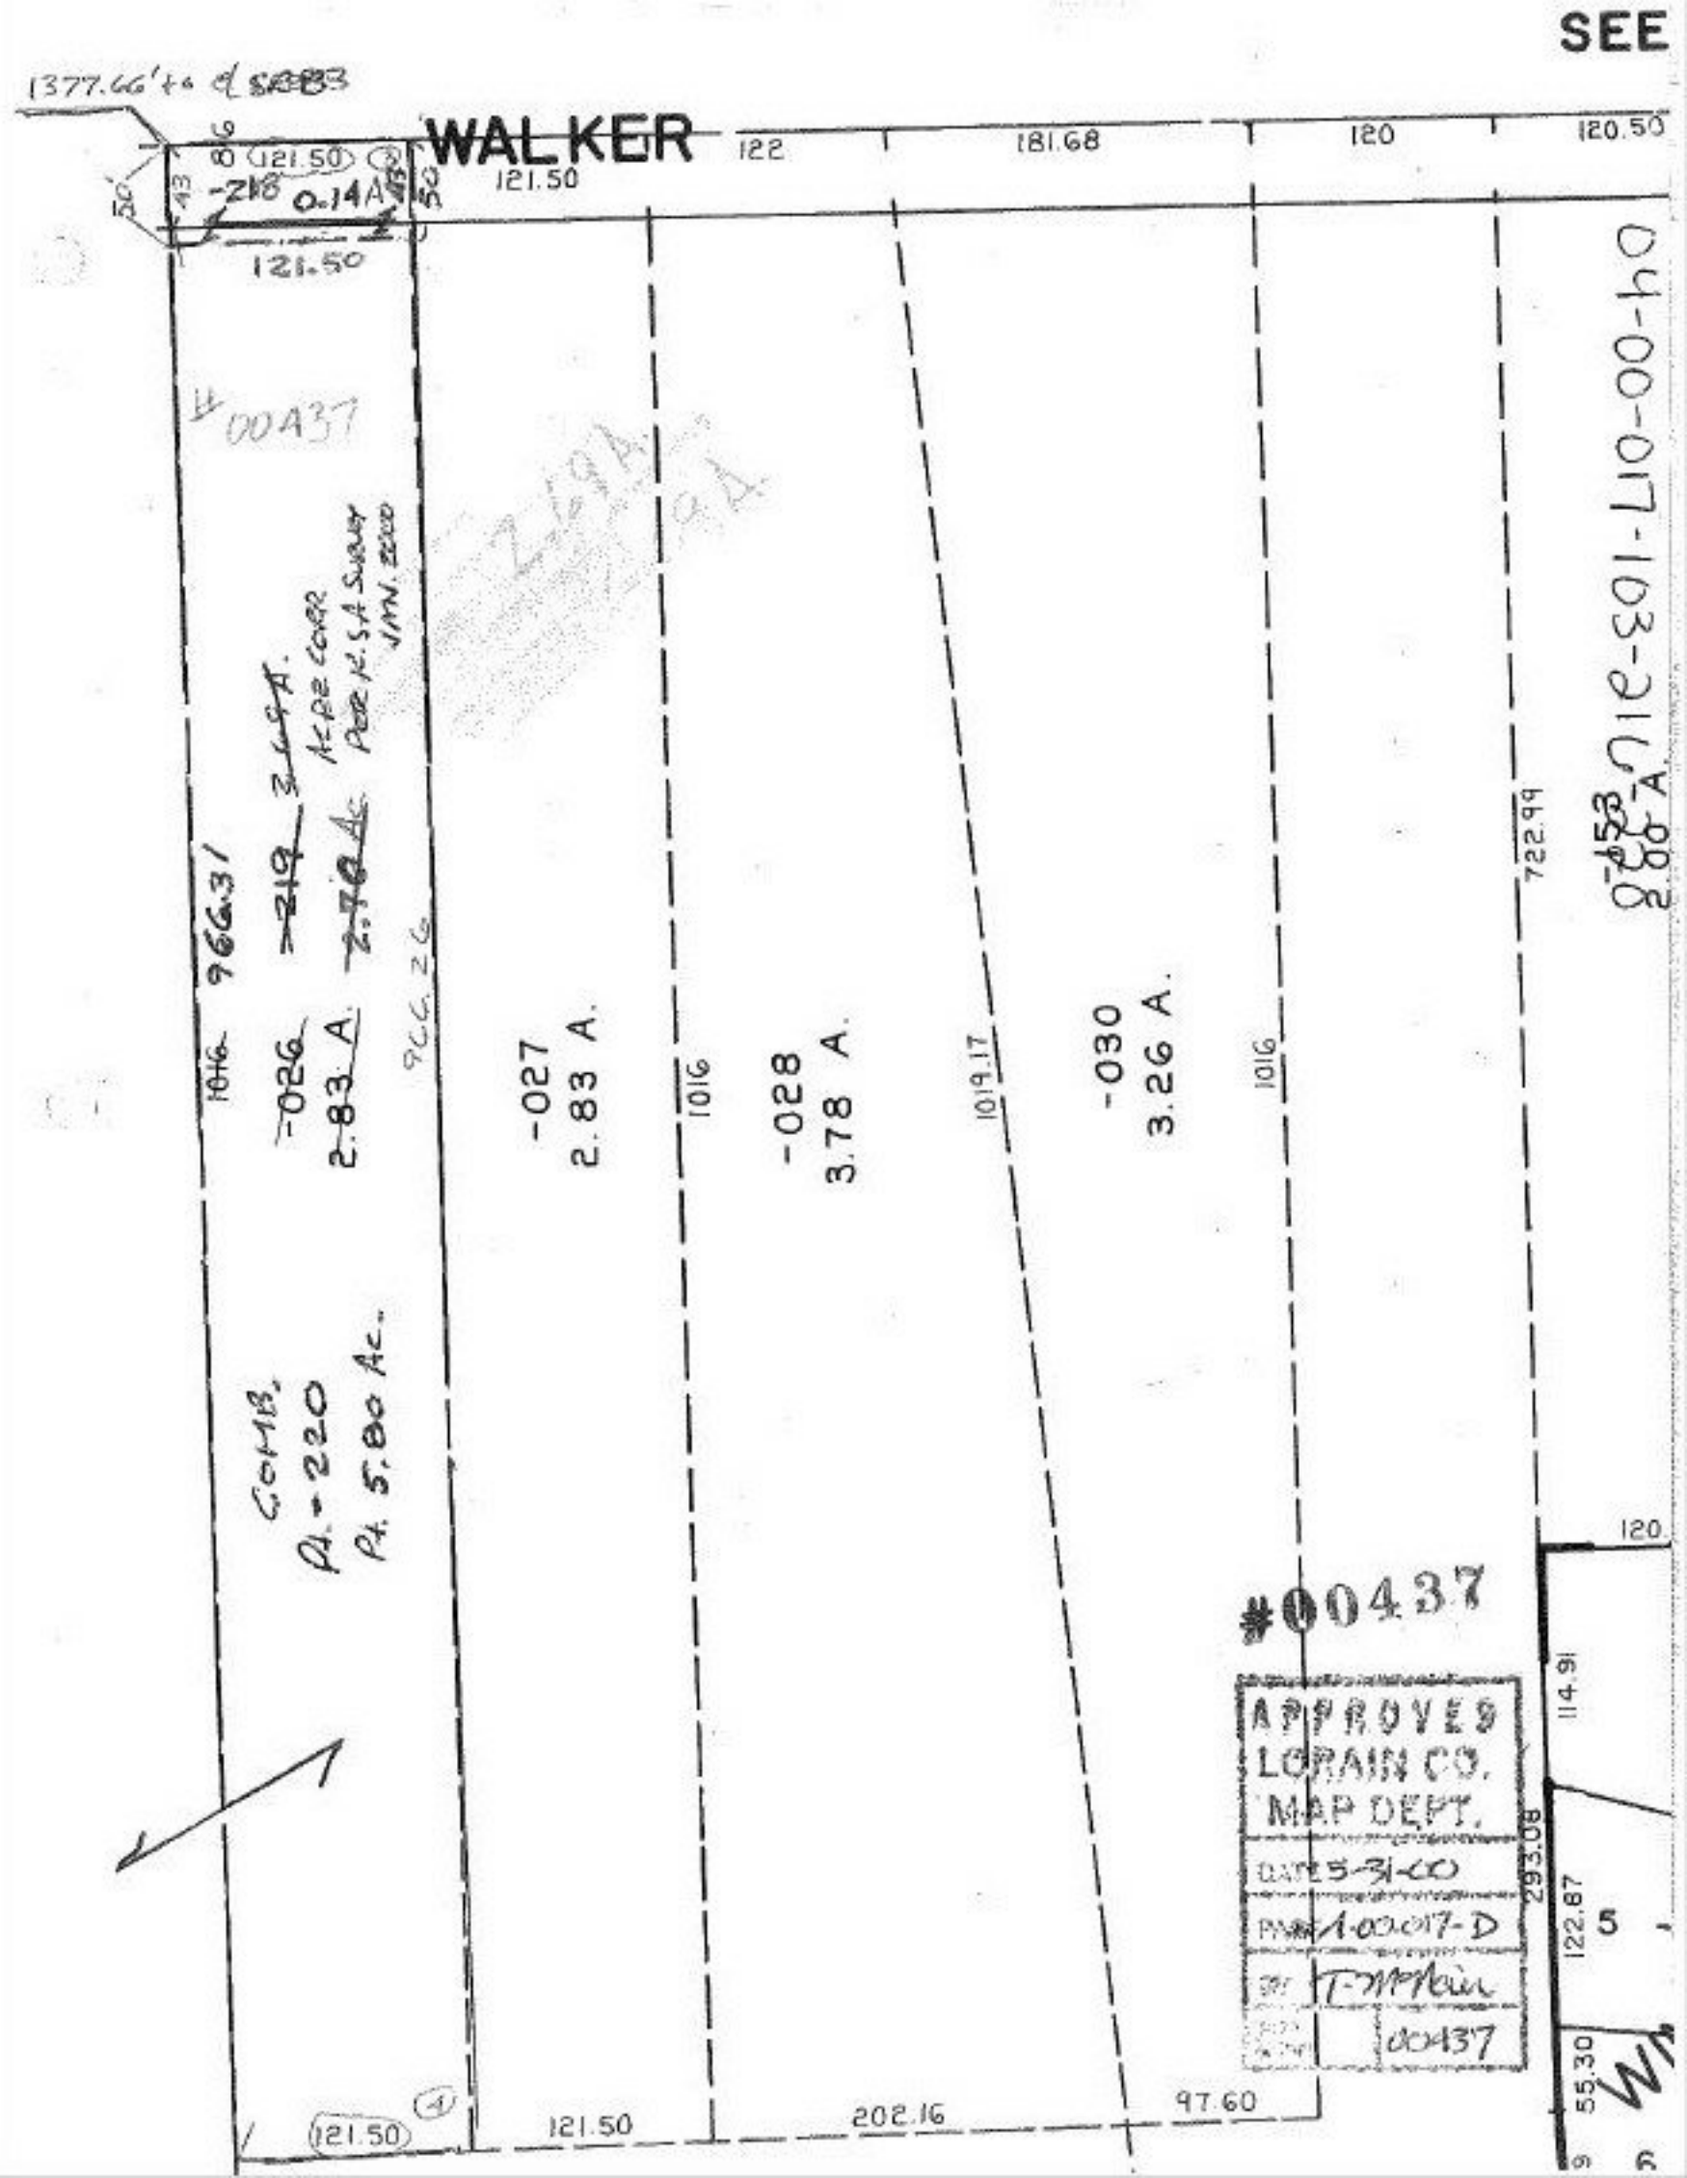
SEE
1377.66' to ℄ of
WALKER
80
(121.50)
-218
0.14A
50
43
121.50
122
181.68
120
120.50
121.50
50
43
00437
-218
3.46A.
-219
3.46A.
Acre Cover
Per Pl. S/A Survey
JAN. 2000
2.76 Ac
966.26
1016
966.31
-026
2.83 A.
COMB.
A. - 220
A. 5.80 Ac.
-027
2.83 A.
1016
-028
3.78 A.
1019.17
-030
3.26 A.
1016
722.99
8-453
2.88 A.
120
#00437
APPROVED
LORAIN CO.
MAP DEPT.
DATE 5-31-00
PWK 1-00-017-D
BY TEMPLIN
00437
114.91
293.08
122.87
5
55.30
121.50
121.50
202.16
97.60