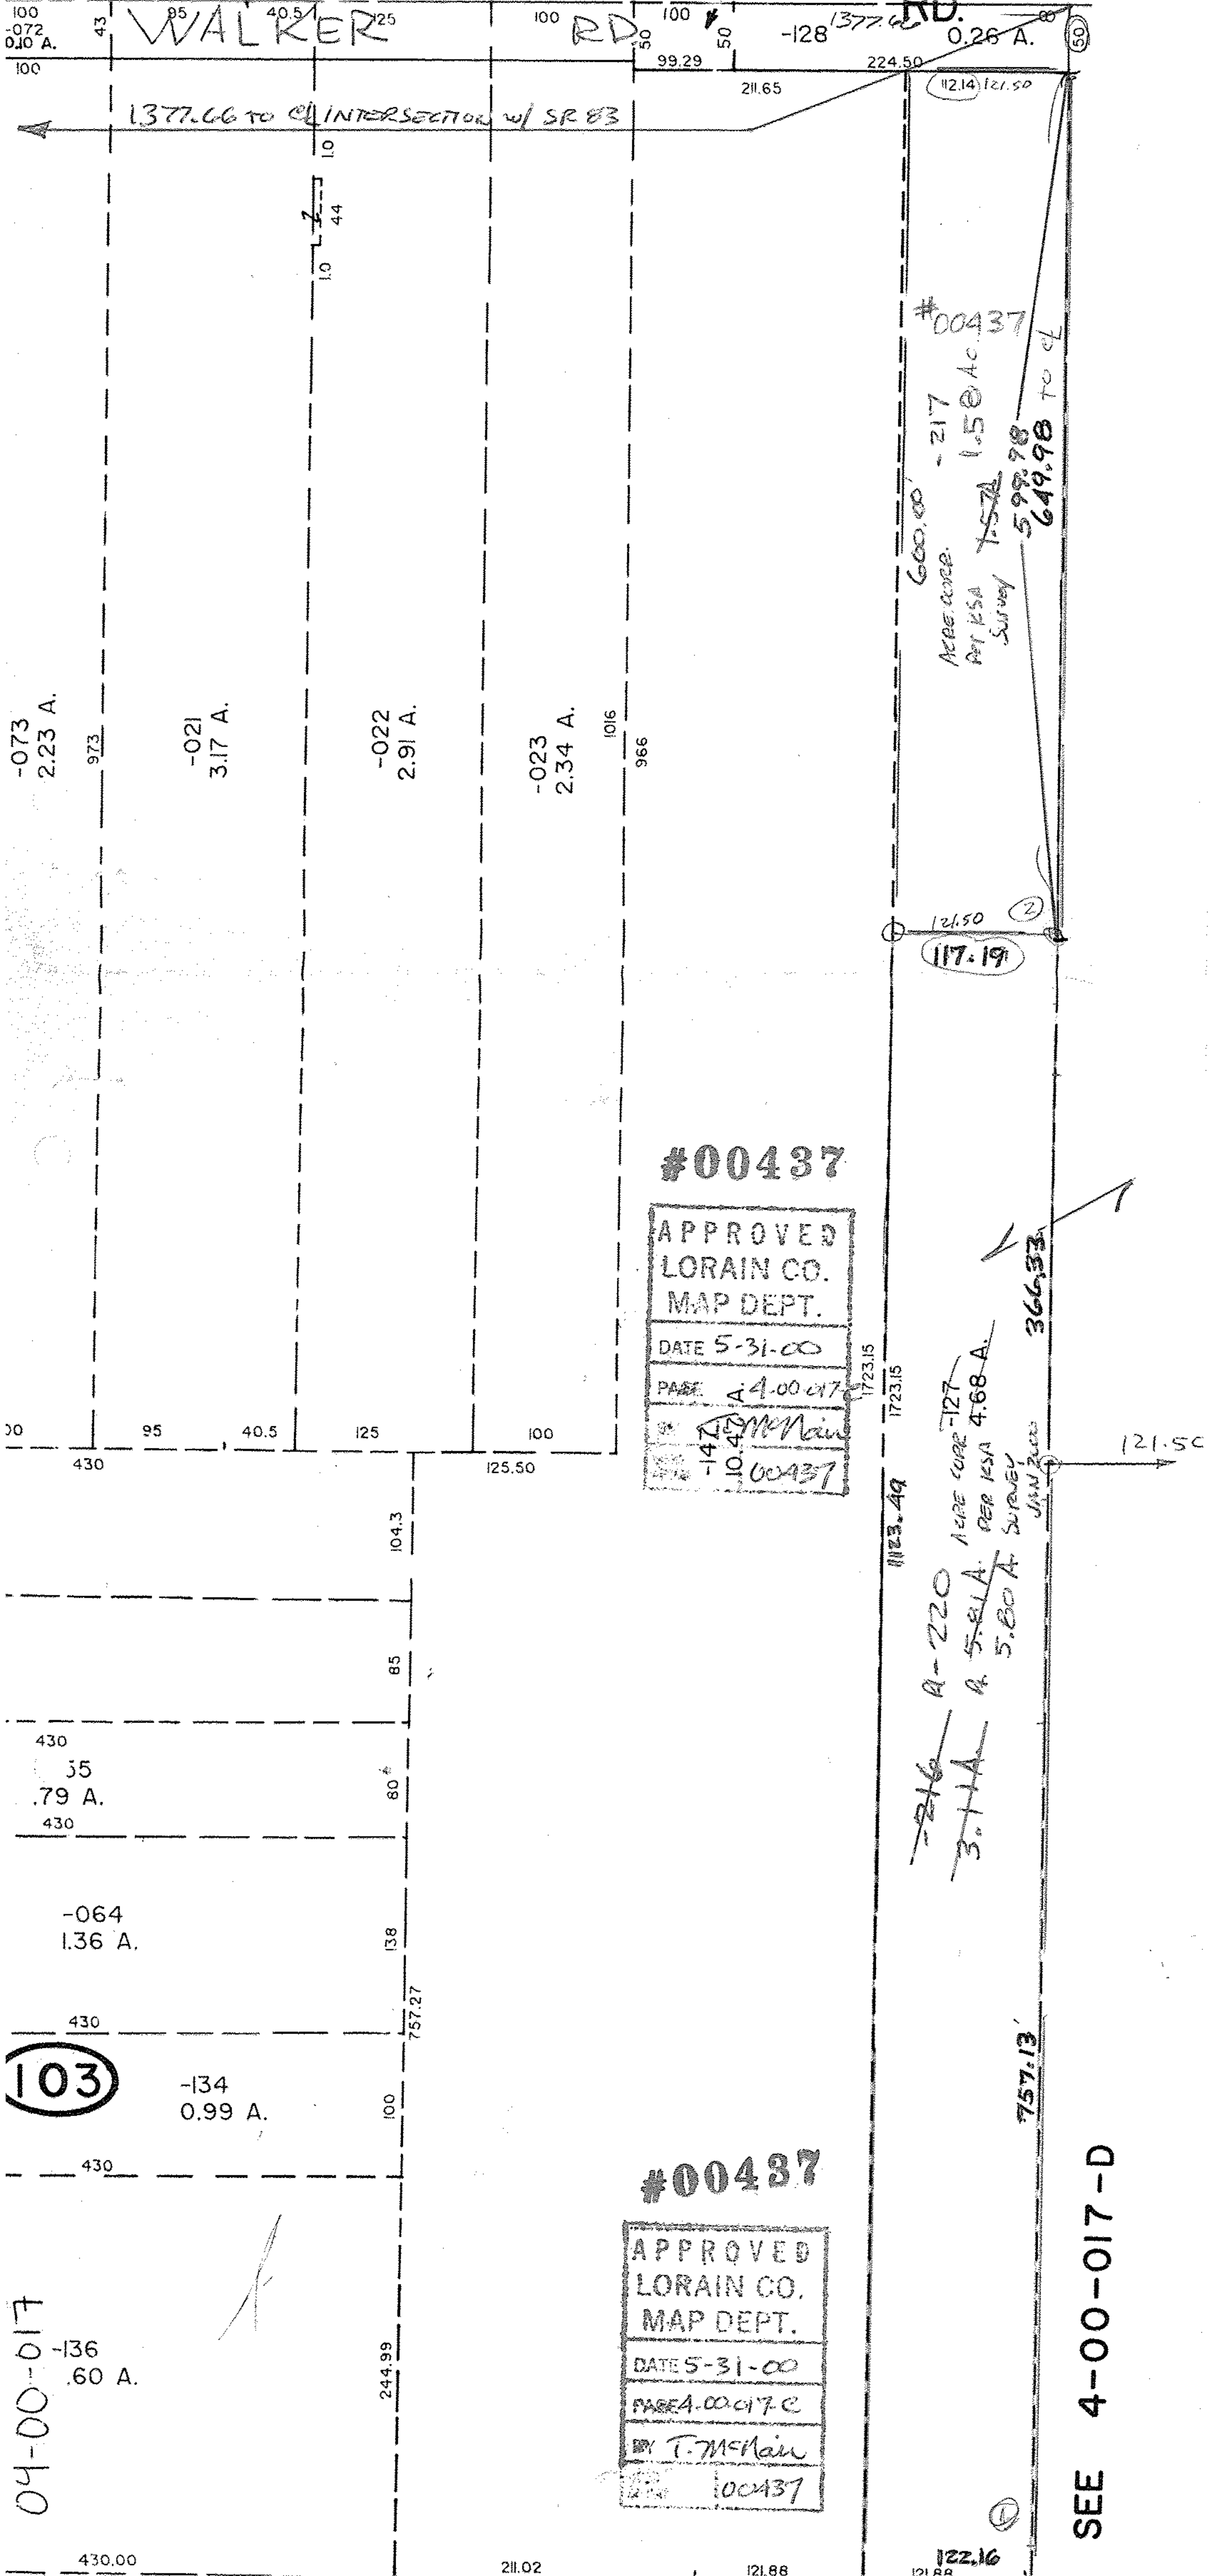
WALKER RD.
1377.66 TO ℄ INTERSECTION W/ SR 83
-128
0.26 A.
#00437
-217
1.58 Ac.
649.98 TO ℄
-073
2.23 A.
-021
3.17 A.
-022
2.91 A.
-023
2.34 A.
APPROVED
LORAIN CO.
MAP DEPT.
DATE 5-31-00
PAGE 4.00 017
BY T. McMain
#00437
-064
1.36 A.
103
-134
0.99 A.
-136
.60 A.
04-00-017
-127
4.68 A.
-220
5.81 A.
5.80 Ac.
-216
3.7 Ac.
SEE 4-00-017-D