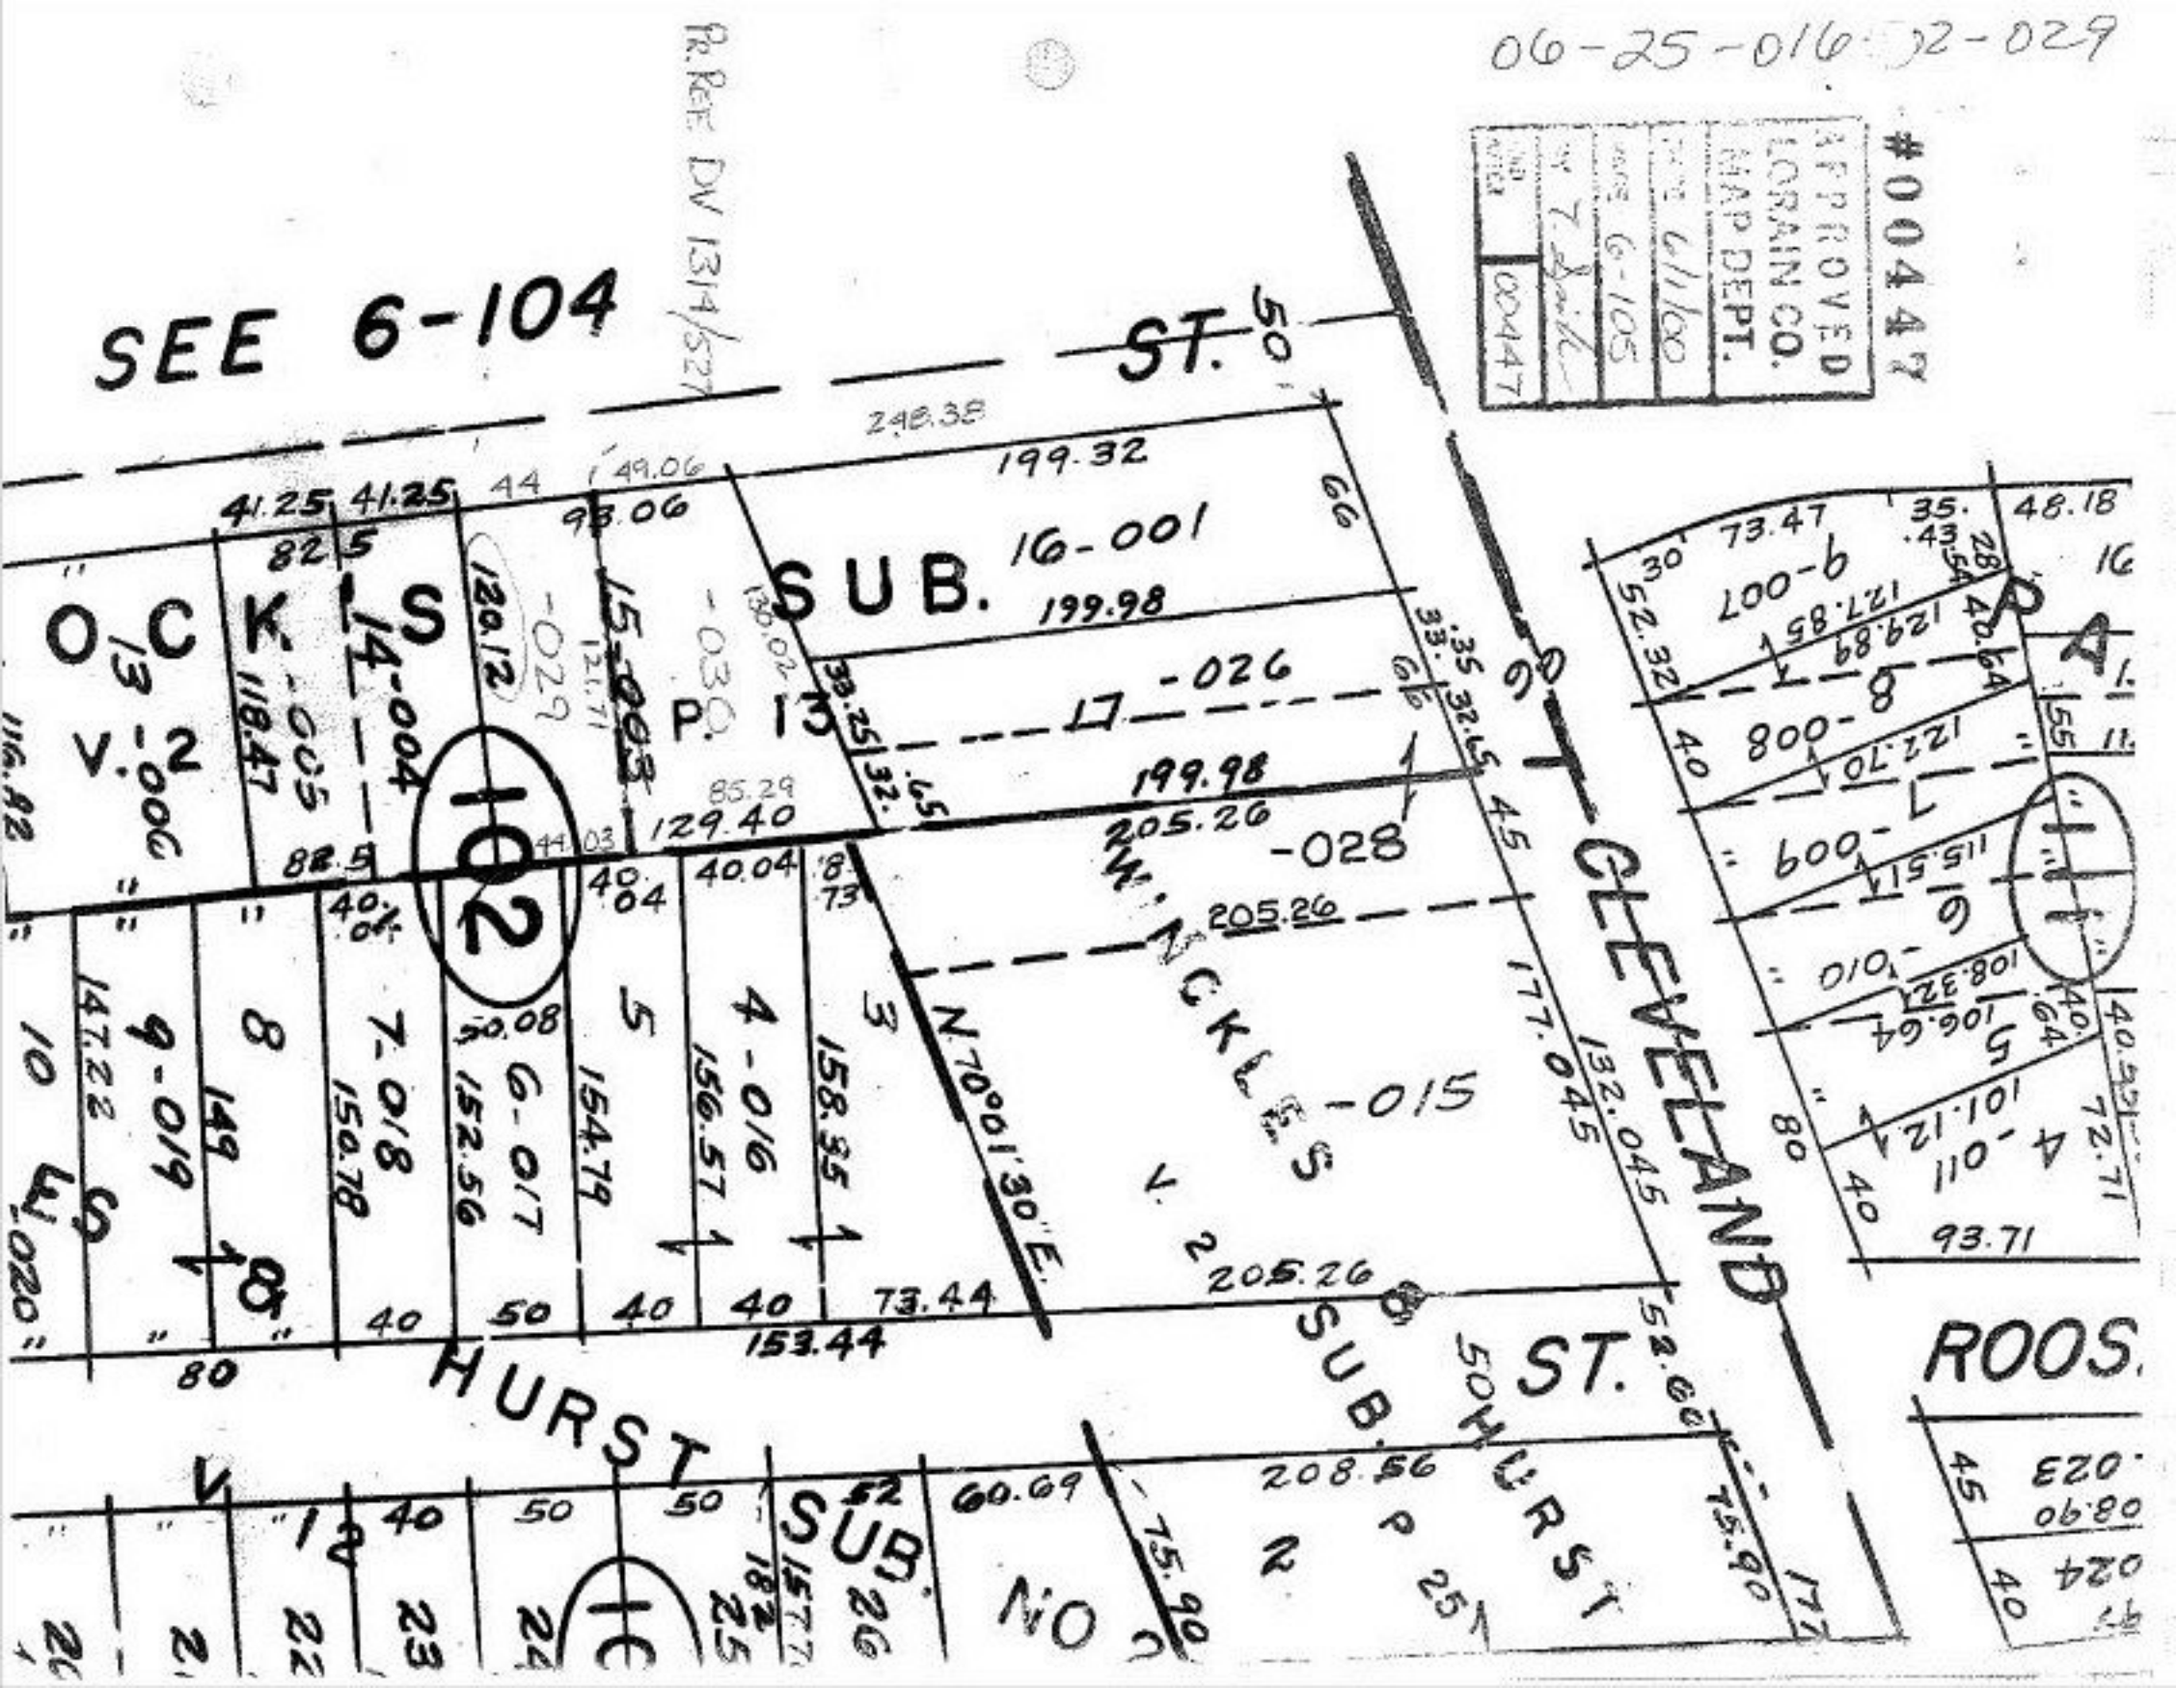
06-25-016 02-029
#00447
APPROVED
LORAIN CO.
MAP DEPT.
SEE 6-104
ST.
PR. REF. DV 1314/527
SUB. 16-001
199.98
-026
-028
-015
-029
-030
-005
-004
-003
-006
-007
-008
-009
-010
-011
-016
-017
-018
-019
-020
CLEVELAND
HURST
SUB.
ROOS
P. 13
V. 2
205.26
199.32
248.38
153.44
208.56
177.045
132.045
N. 70°01'30" E.