


05-00-025-101-132

#00470
 APPROVED
 LORAIN CO.
 MAP DEPT.
 6/13/00
 PAGES 00-016 RE 025-101-132
 BY *[Signature]*
 00470

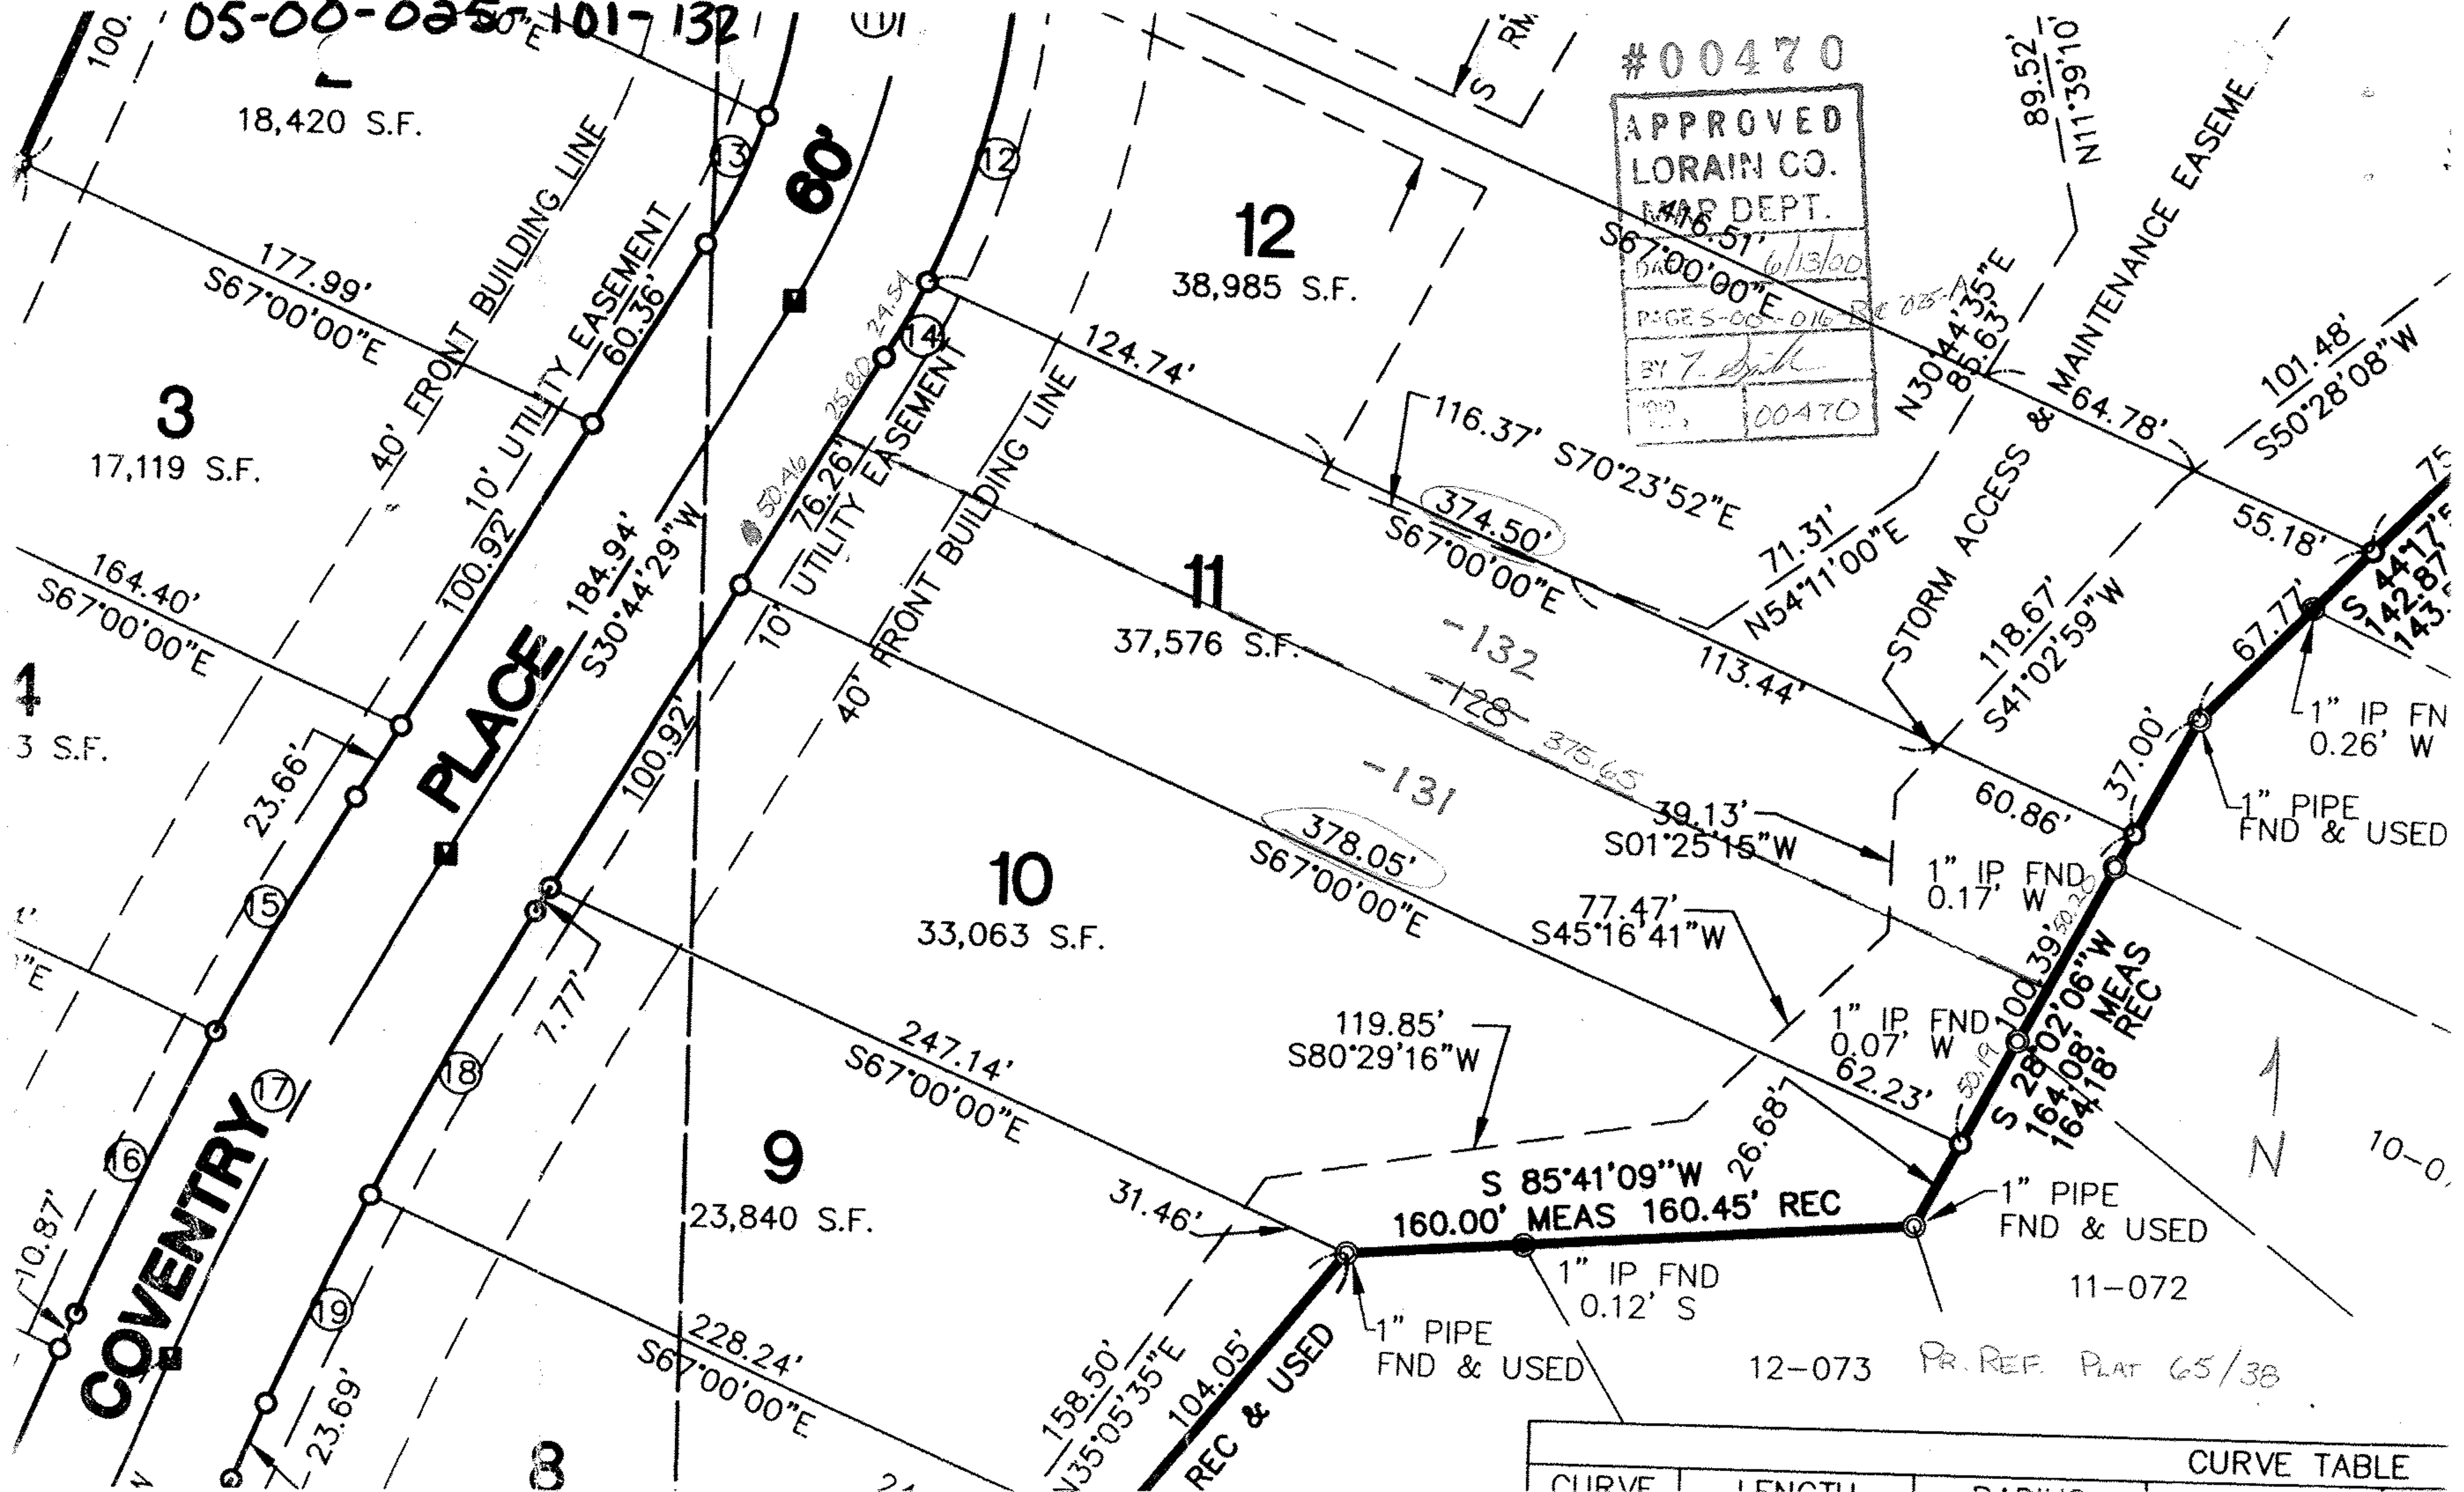

CURVE TABLE	
CURVE	LENGTH