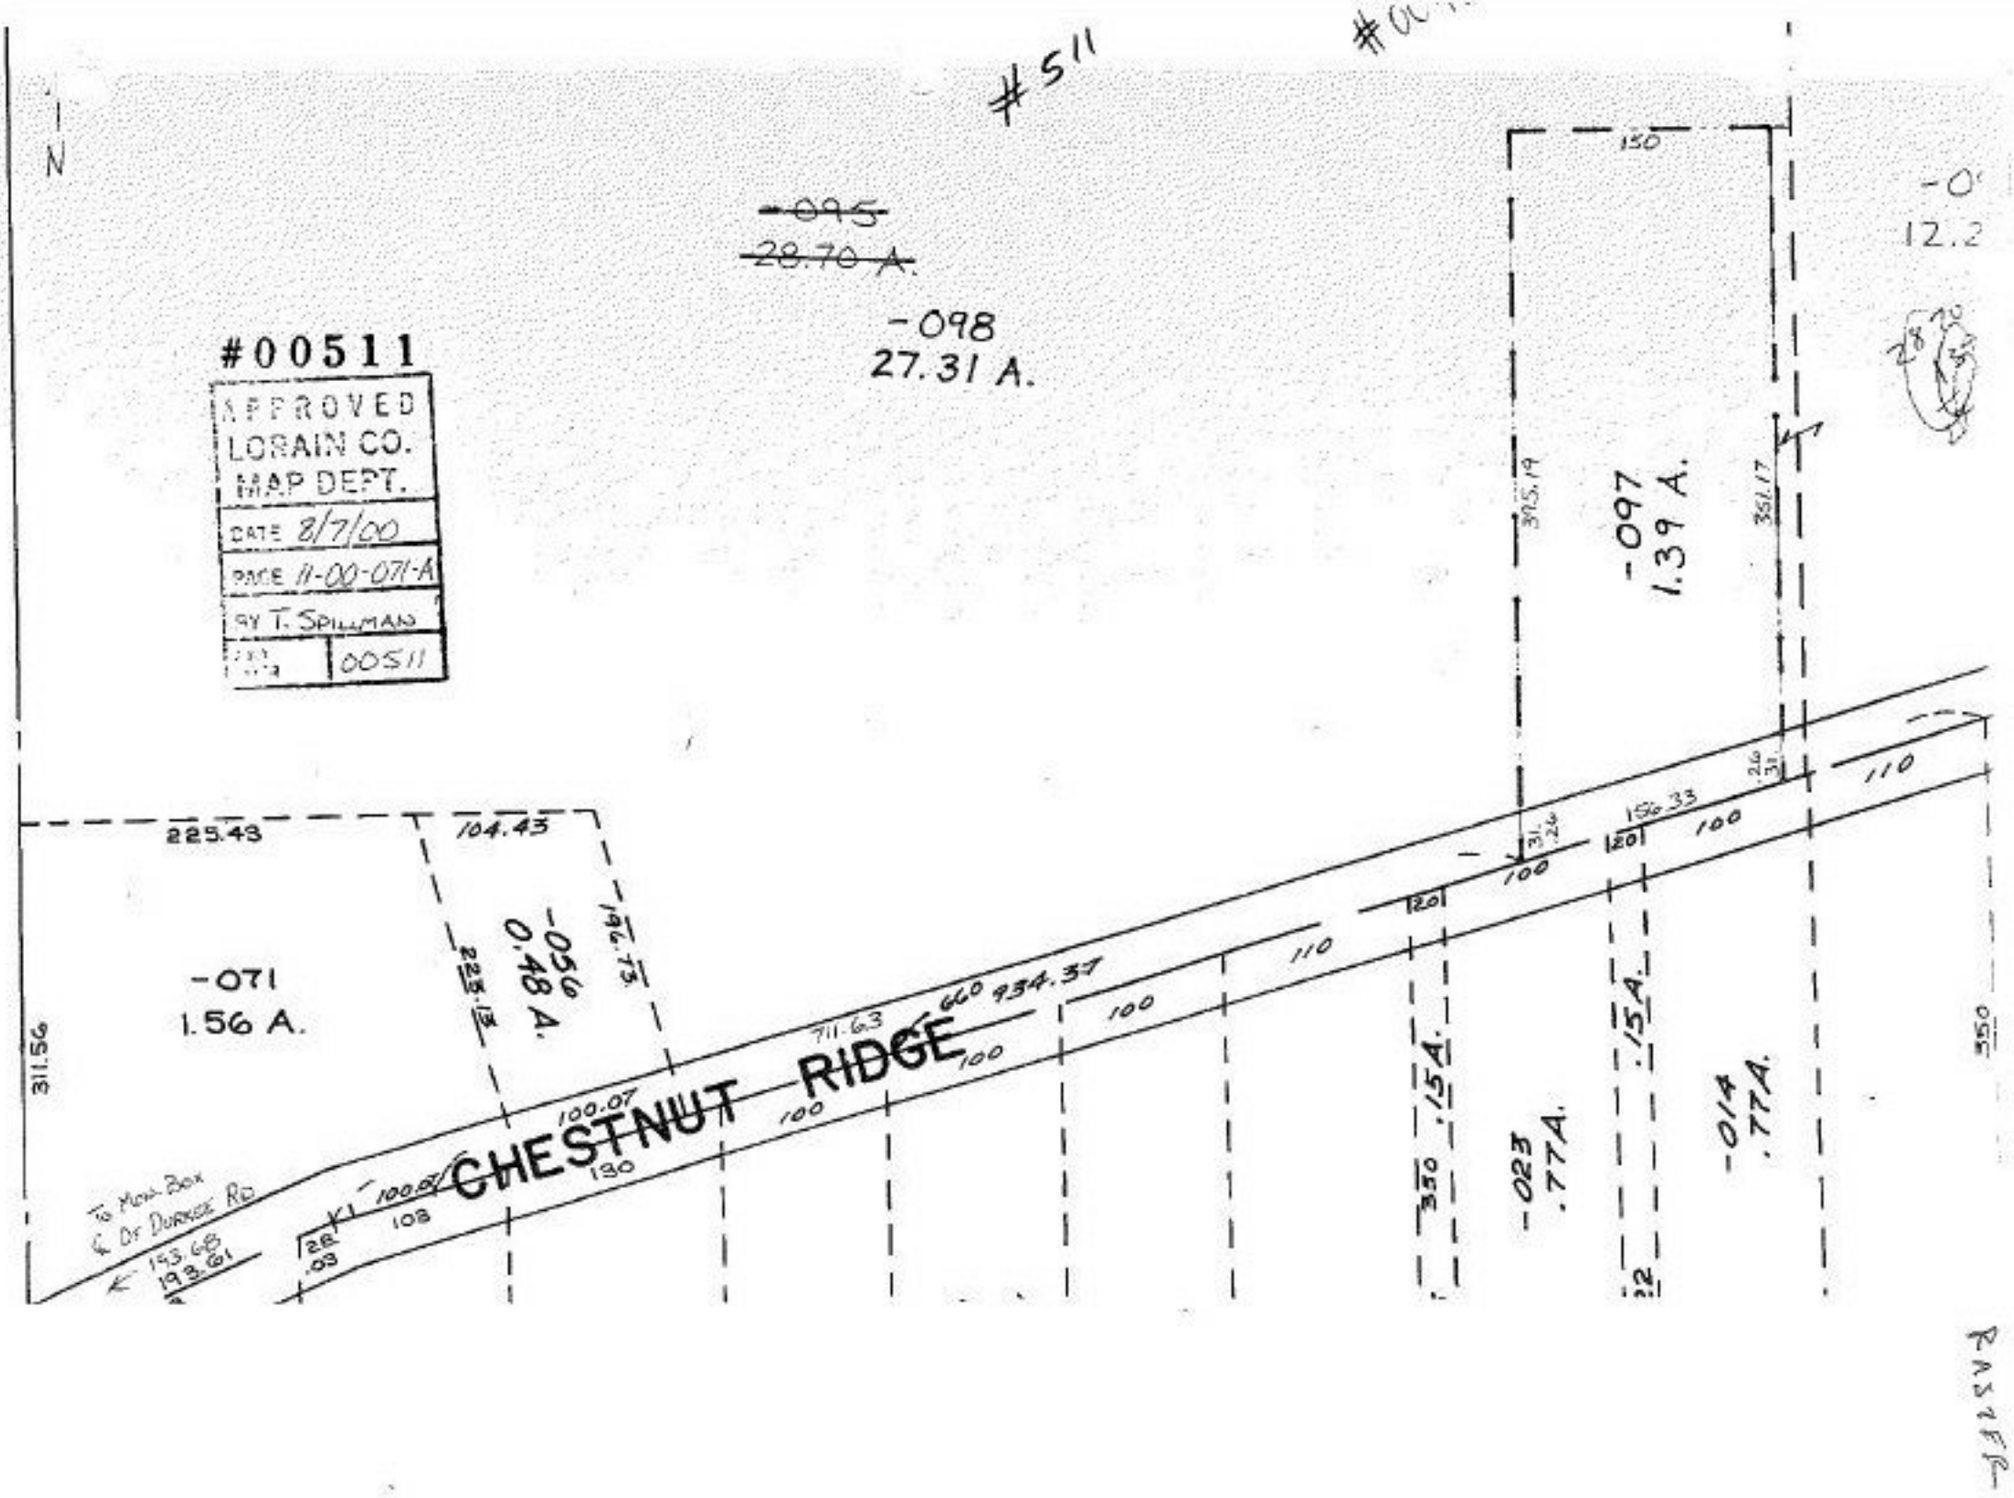
#511
N
-095
28.70 A.
-098
27.31 A.
#00511
APPROVED
LORAIN CO.
MAP DEPT.
DATE 8/7/00
PAGE 11-00-071-A
BY T. SPILLMAN
00511
-097
1.39 A.
-071
1.56 A.
-056
0.48 A.
-023
.774A.
-014
.774A.
CHESTNUT RIDGE
225.43
104.43
311.56
315.19
351.17
711.63
660
934.37
150
100
120
110
350
154
To Main Box
& Dr Durrell Rd
153.68
198.61
100.07
108
130
28.09
12.2