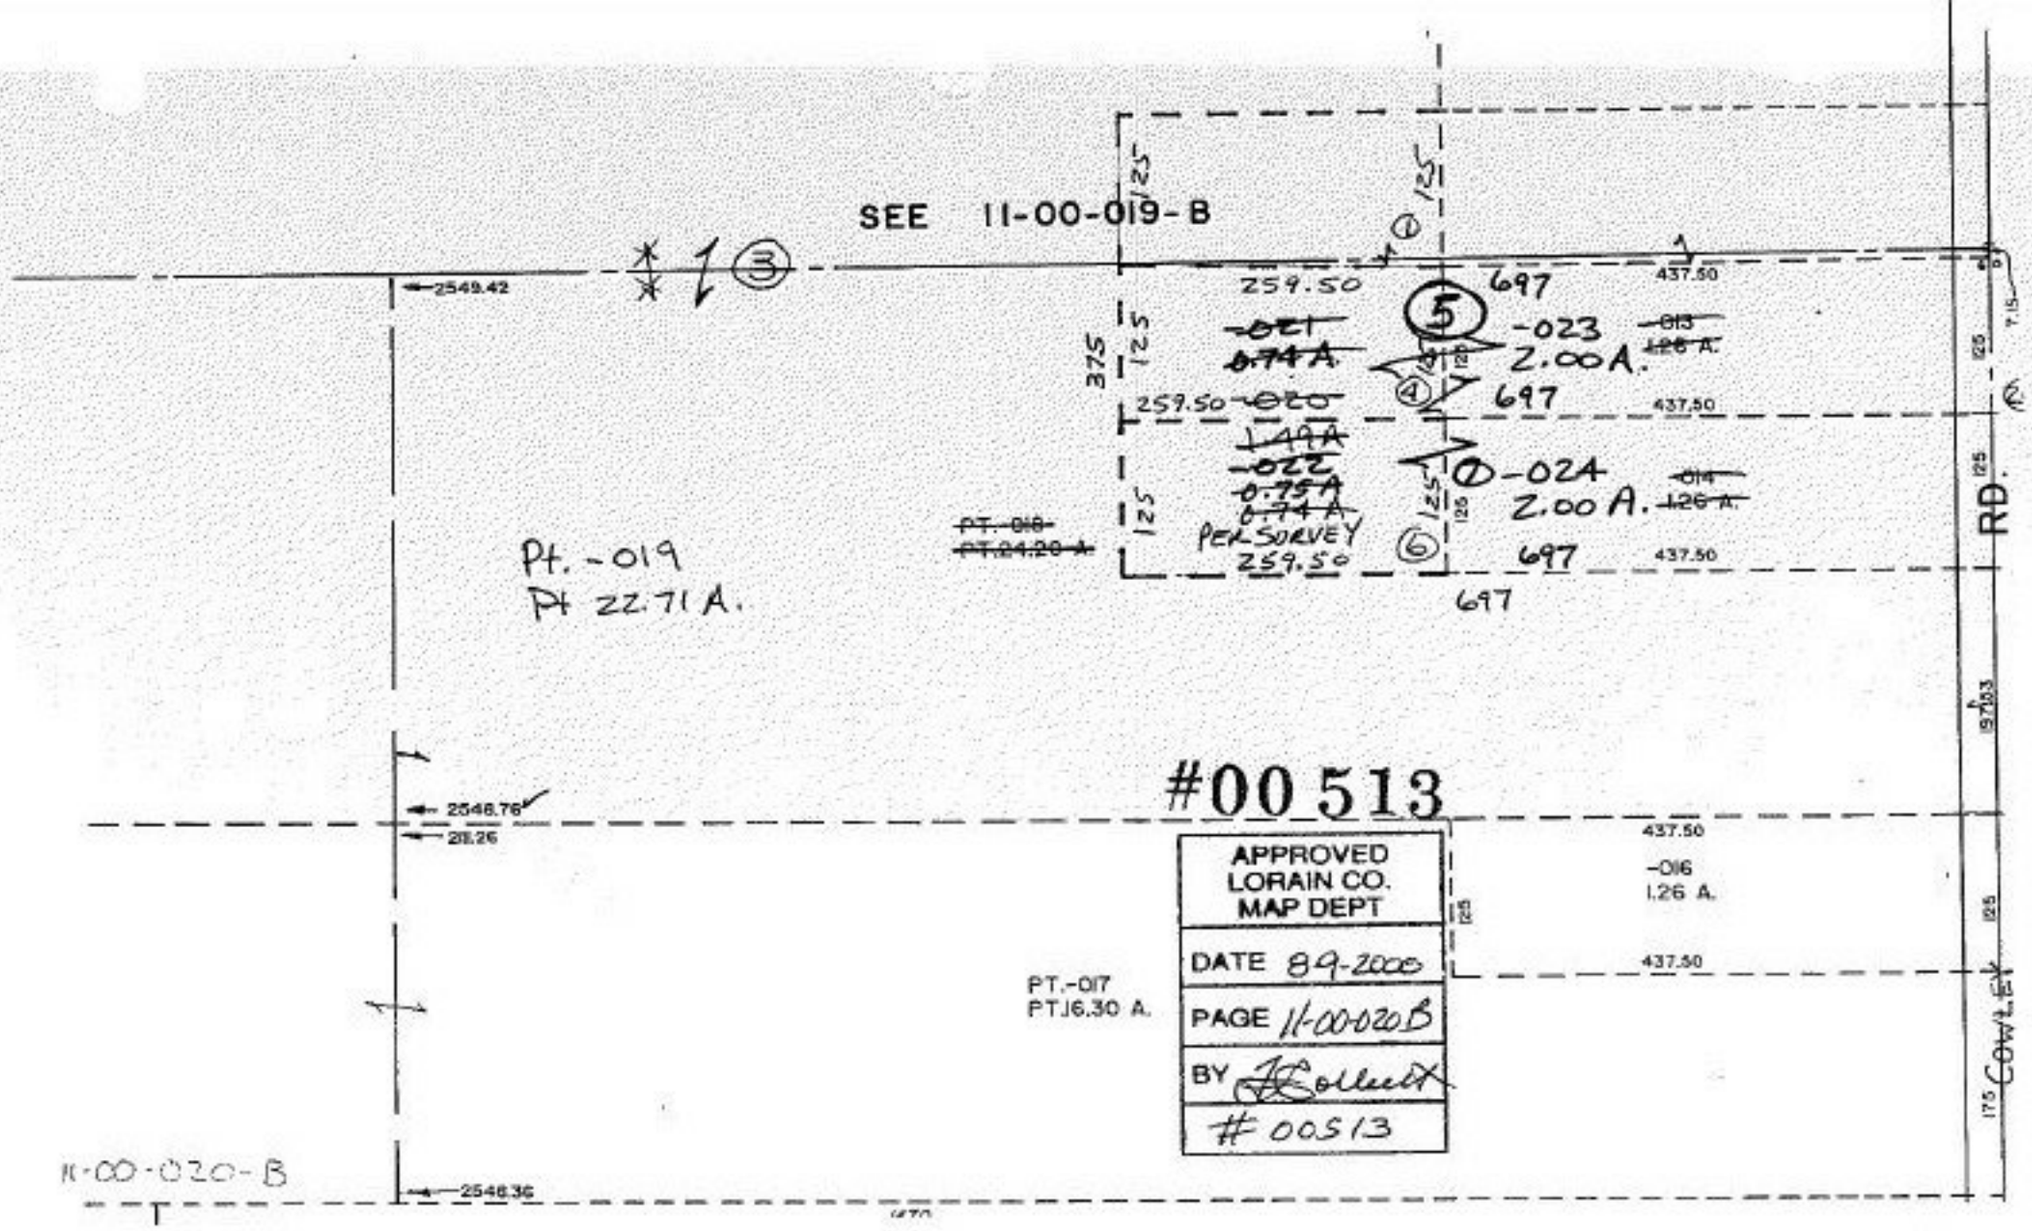
SEE 11-00-019-B
2549.42
259.50
697
437.50
375
125
-021
0.74A.
-023
2.00A.
-013
1.26 A.
-020
1.44A
-022
0.75A
0.74A.
PER SURVEY
259.50
-024
2.00A.
-014
1.26 A.
PT. -018
PT. 24.29 A.
Pt. -019
Pt 22.71 A.
RD.
#00513
2546.76
28.26
APPROVED
LORAIN CO.
MAP DEPT
DATE 8-9-2000
PAGE 11-00-020B
BY
#00513
-016
1.26 A.
PT.-017
PT.16.30 A.
11-00-020-B
2546.36

RASTER