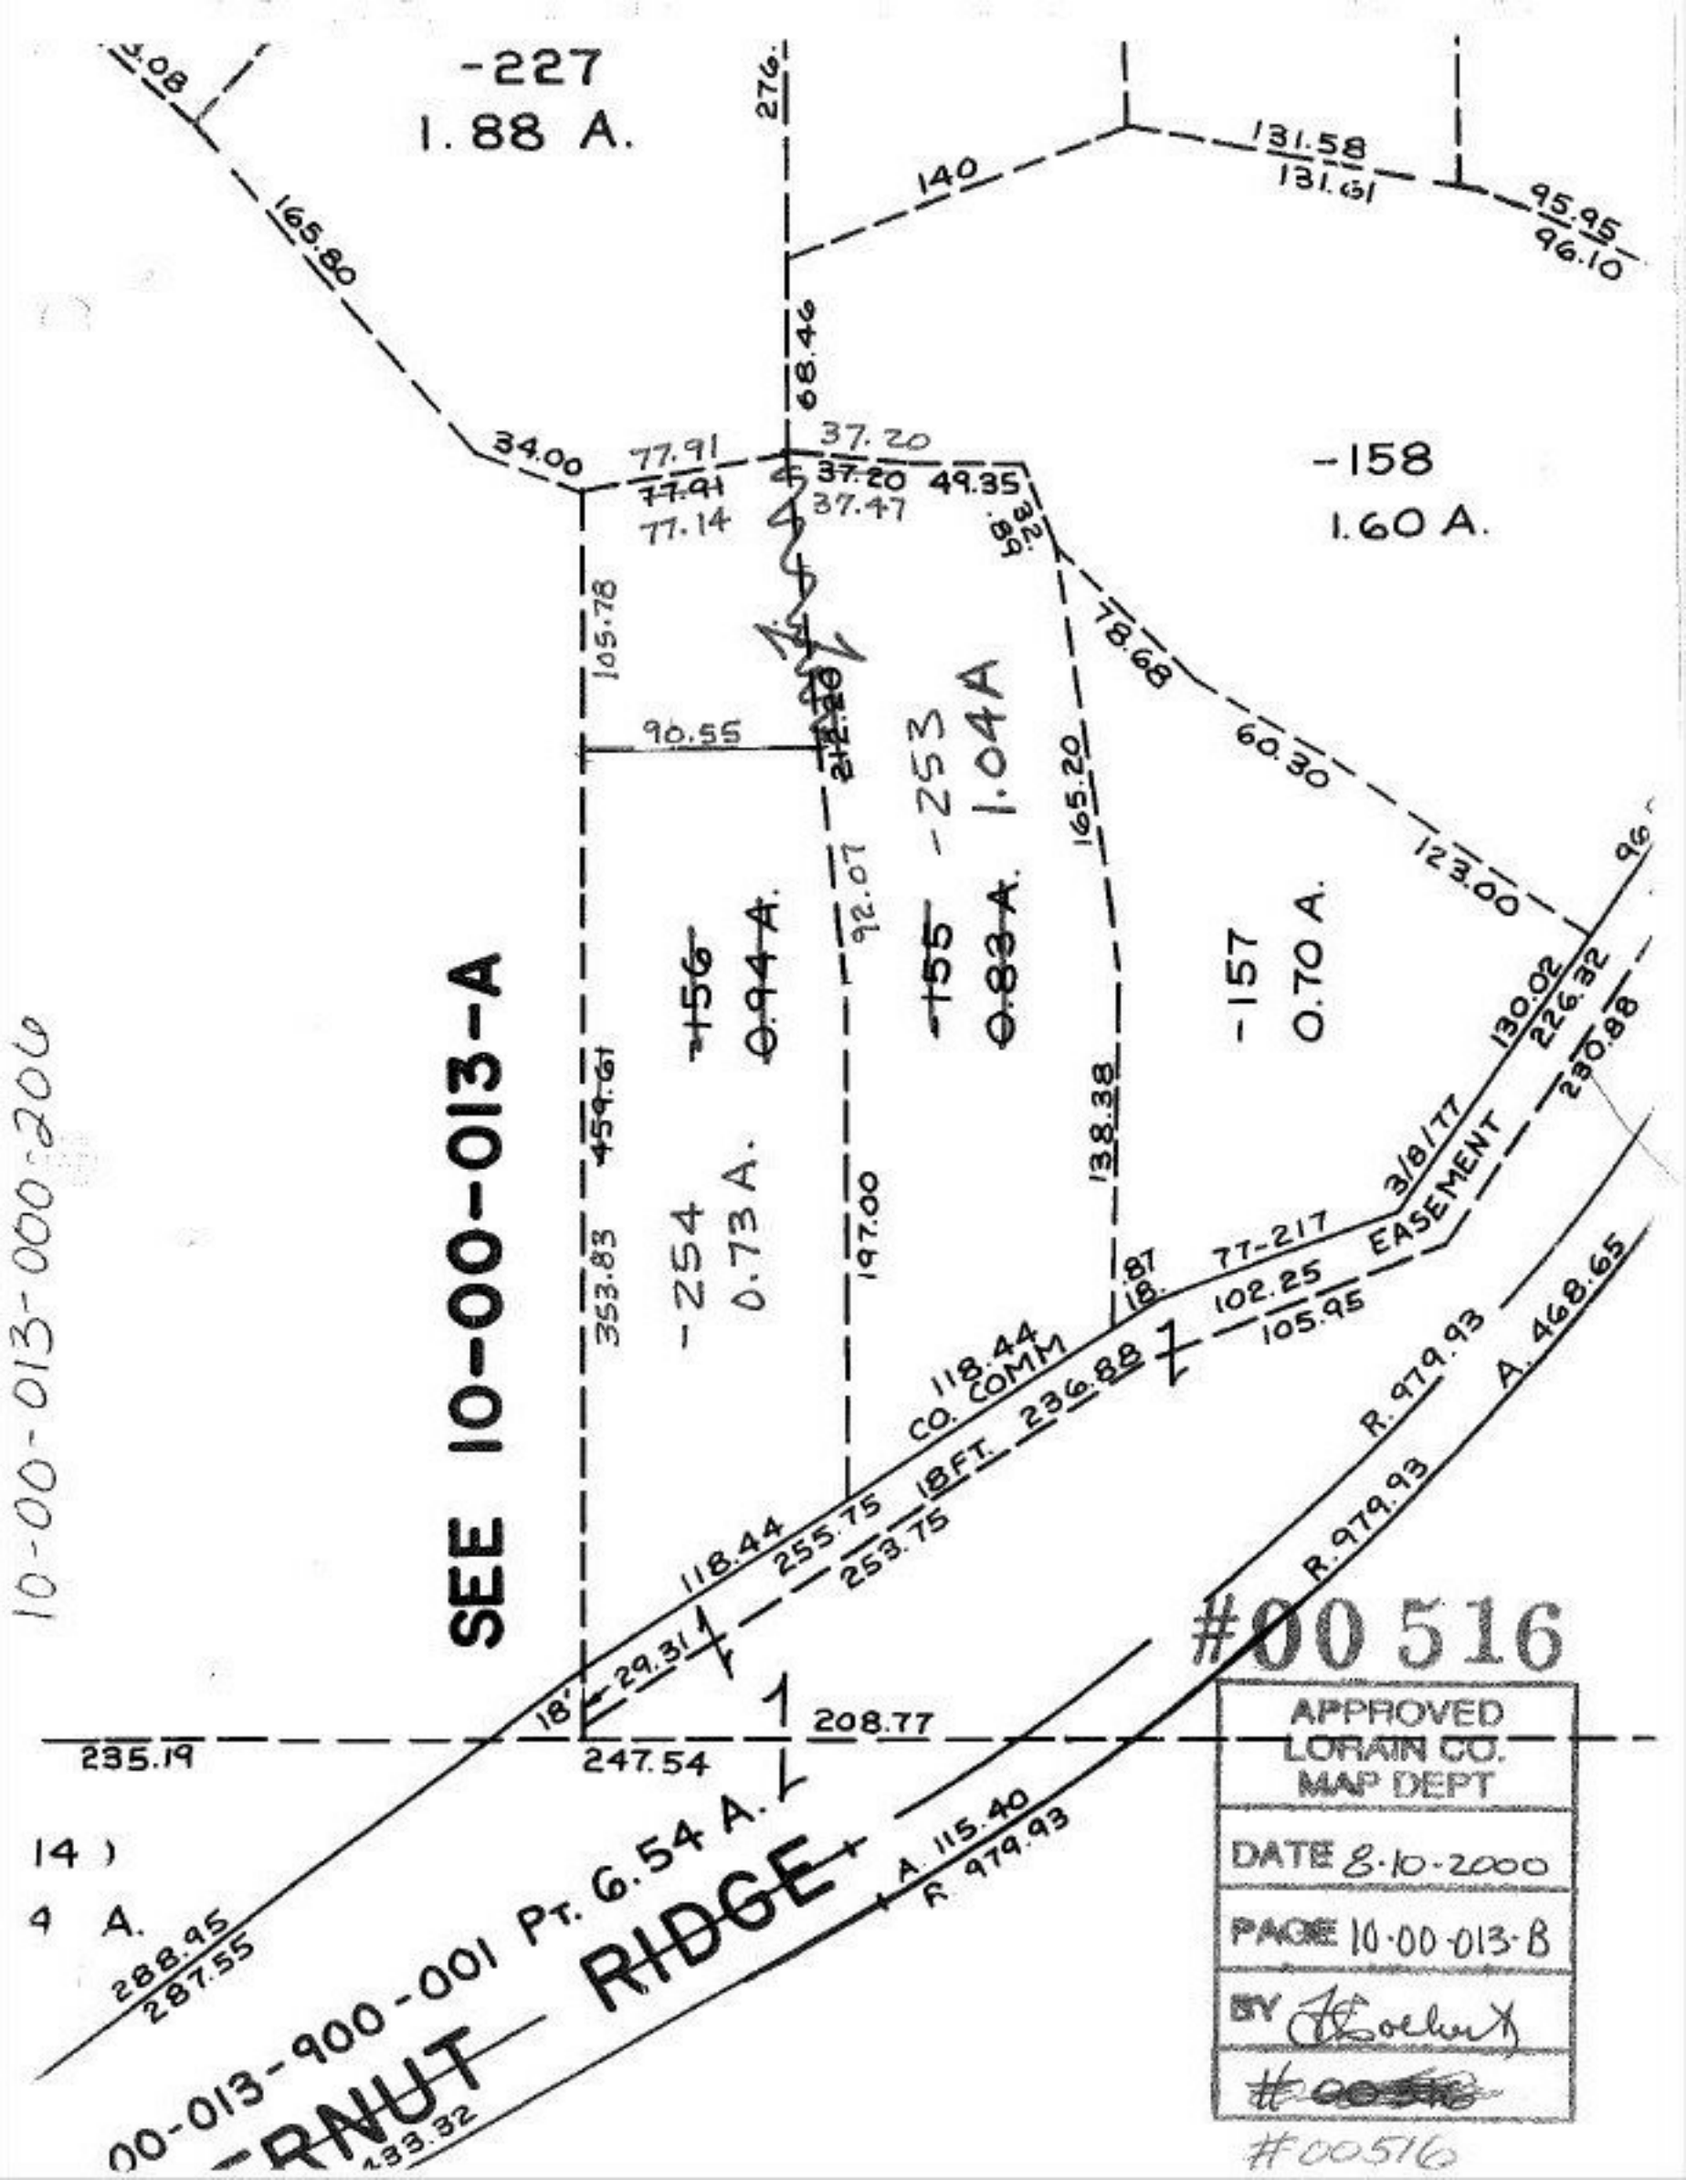

-227
1.88 A.
-158
1.60 A.
-157
0.70 A.
-253
1.04 A
-156
0.94 A.
-155
0.83 A.
-254
0.73 A.
SEE 10-00-013-A
10-00-013-000-206
00-013-900-001 Pt. 6.54 A.
RNUT RIDGE
EASEMENT
CO. COMM
18 FT.
R. 979.93
A. 468.65
A. 115.40
R. 979.93
#00516
APPROVED
LORAIN CO.
MAP DEPT
DATE 8-10-2000
PAGE 10-00-013-B
BY
#00516