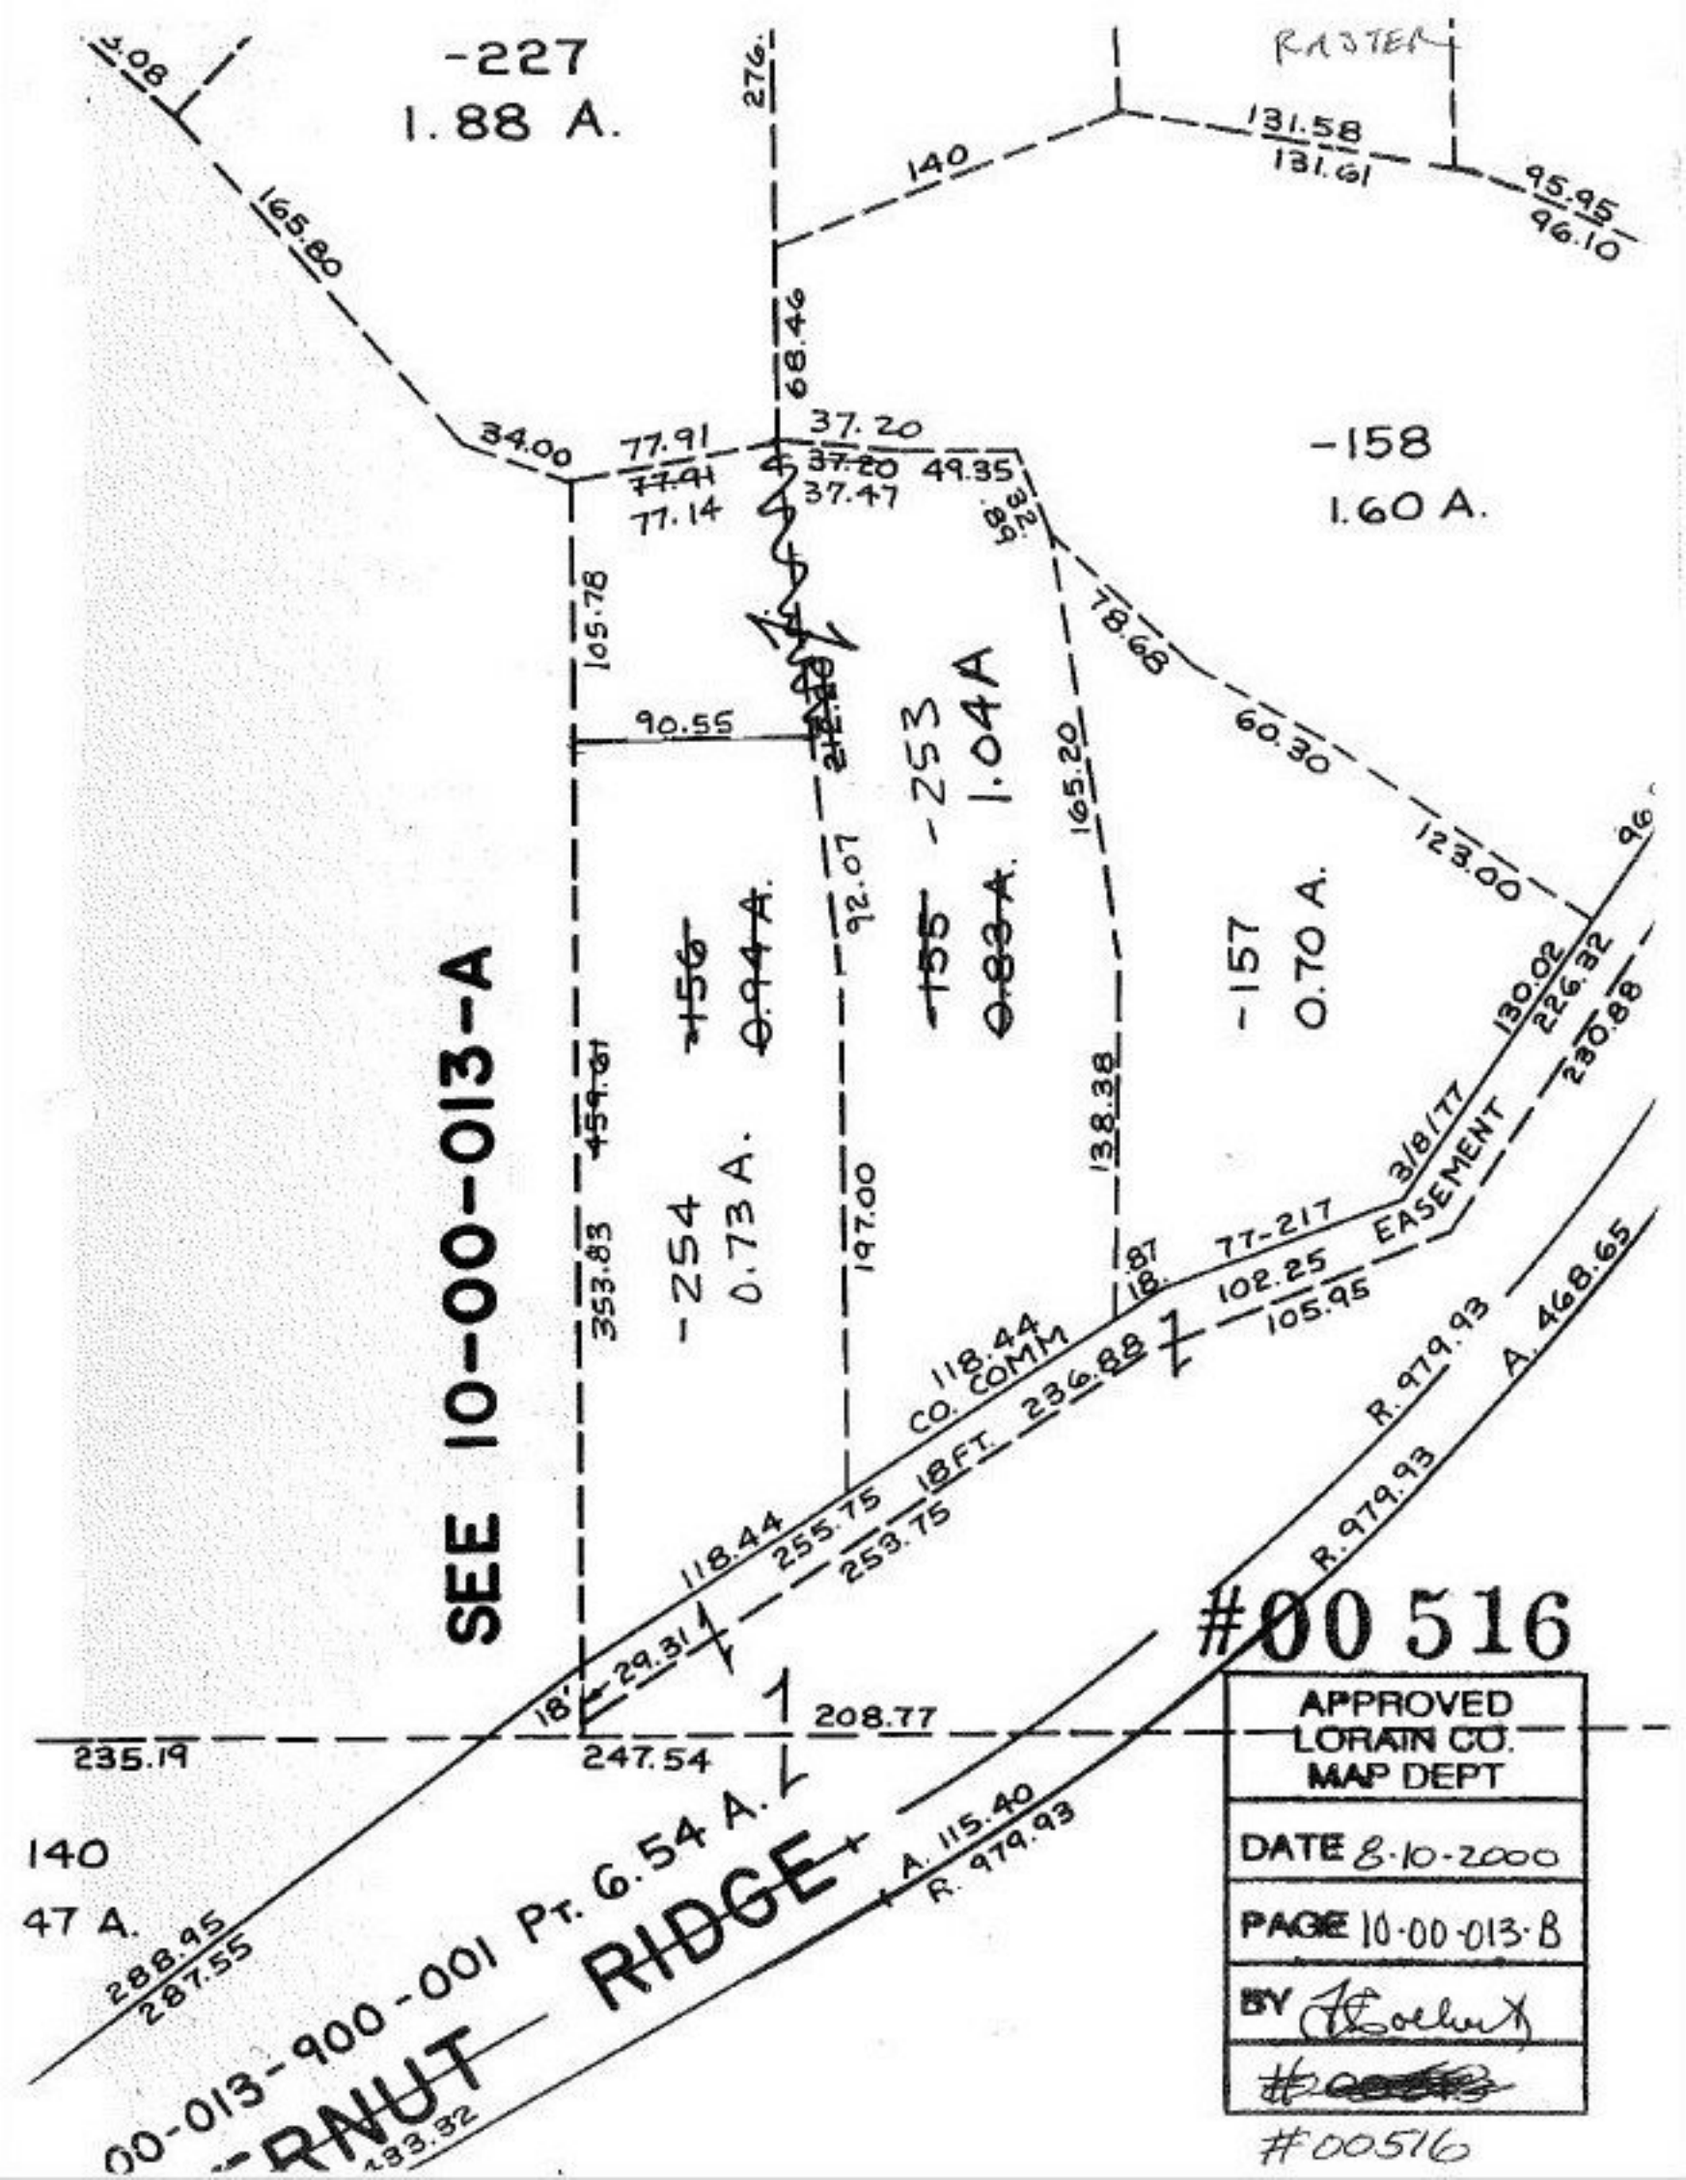

#00516

APPROVED LORAIN CO. MAP DEPT
DATE 8-10-2000
PAGE 10-00-013-B
BY
#00516

#00516