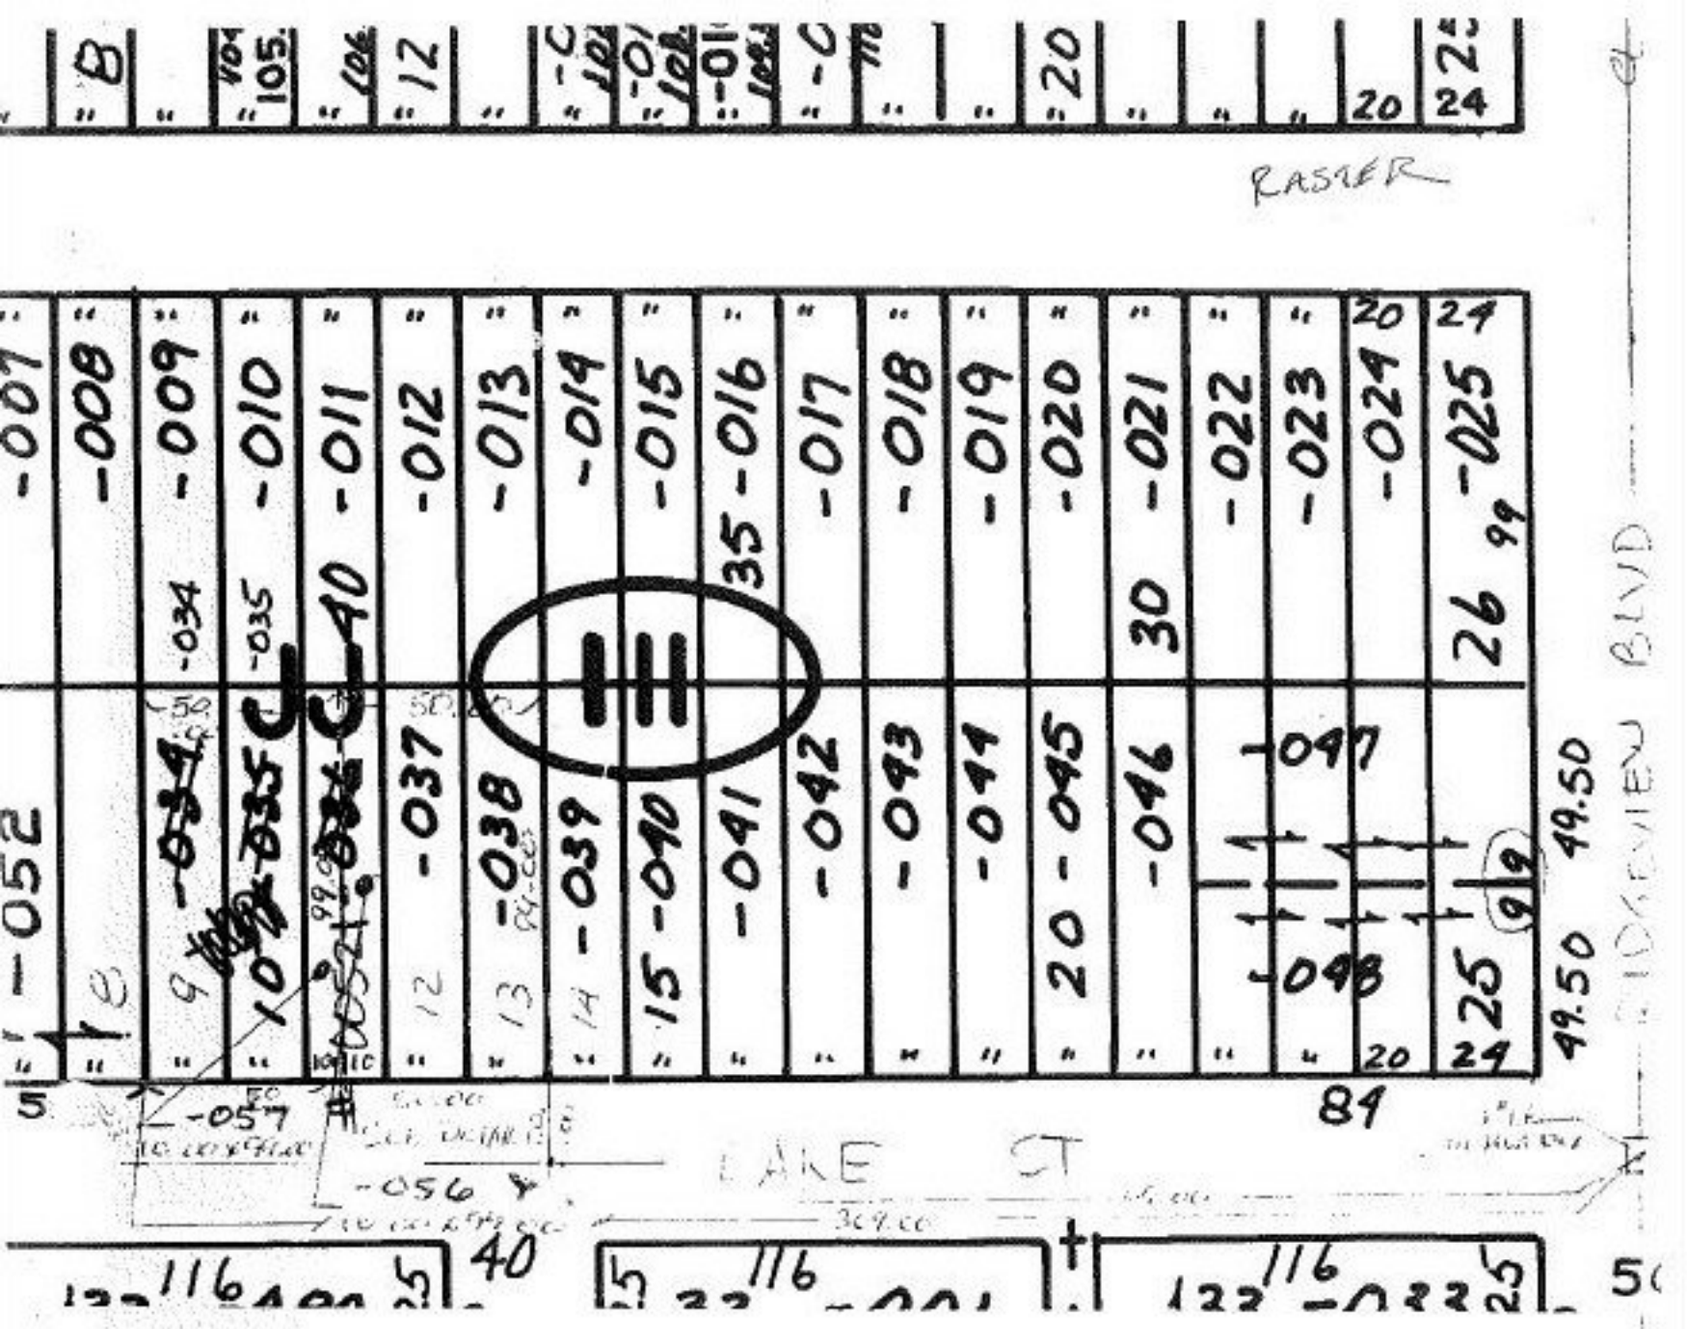

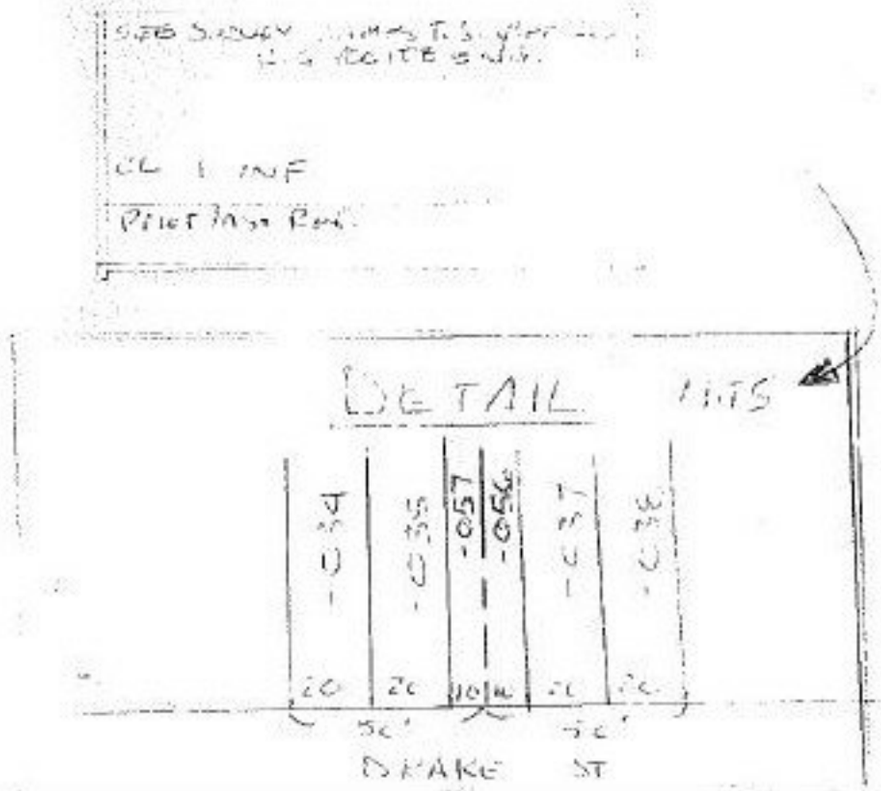

00521

APPROVED
LORAIN CO.
MAP DEPT

DATE 8-10-00

PAGE 7-00-UEC-B

BY T. McMahon